

UNITED STATES
DEPARTMENT OF THE INTERIOR
BUREAU OF LAND MANAGEMENT

SECTION


NE $\frac{1}{4}$ SW $\frac{1}{4}$

Oregon State Water Filings

SEC 27

TOWNSHIP 16 S, RANGE 27 E, W. M.

North

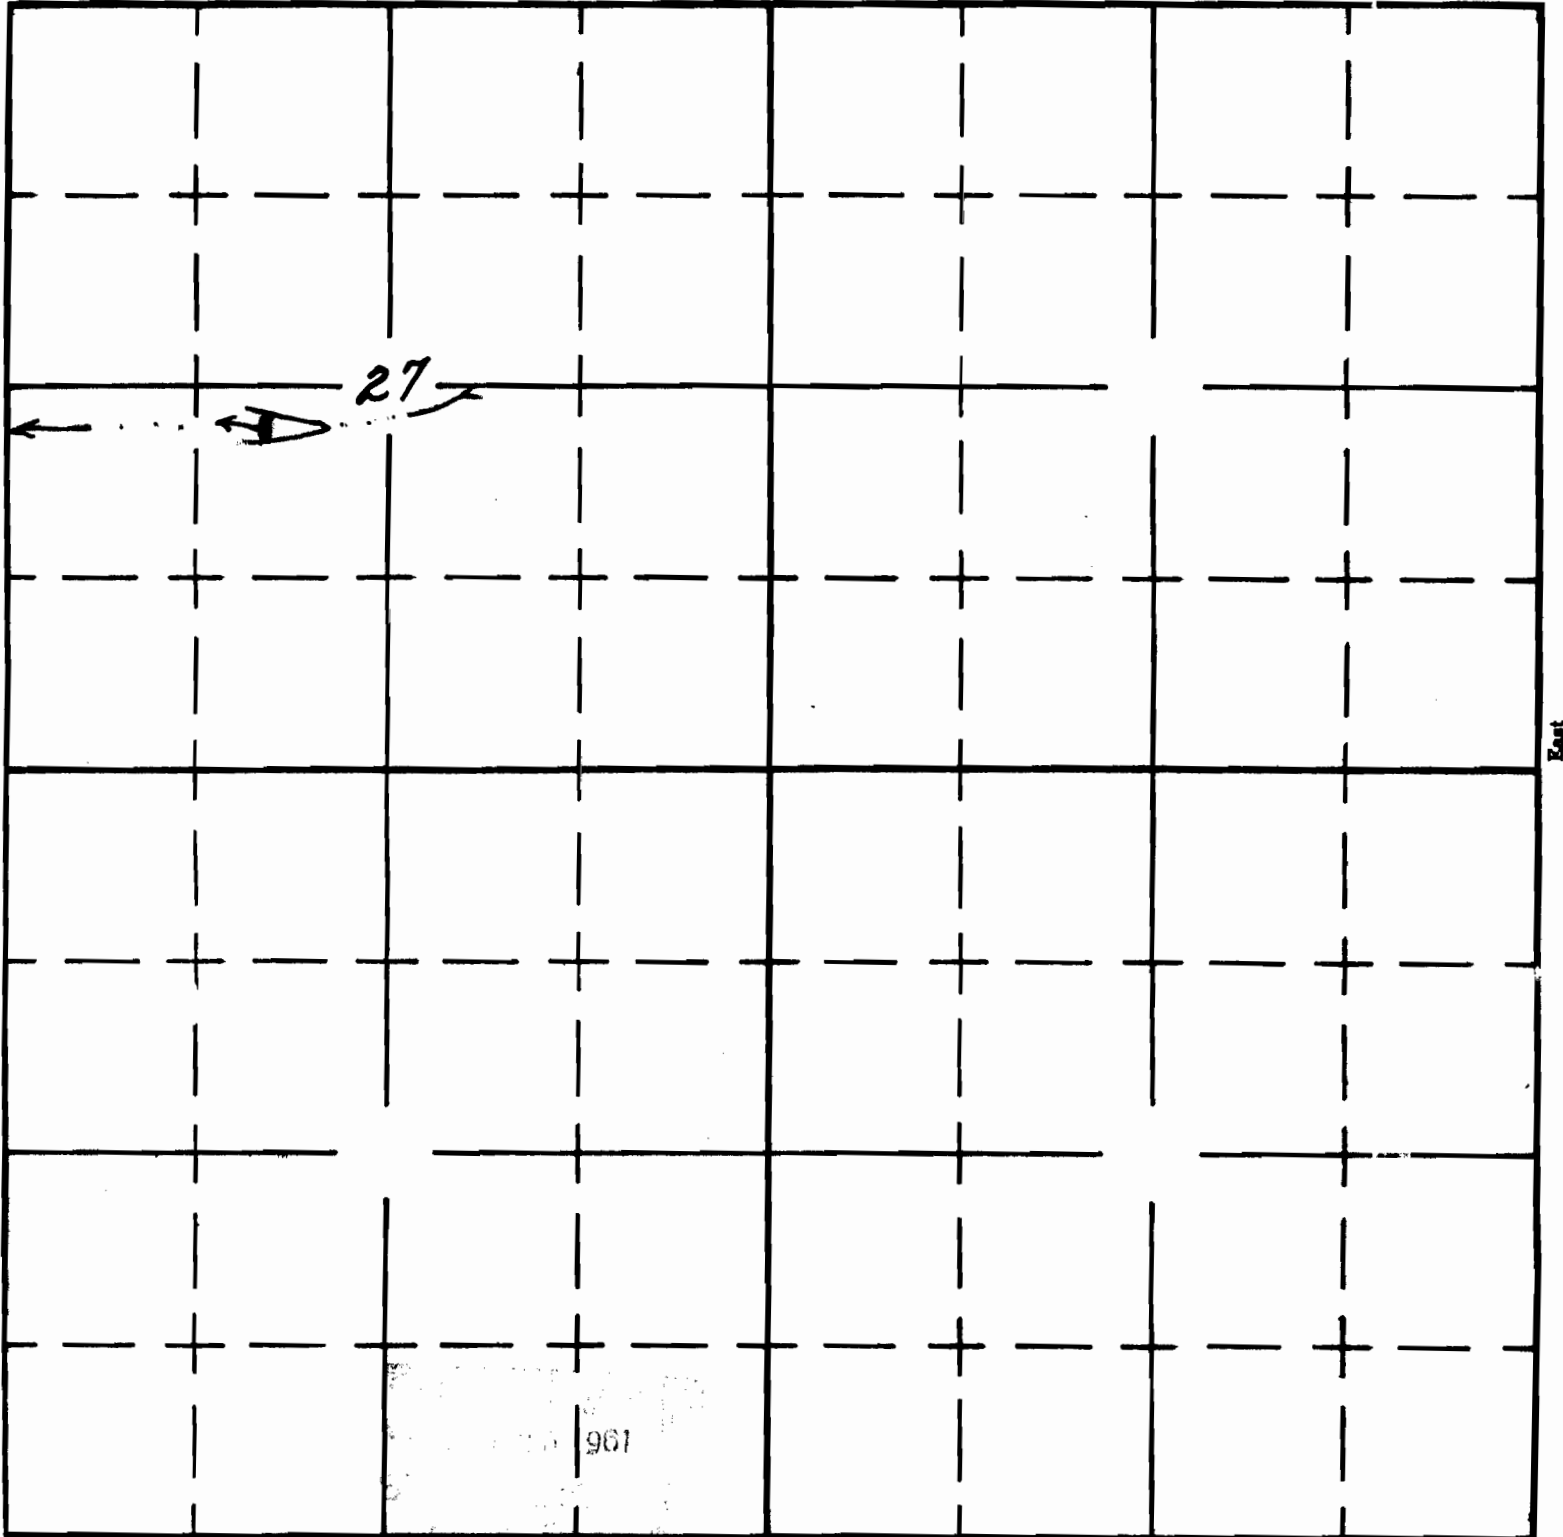

*Rever Co.
John Day River*

South

APPLICATION No **R-35478**

PERMIT No **R-3905**