

.87  
1961

UNITED STATES  
DEPARTMENT OF THE INTERIOR  
BUREAU OF LAND MANAGEMENT

RECEIVED

SEP 21 1987

SECTION


~~SW 1/4~~  
~~SW NW~~  
SEC ~~10~~ 10


TOWNSHIP 29S, RANGE 29 1/2 E, W. M.

WATER RESOURCES DEPT.  
SALEM, OREGON

North

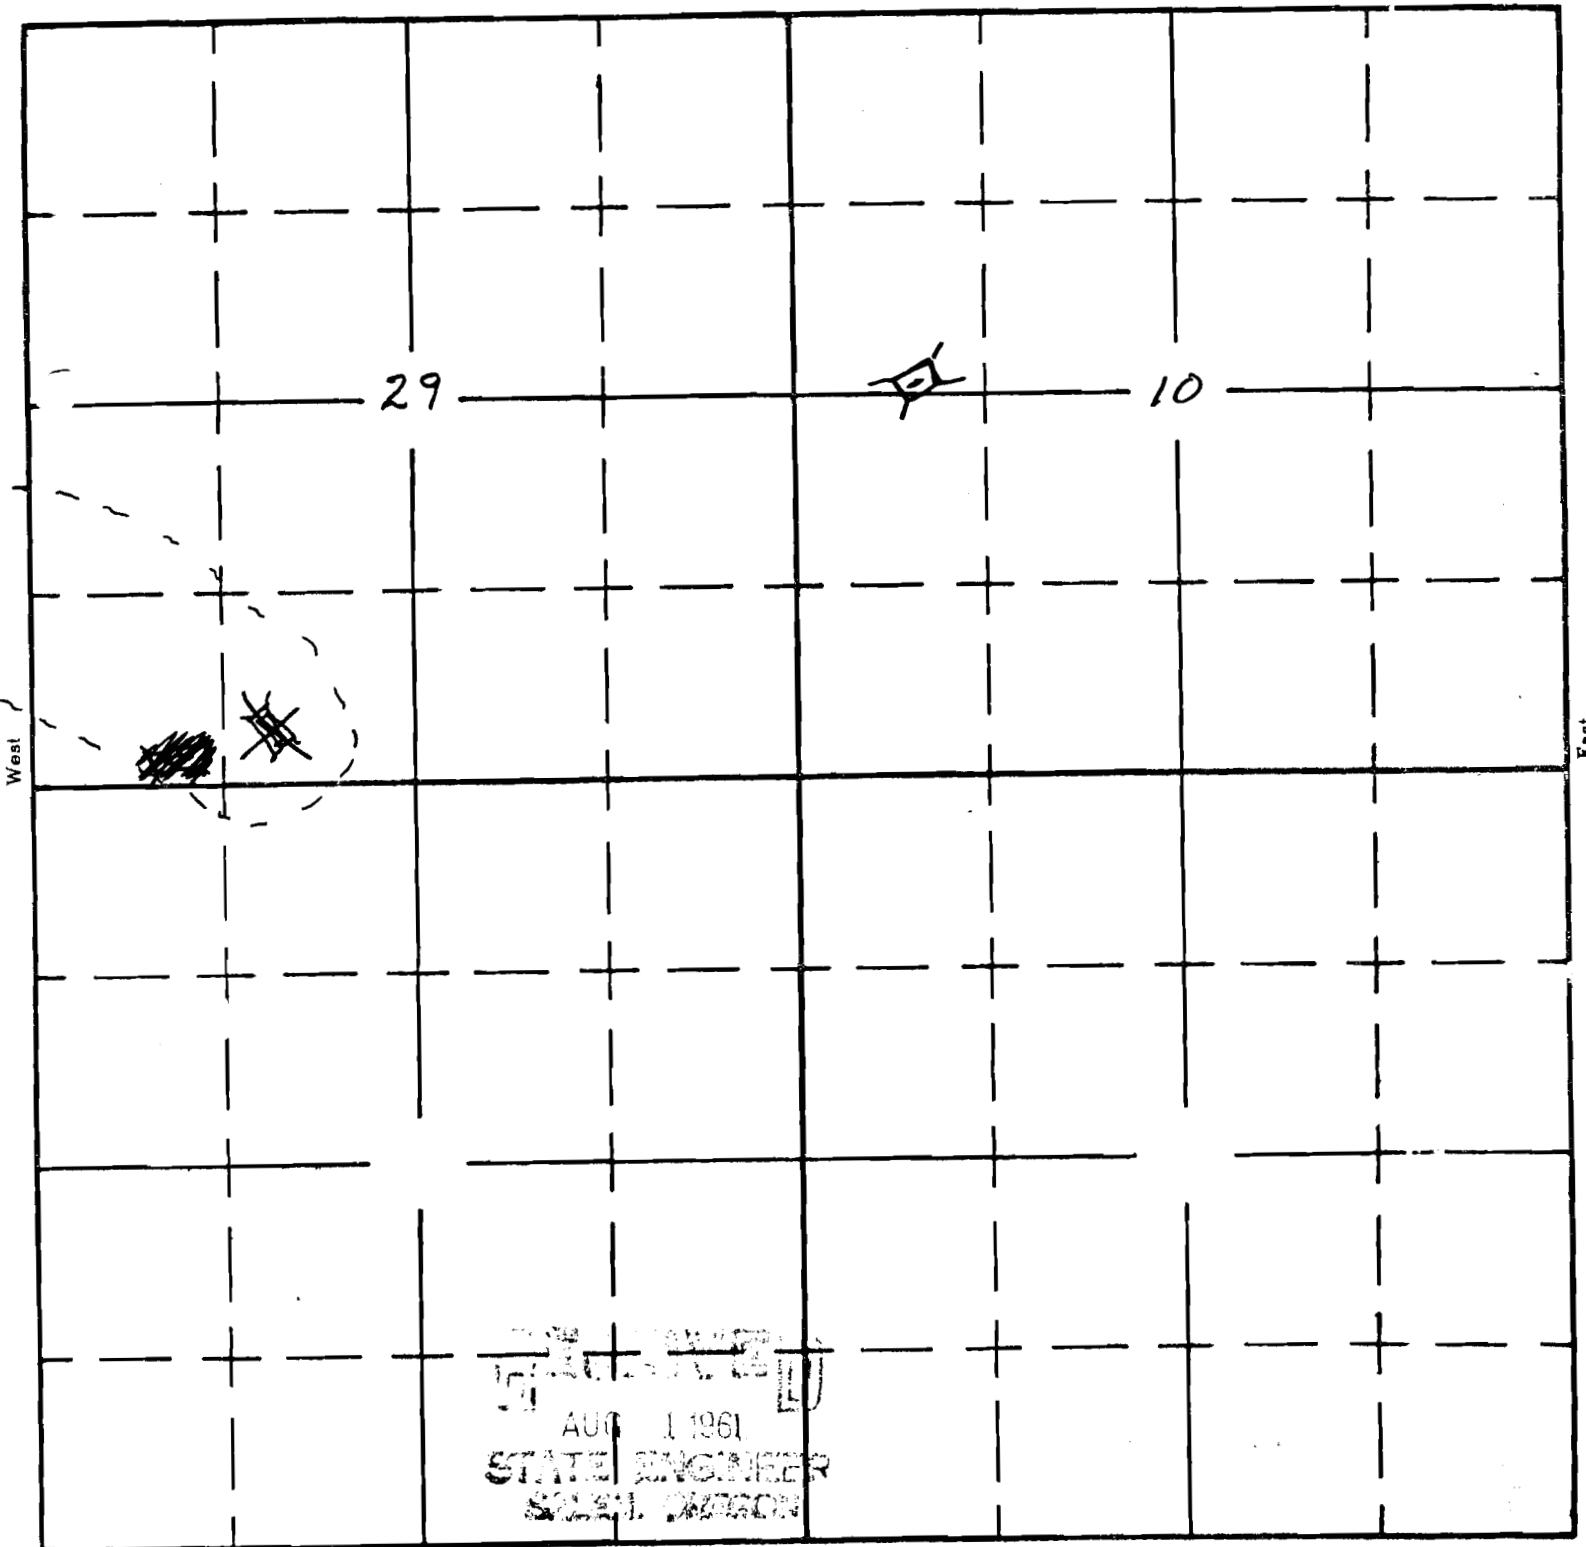

AUG 1 1961  
STATE ENGINEER  
SALEM, OREGON

South

APPLICATION No. R-35877  
0.3010