

Form AI-187
March 1961

UNITED STATES
DEPARTMENT OF THE INTERIOR
BUREAU OF LAND MANAGEMENT

SECTION


NW 1/4 SW 1/4

Oregon State Water Filings

SEC. 30

TOWNSHIP 23 S, RANGE 29 E, W. M.

North

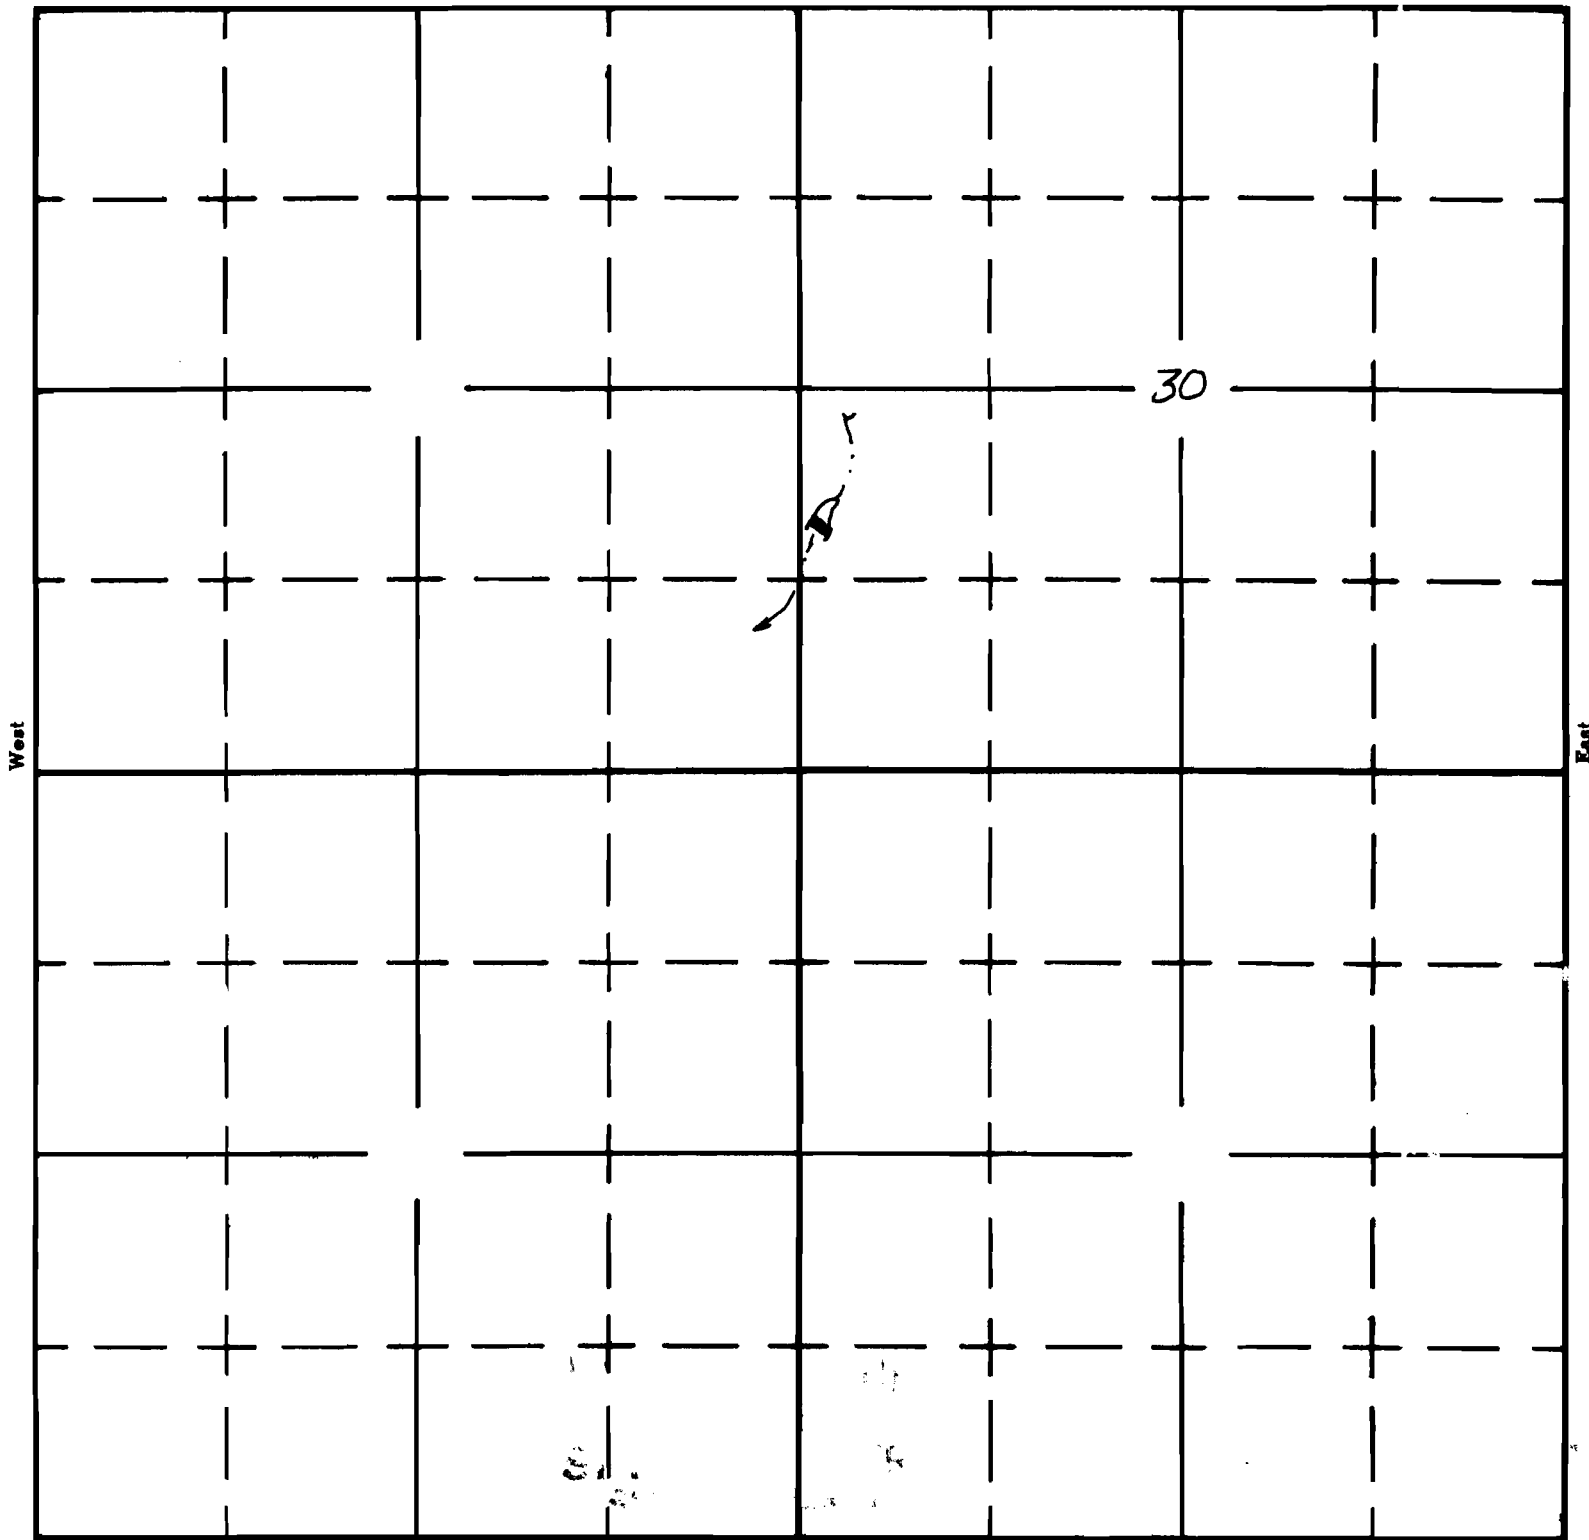

South

APPLICATION No. R-35635

PERMIT No. R-4023