

Form A1-187
March 1961

UNITED STATES
DEPARTMENT OF THE INTERIOR
BUREAU OF LAND MANAGEMENT

SECTION


S $\frac{1}{2}$ NW $\frac{1}{4}$

Oregon State Water Filings

SEC. 14

TOWNSHIP 23 S, RANGE 28 E, W. M.

North

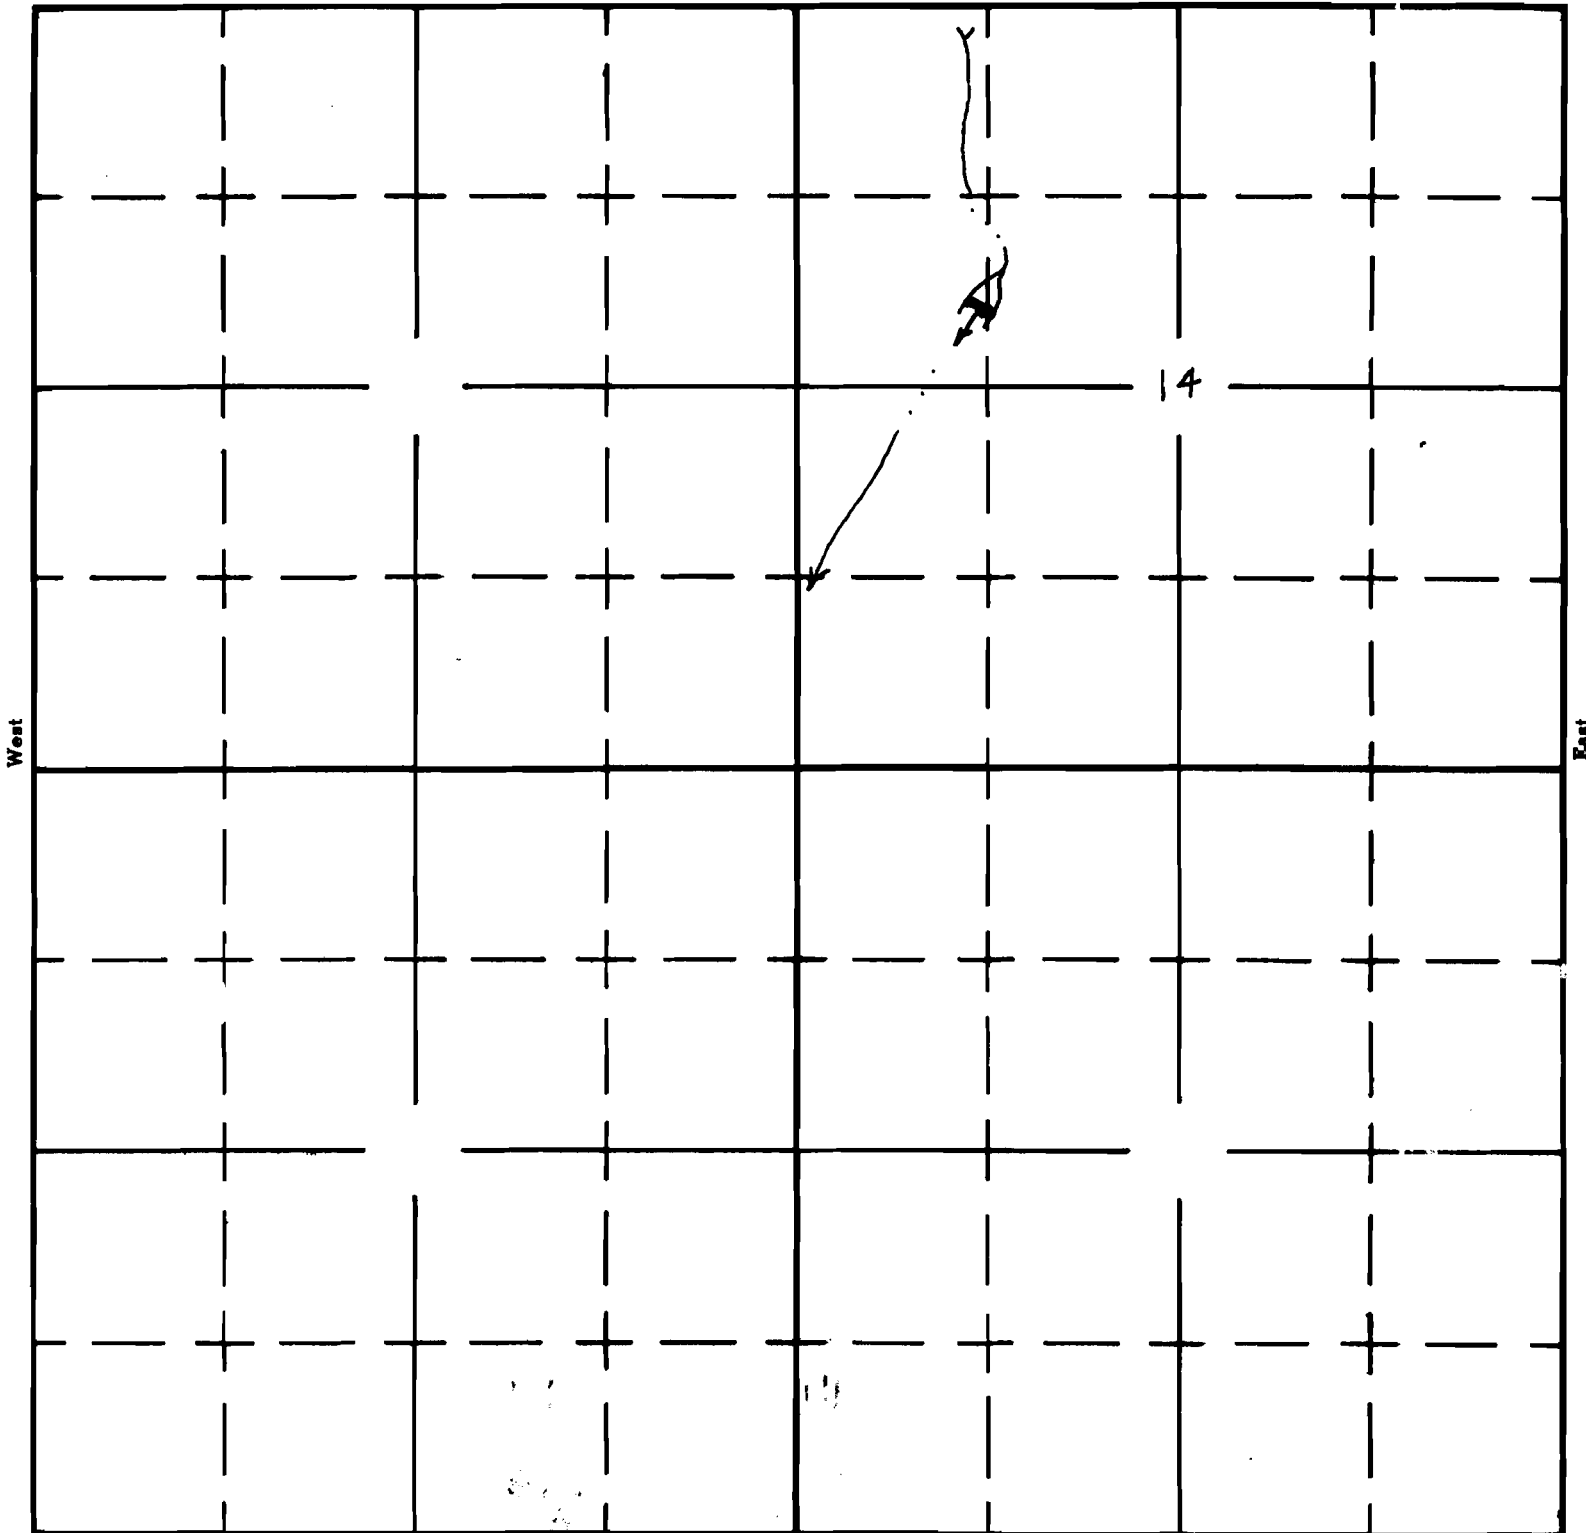

South

APPLICATION No. R-35644

PERMIT No. R-4025