

Form AI-187
March 1961

UNITED STATES
DEPARTMENT OF THE INTERIOR
BUREAU OF LAND MANAGEMENT

SECTION


SW $\frac{1}{4}$ NW $\frac{1}{4}$

Oregon State Water Filings

SEC 7

TOWNSHIP 23 S, RANGE 29 E, W. M.

North

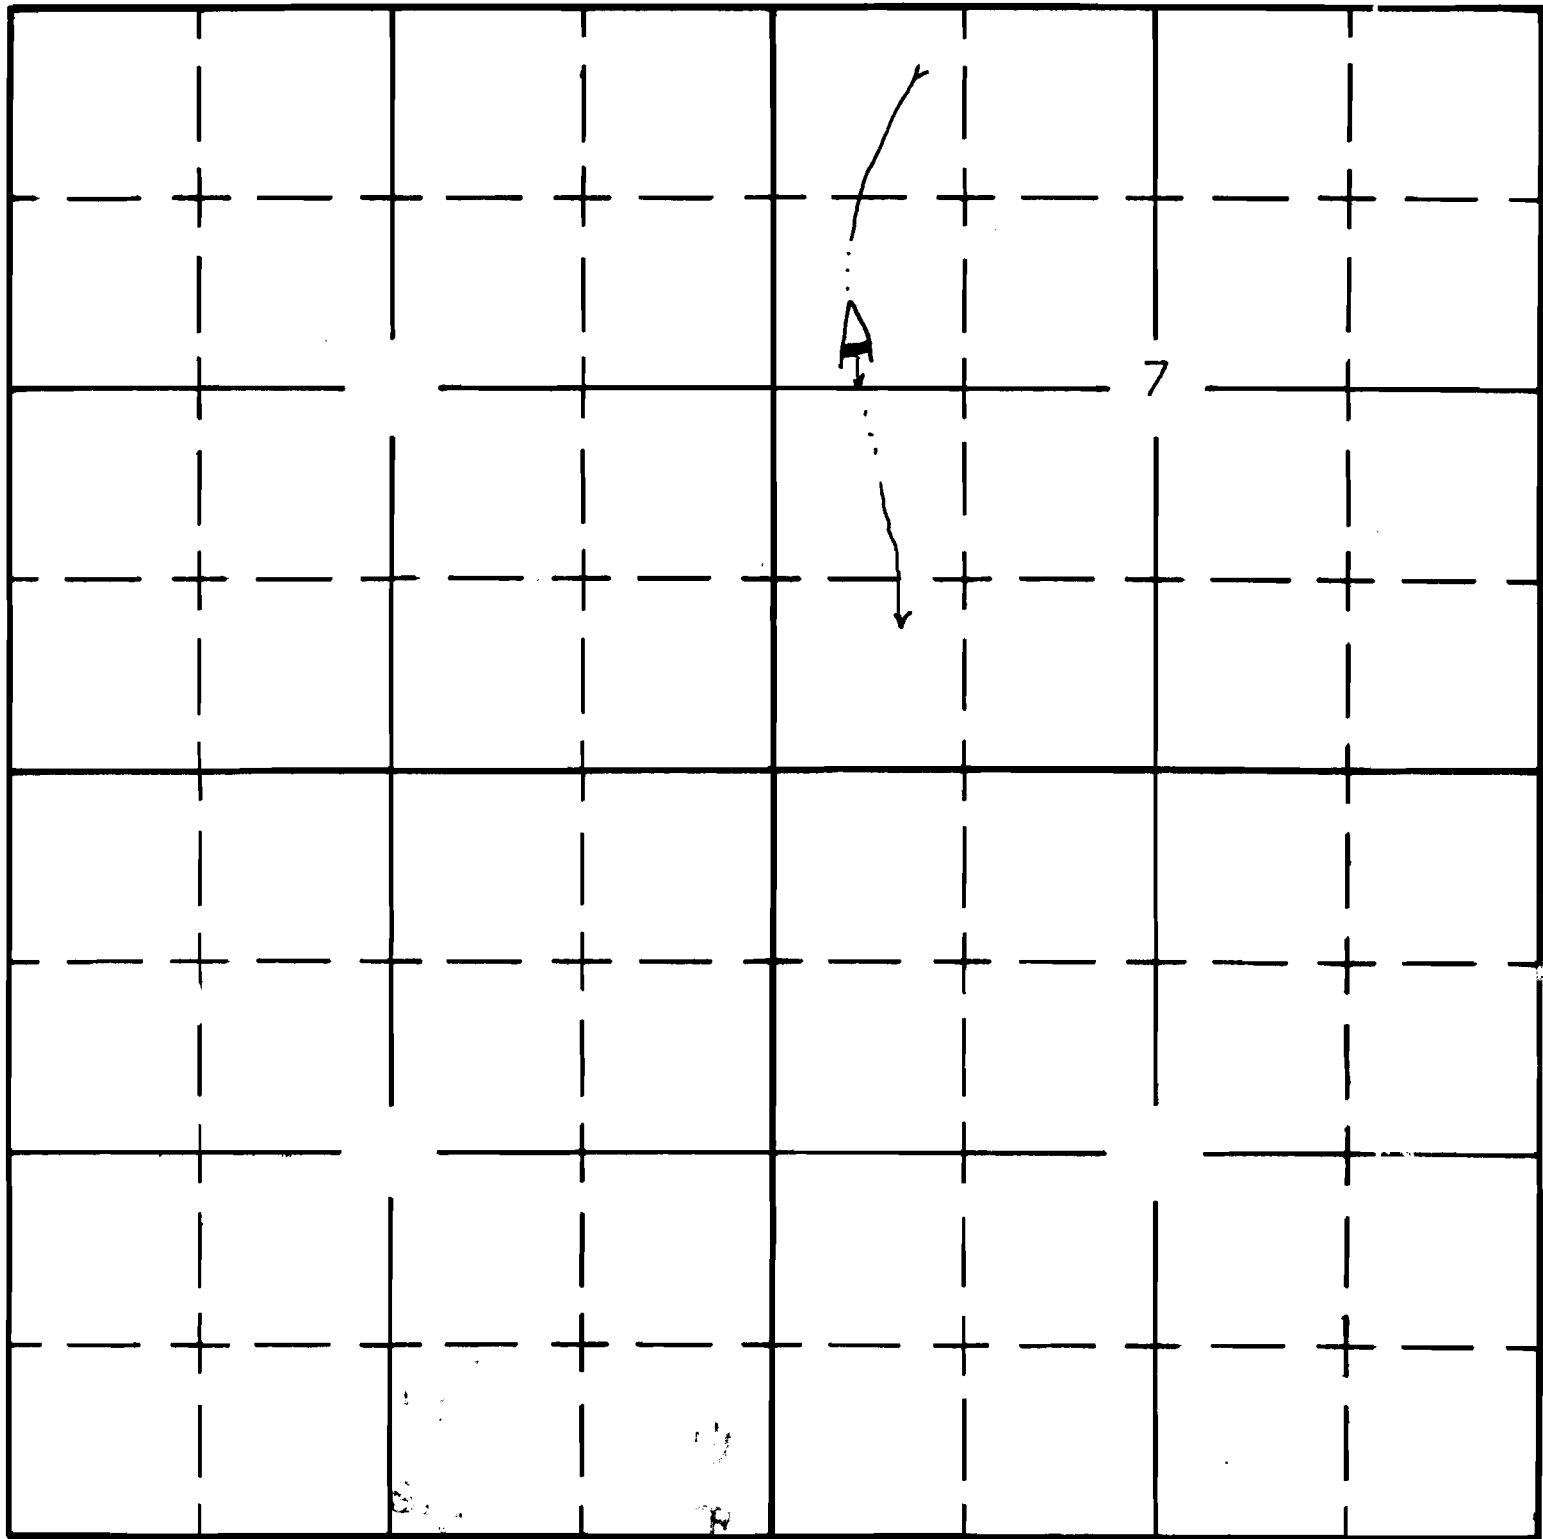

South

APPLICATION No. R-35647

PERMIT No. R-4028