

Form A1-187
March 1961

UNITED STATES
DEPARTMENT OF THE INTERIOR
BUREAU OF LAND MANAGEMENT

SECTION


SE 1/4 SE 1/4

SEC 17

Oregon State Water Filings

TOWNSHIP 38 S, RANGE 33 E, W. M.

North

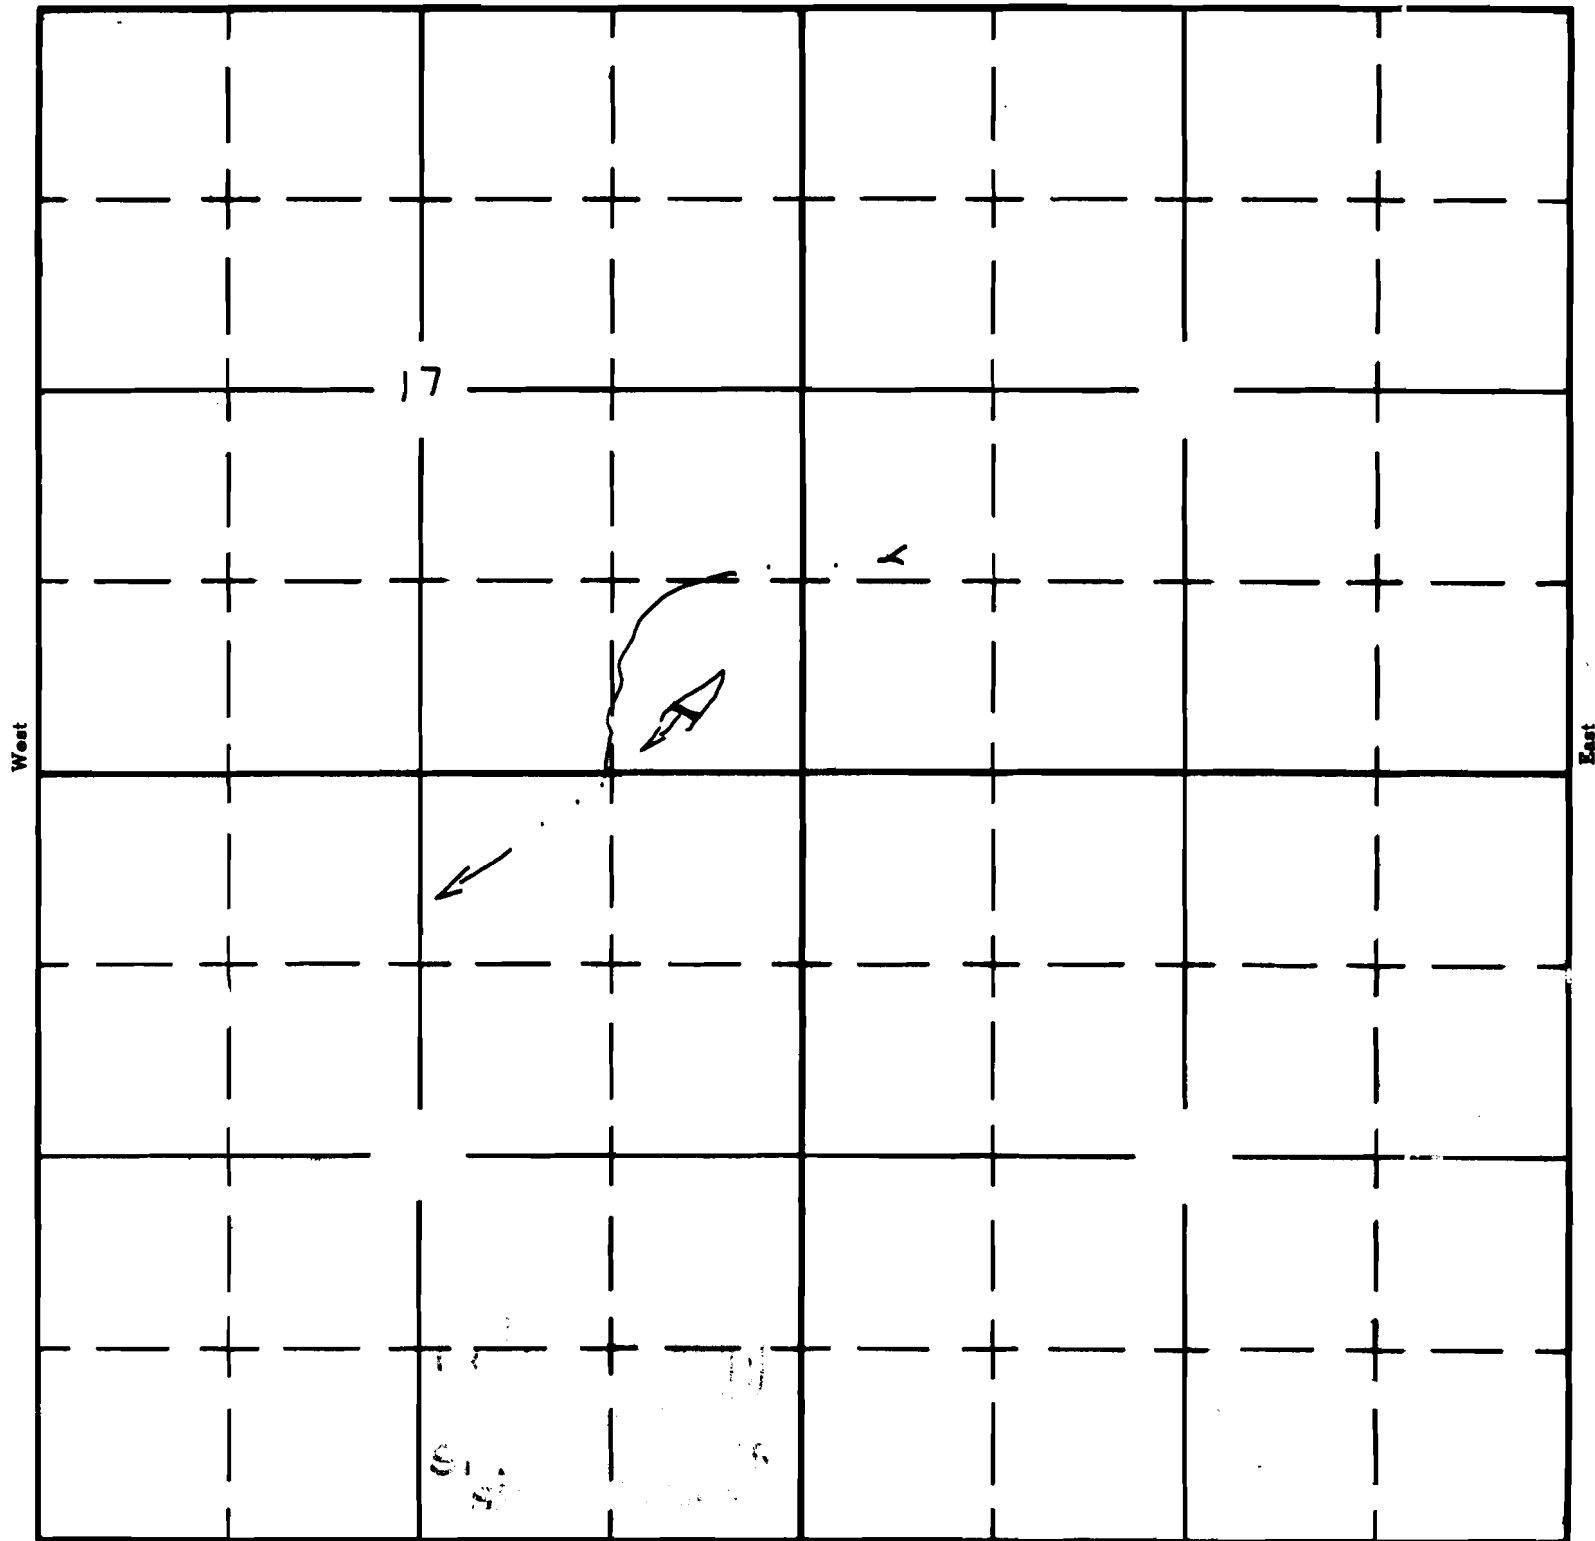

South

APPLICATION No. R-35669
PERMIT No. R-4032