

Form AI-187
March 1961

UNITED STATES
DEPARTMENT OF THE INTERIOR
BUREAU OF LAND MANAGEMENT

SECTION


NW 1/4 NE 1/4

Oregon State Water Filings

8

TOWNSHIP 22S, RANGE 29E, W. M.

North

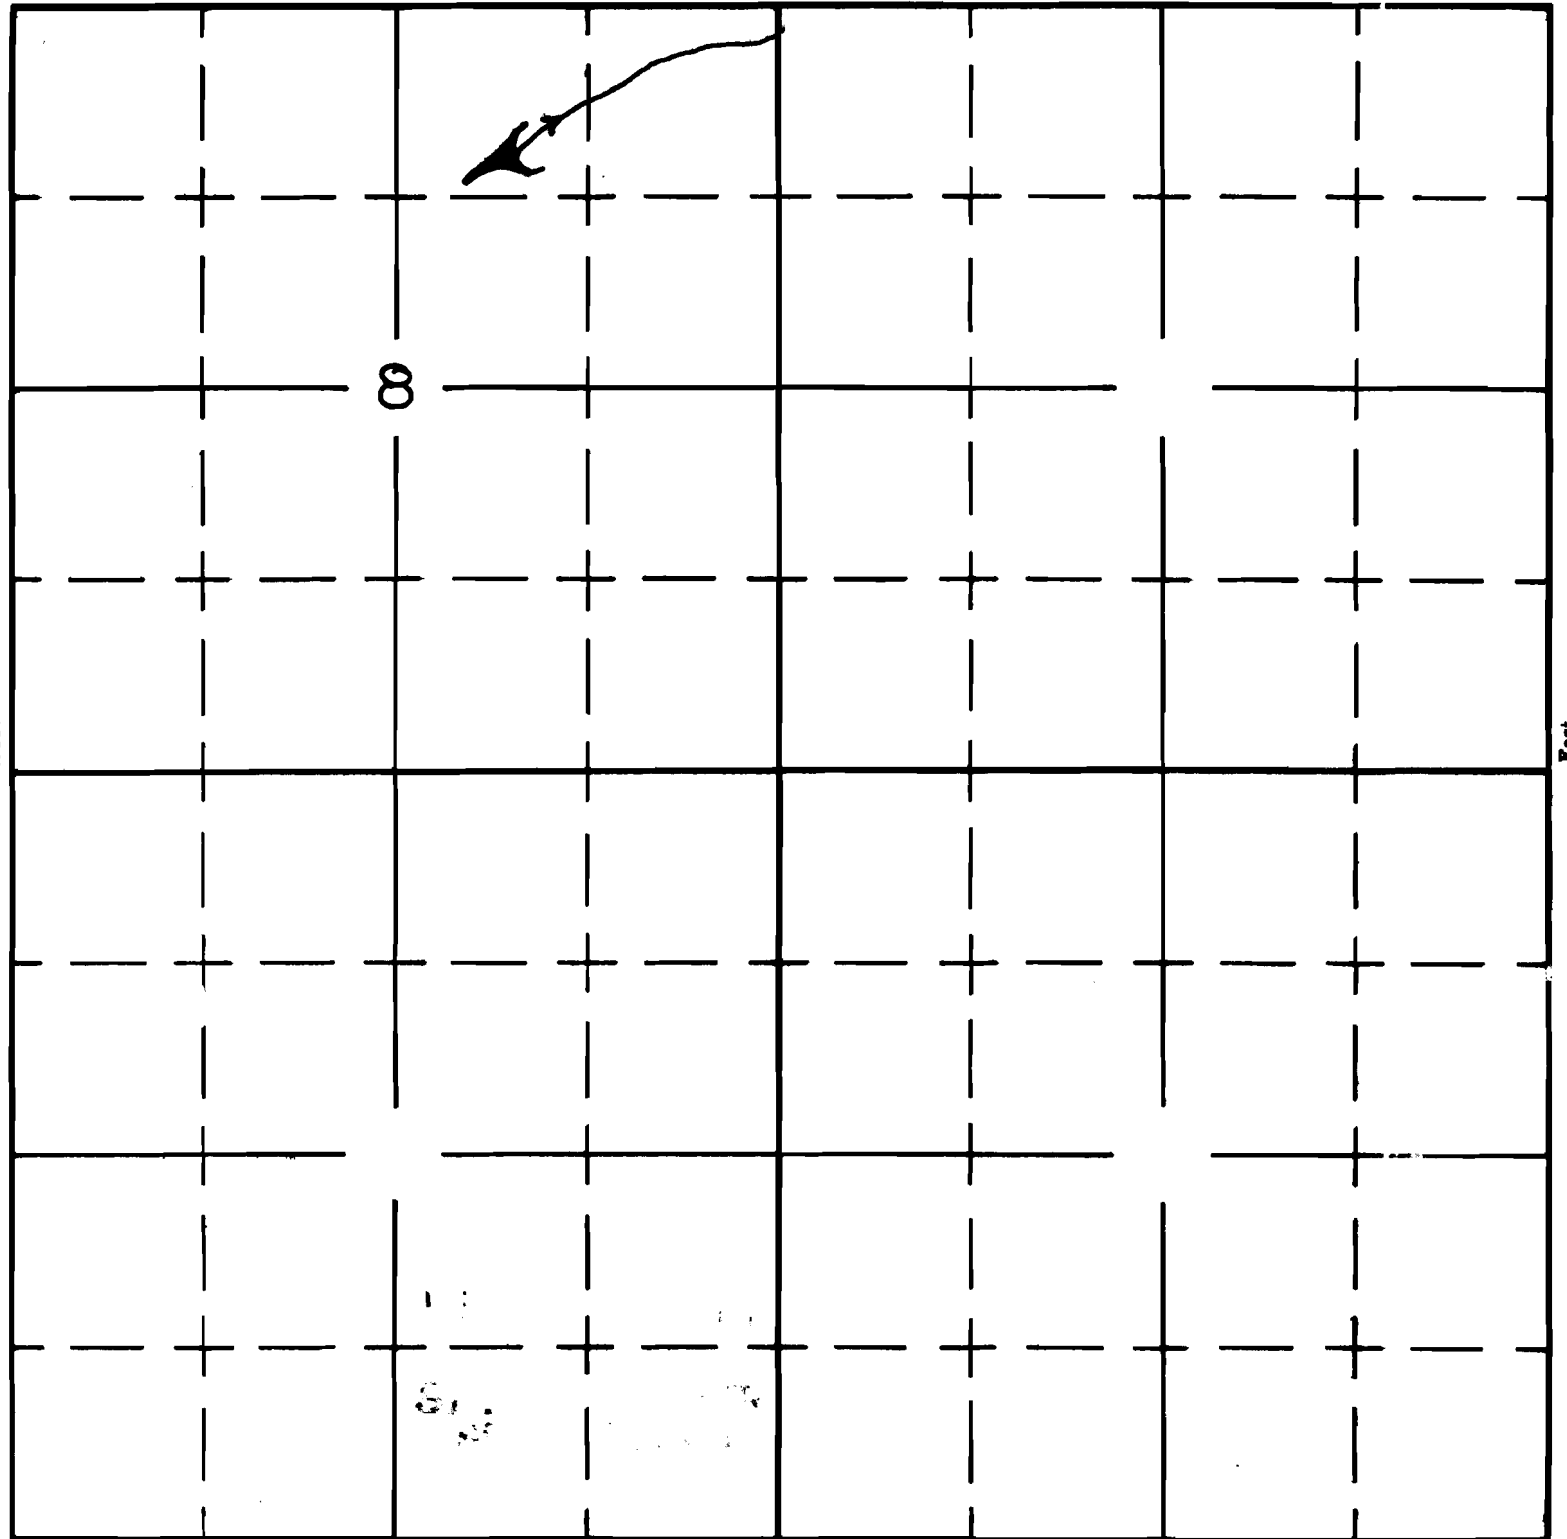

South

APPLICATION No. R-35698
PERMIT No. R-4047