

Form A1-187
March 1961

UNITED STATES
DEPARTMENT OF THE INTERIOR
BUREAU OF LAND MANAGEMENT

SECTION


SW $\frac{1}{4}$ SW $\frac{1}{4}$

Oregon State Water Filings

SEC 6

TOWNSHIP 28 S, RANGE 27 E, W. M.

North

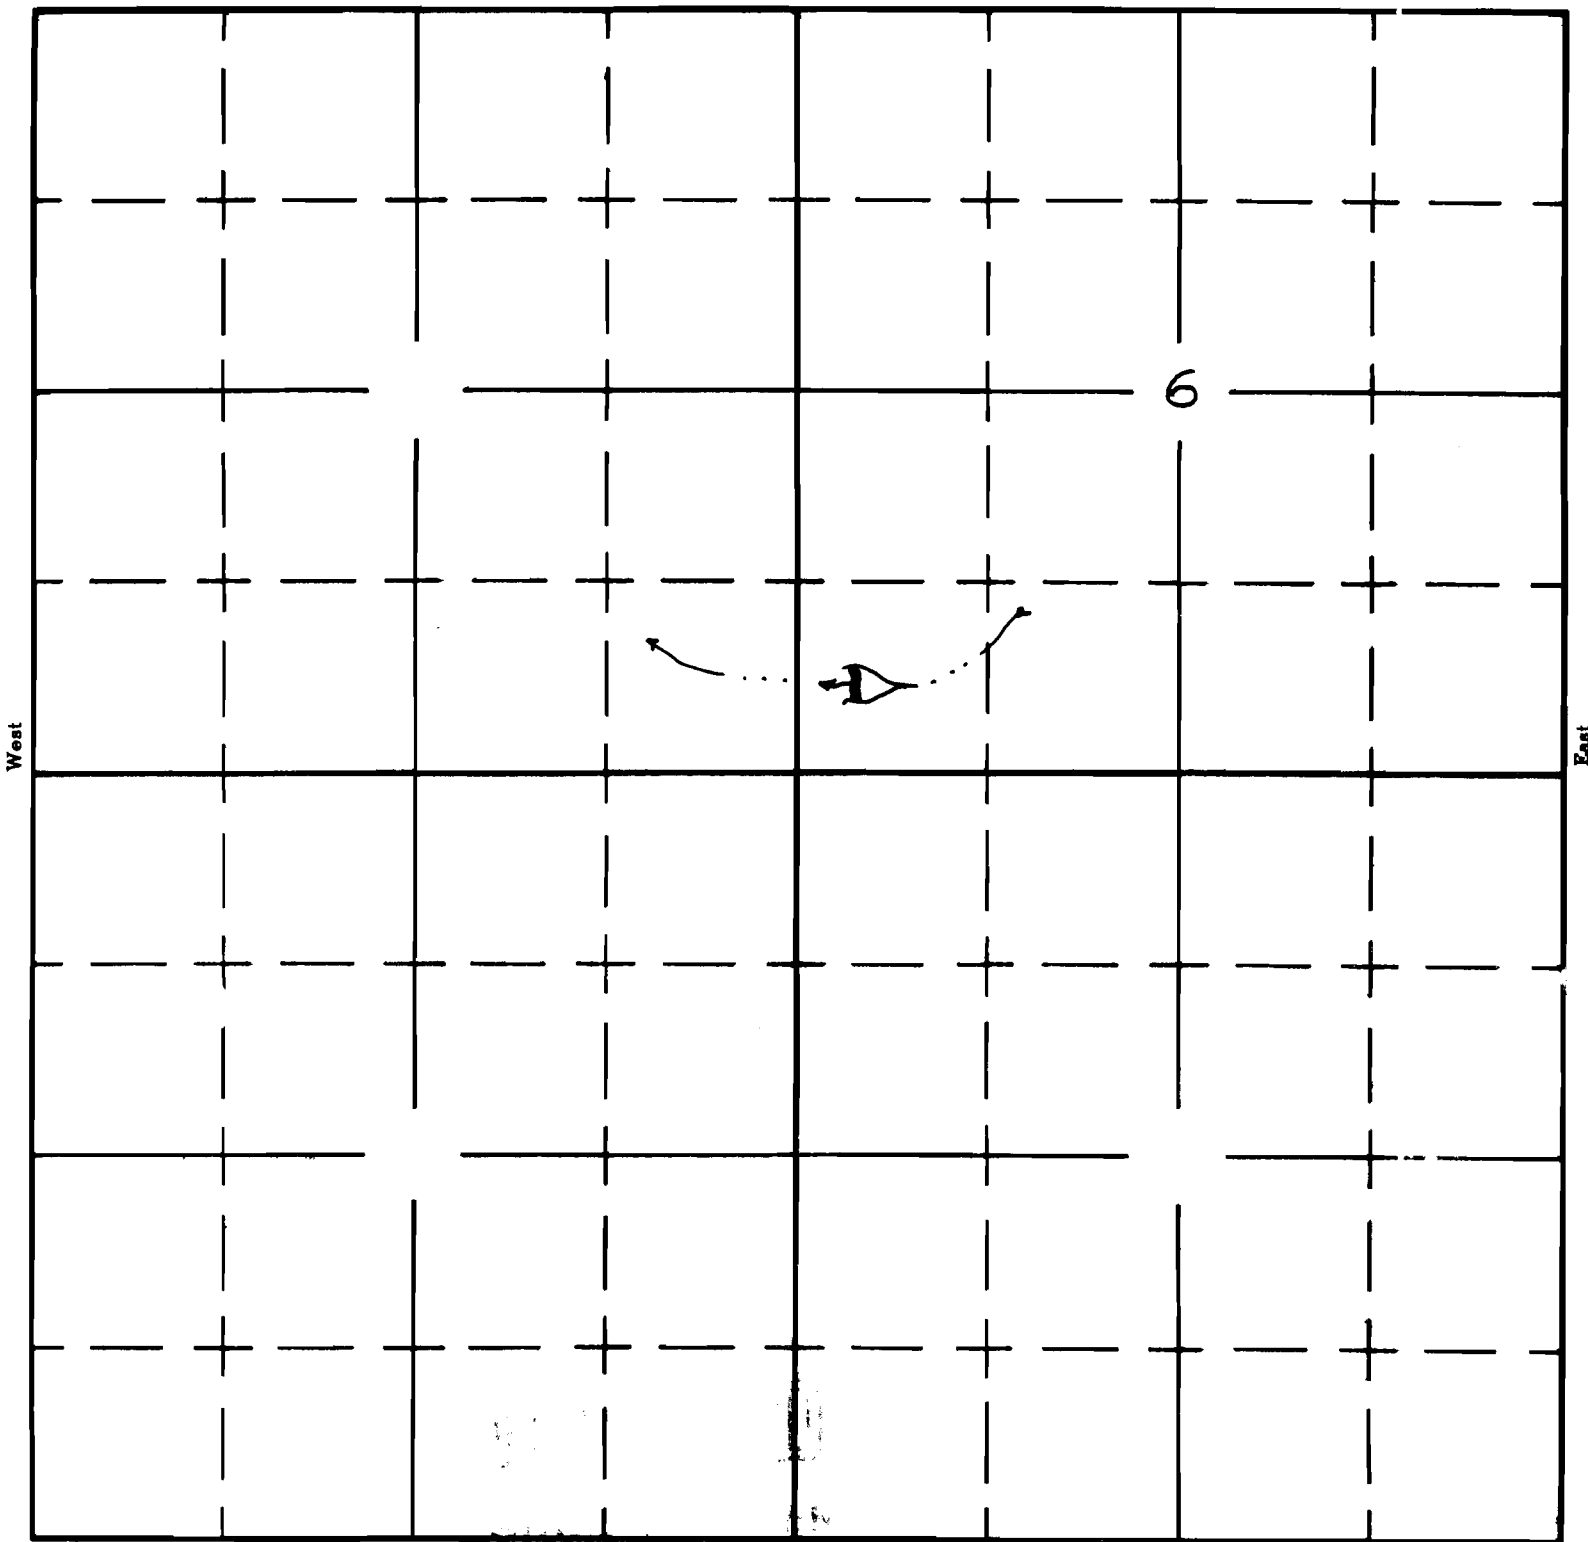

South

APPLICATION No. R-35605

PERMIT No. R-4186