

UNITED STATES
DEPARTMENT OF THE INTERIOR
BUREAU OF LAND MANAGEMENT

SECTION


SE 1/4 SE 1/4

Oregon State Water Filings

8

TOWNSHIP 23S, RANGE 29E, W. M.

North

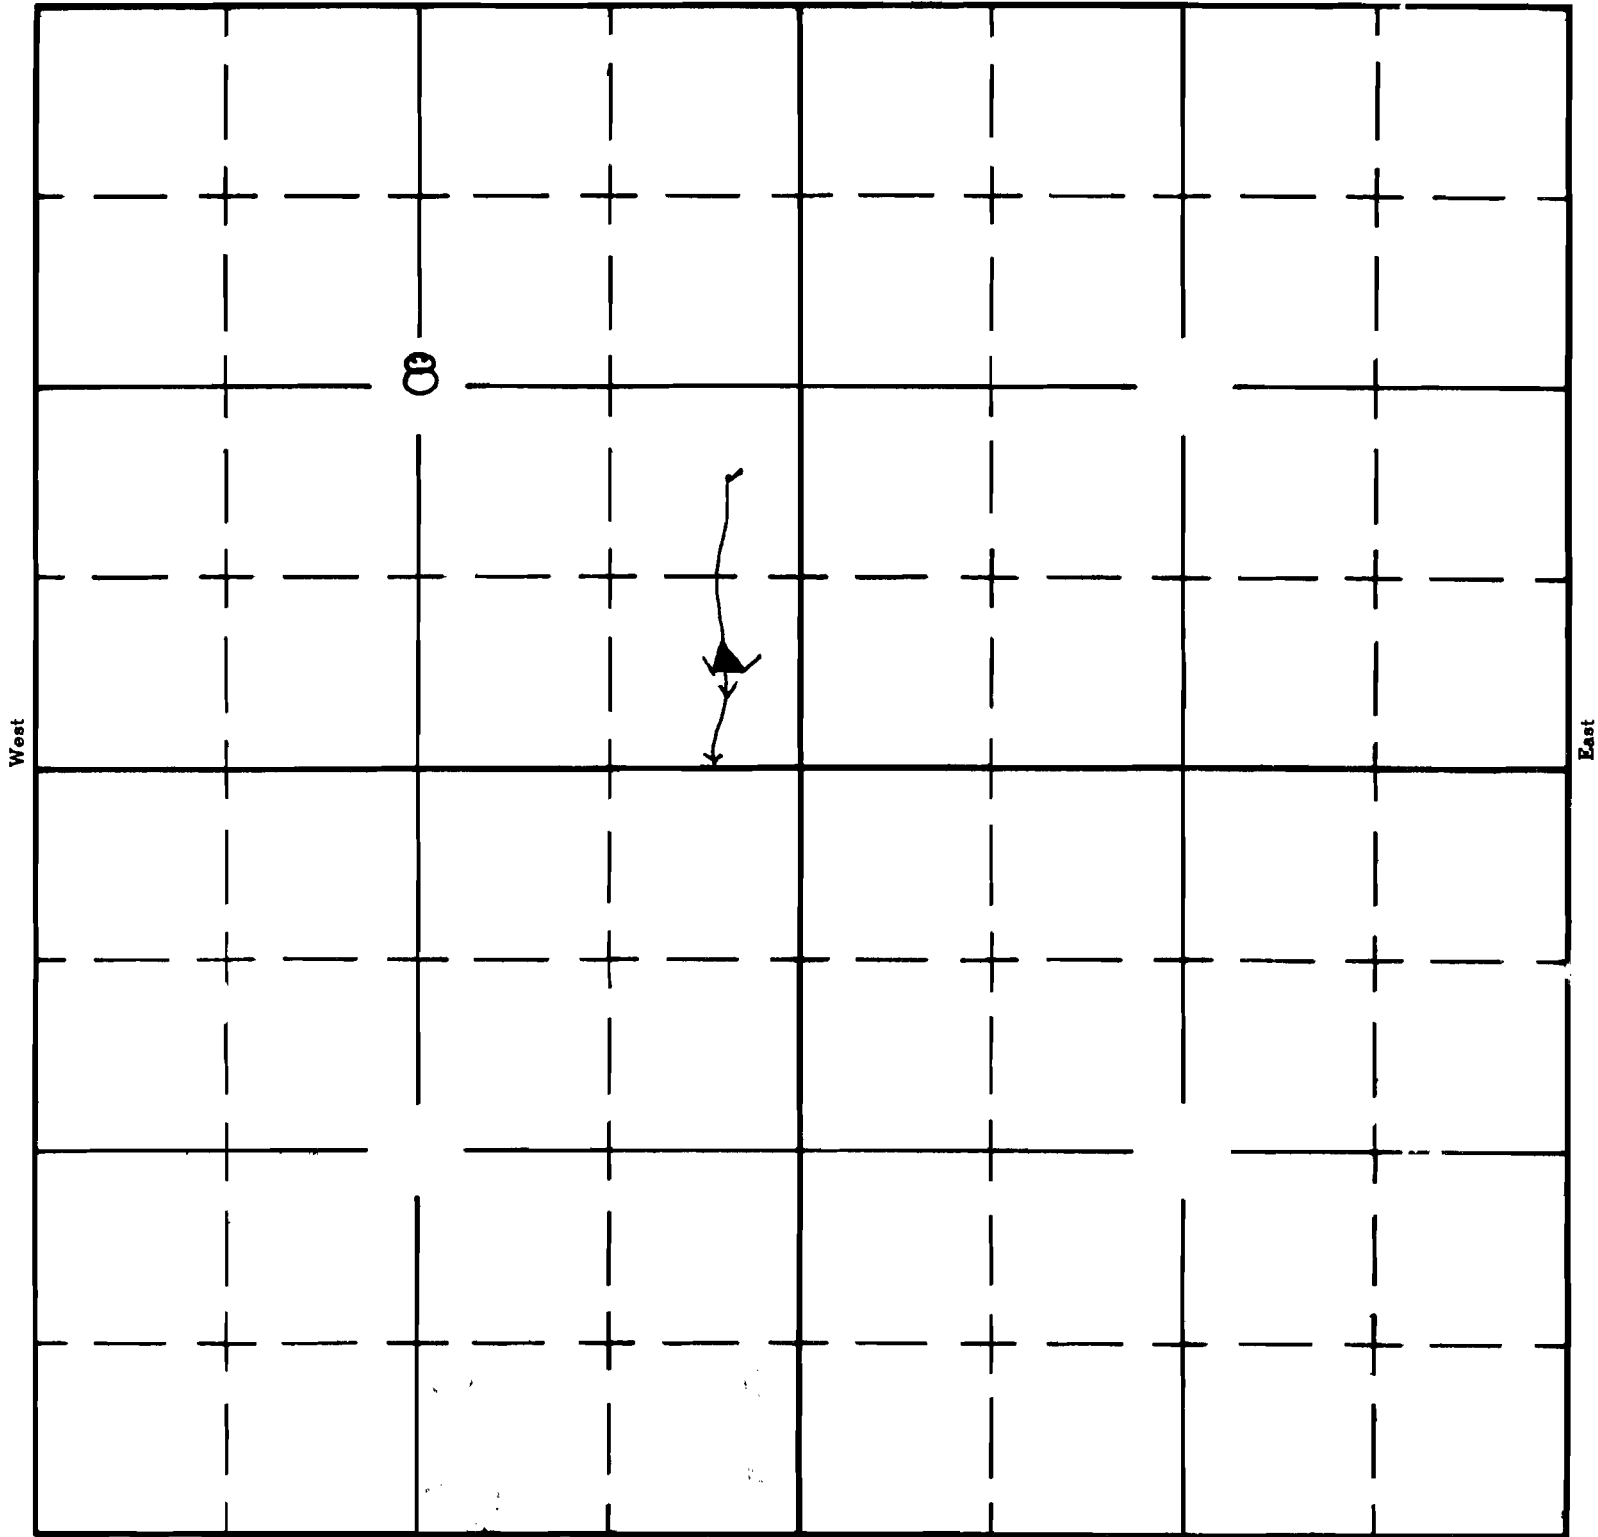

South

APPLICATION No. R 35618
PERMIT No. R 4188