

Form A1-187
March 1961


UNITED STATES
DEPARTMENT OF THE INTERIOR
BUREAU OF LAND MANAGEMENT

SECTION

NW 1/4 SE 1/4 **Oregon State Water Filings**

31 TOWNSHIP 23S, RANGE 29E, W. M.

North

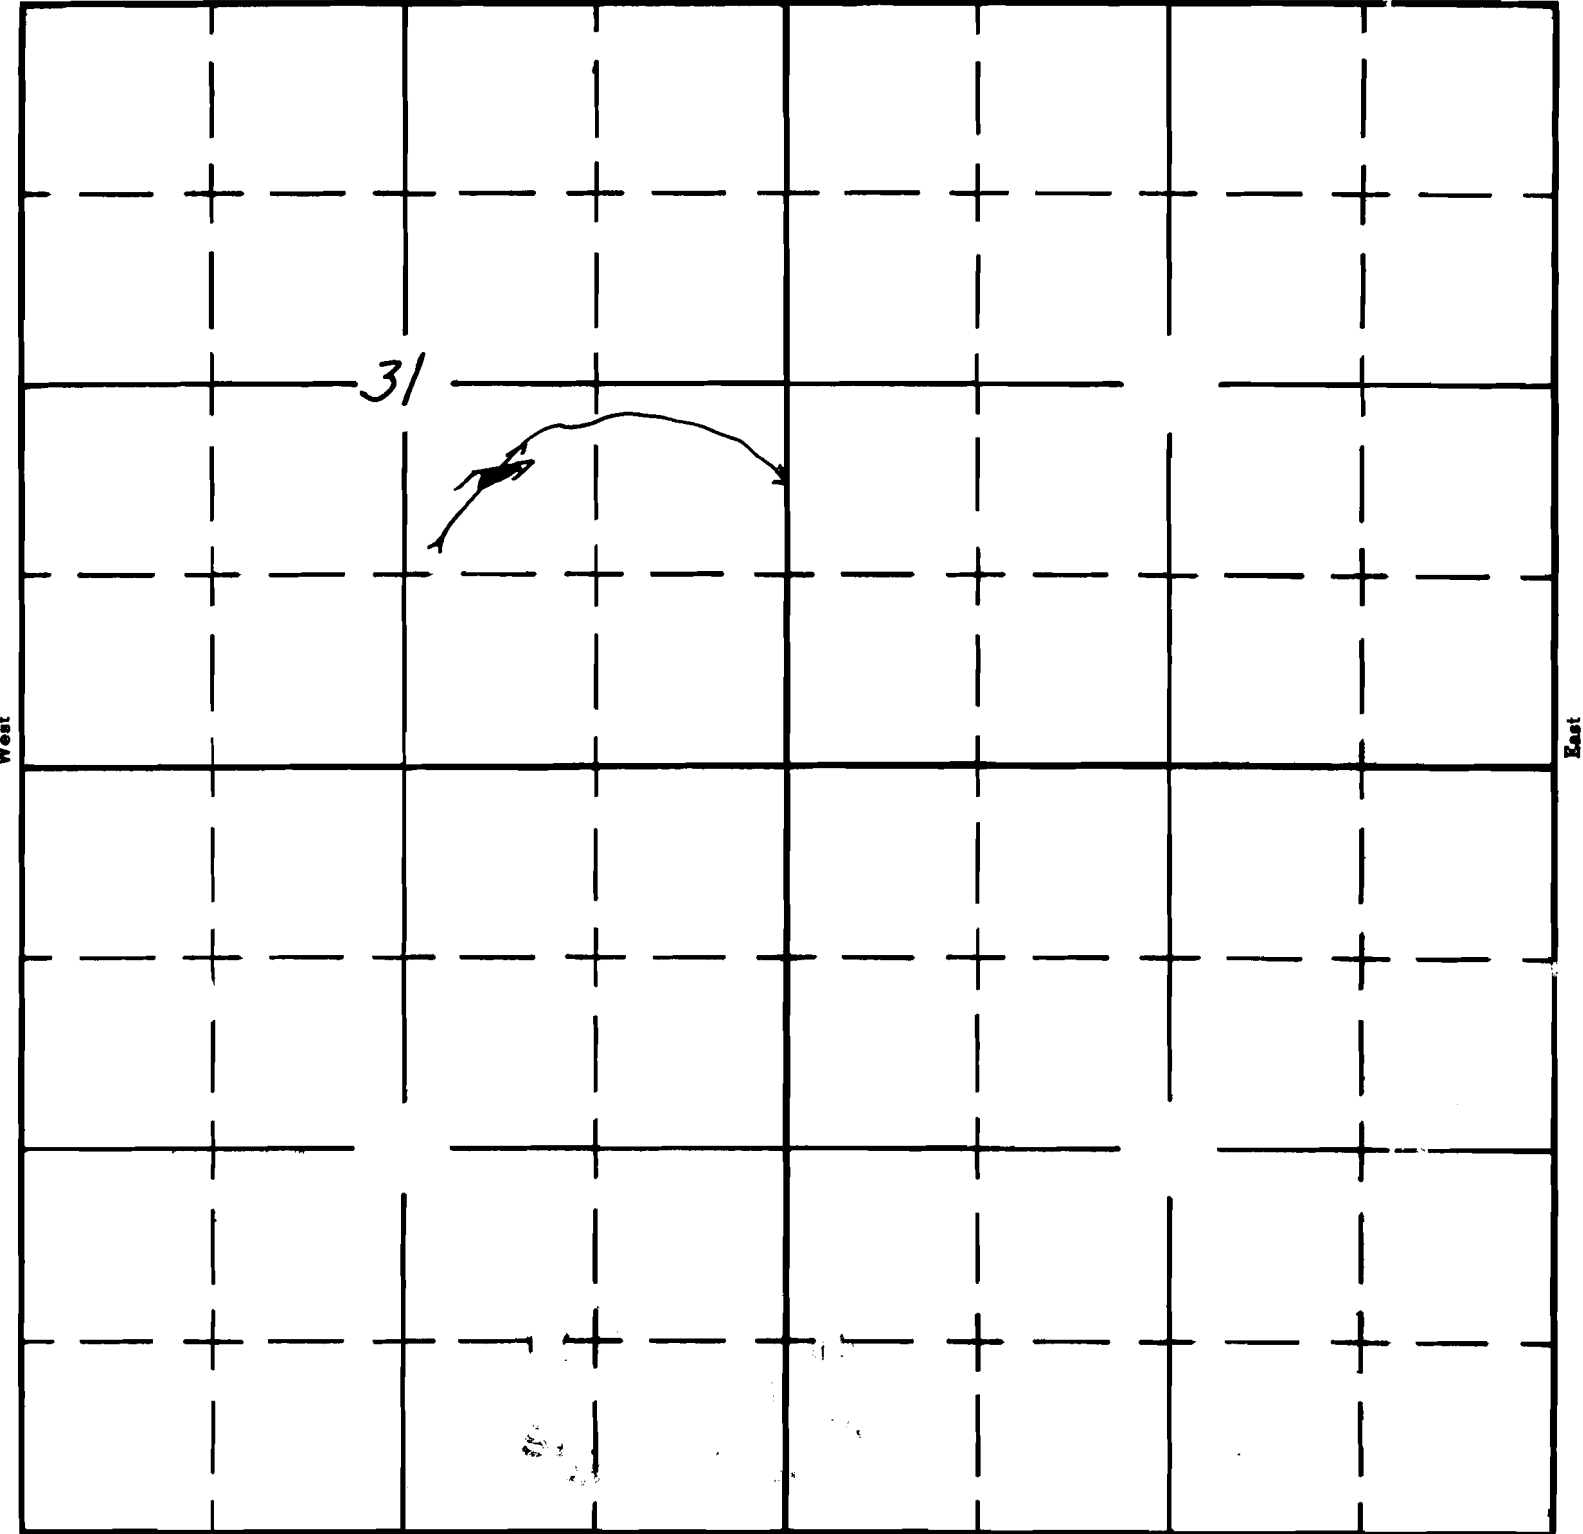

South

APPLICATION No. R-35620

PERMIT No. R-4189