

Form AI-187
March 1961


UNITED STATES
DEPARTMENT OF THE INTERIOR
BUREAU OF LAND MANAGEMENT

SECTION
NE $\frac{1}{4}$ SE $\frac{1}{4}$
SEC. 6

Oregon State Water Filings

TOWNSHIP 30 S, RANGE 34 E, W. M.

North

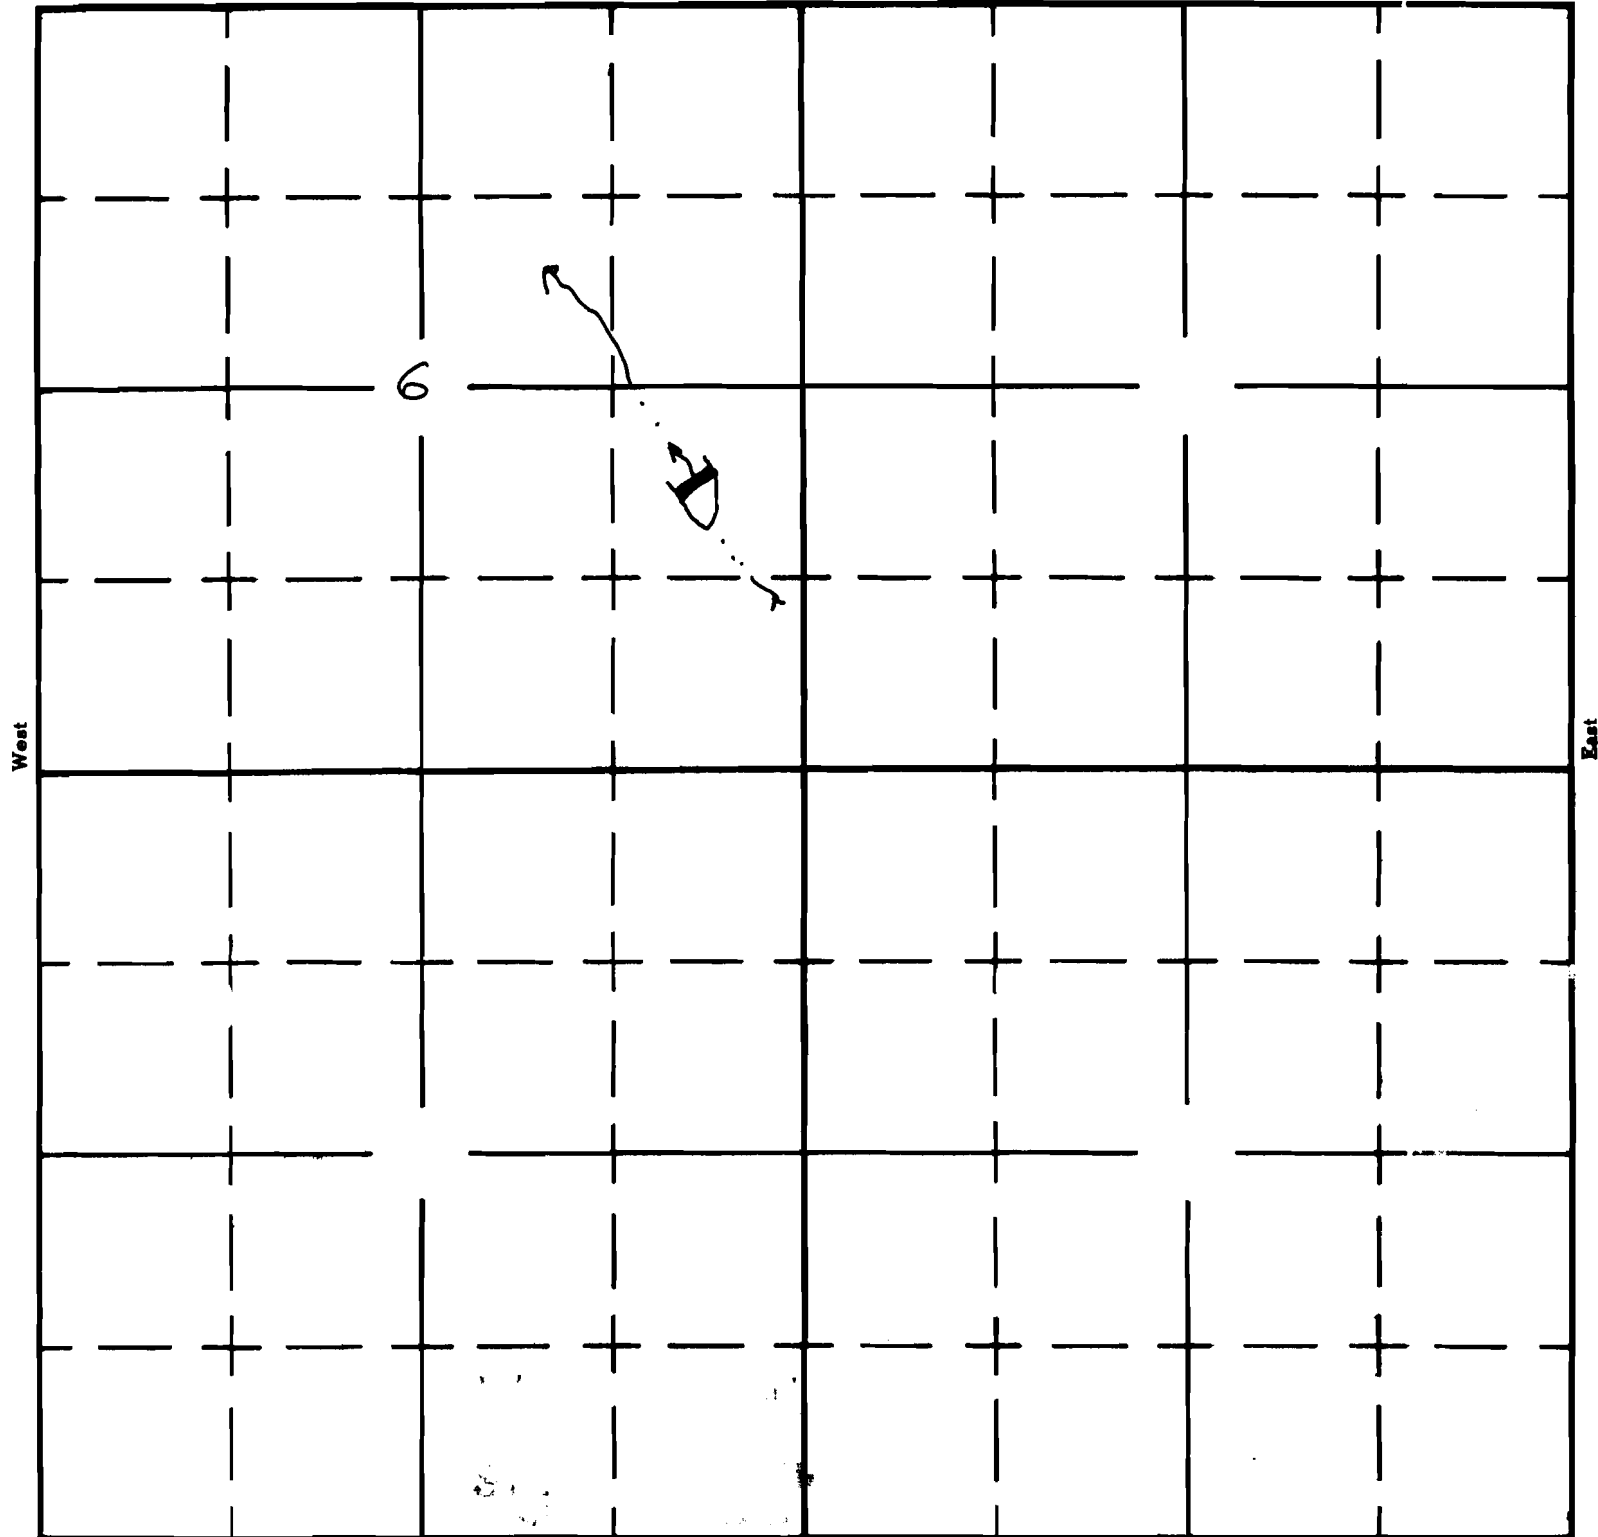


South

APPLICATION No. R-35651
PERMIT No. R-4193