

Form AI-187
March 1961

UNITED STATES
DEPARTMENT OF THE INTERIOR
BUREAU OF LAND MANAGEMENT

SECTION


NW 1/4 NW 1/4

Oregon State Water Filings

SEC. 11

TOWNSHIP 30 S, RANGE 35 E, W. M.

North

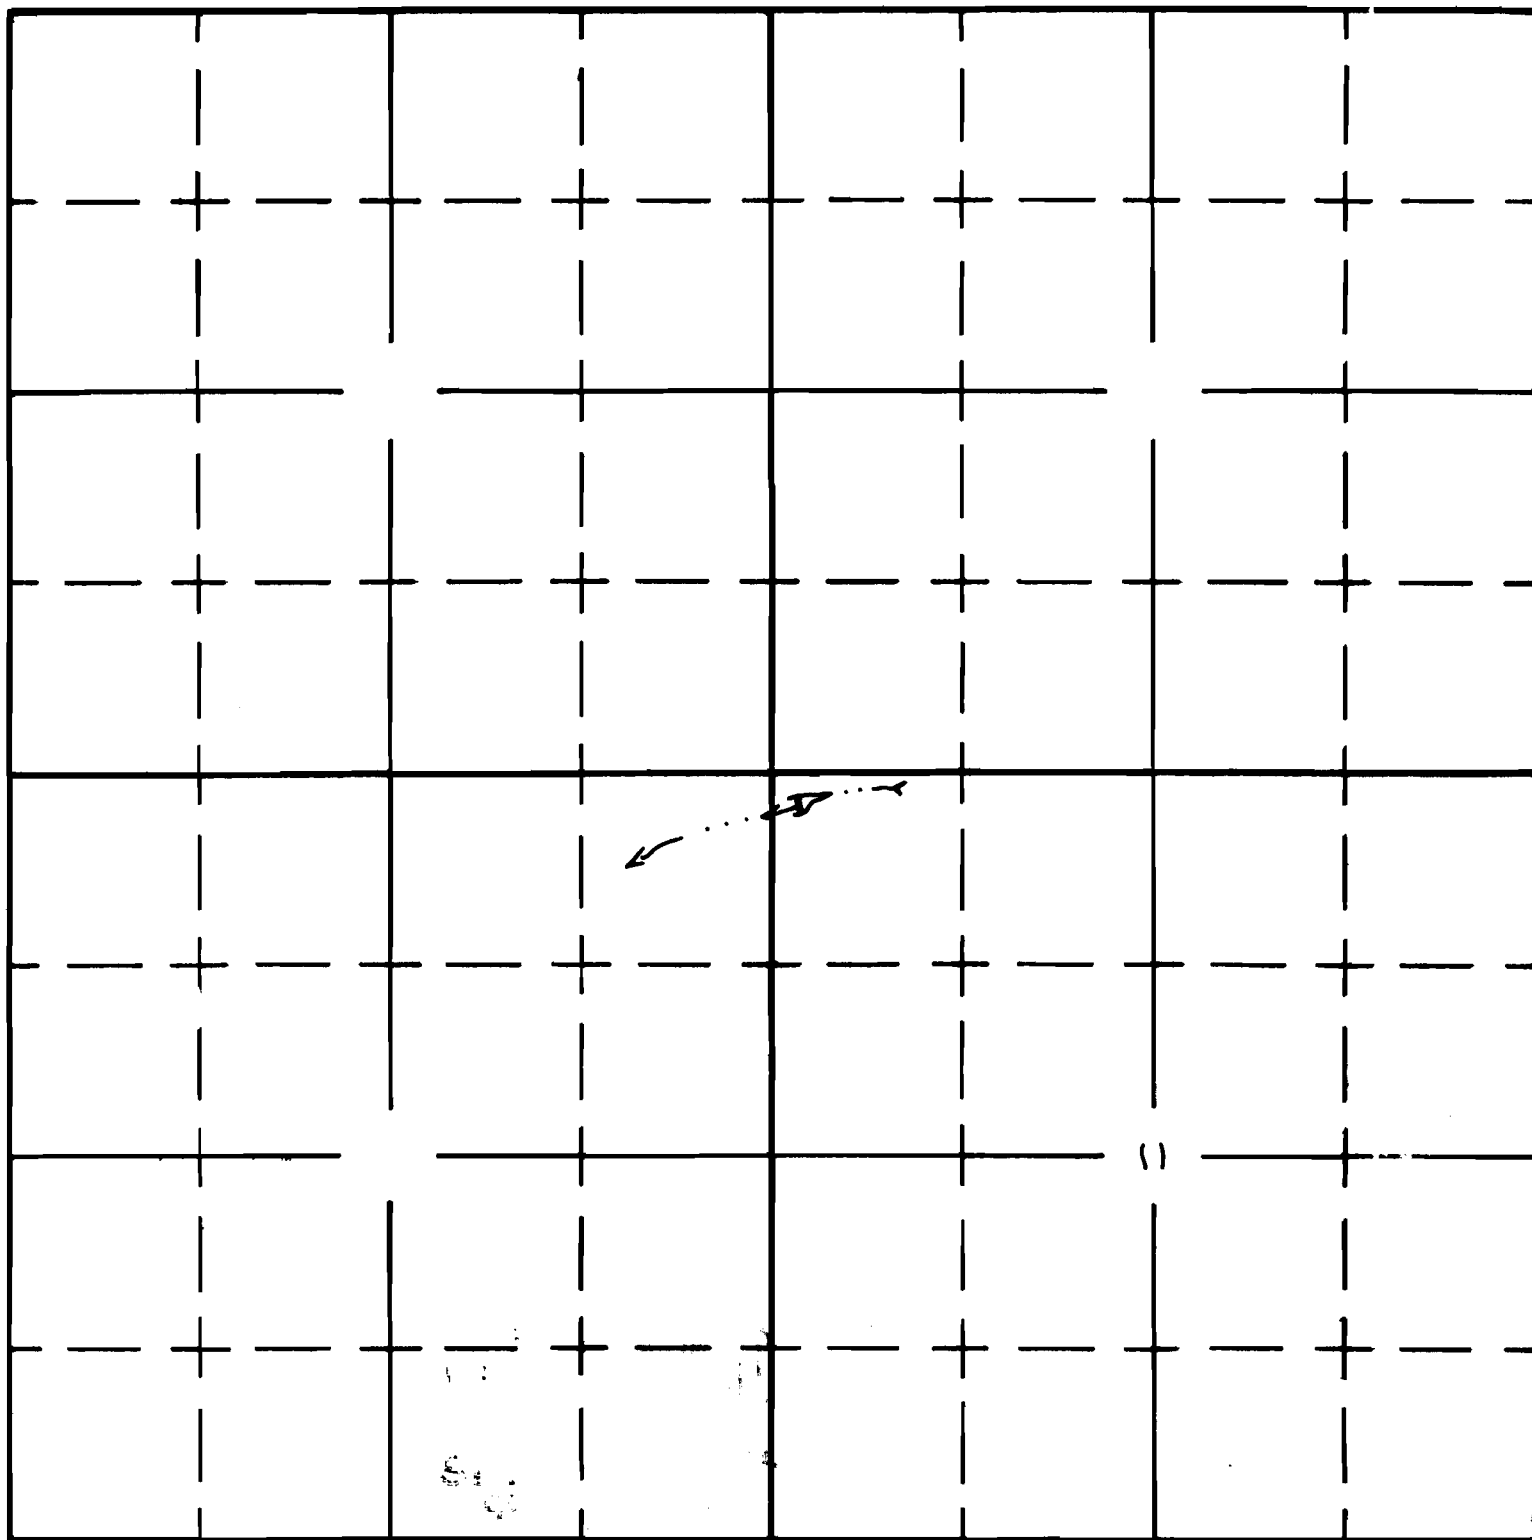

South

APPLICATION No. R-35671
PERMIT No. R-4194