

UNITED STATES
DEPARTMENT OF THE INTERIOR
BUREAU OF LAND MANAGEMENT

SECTION


NW 1/4 SW 1/4

Sec 2

Oregon State Water Filings

TOWNSHIP 30 S, RANGE 33 E, W. M.

North

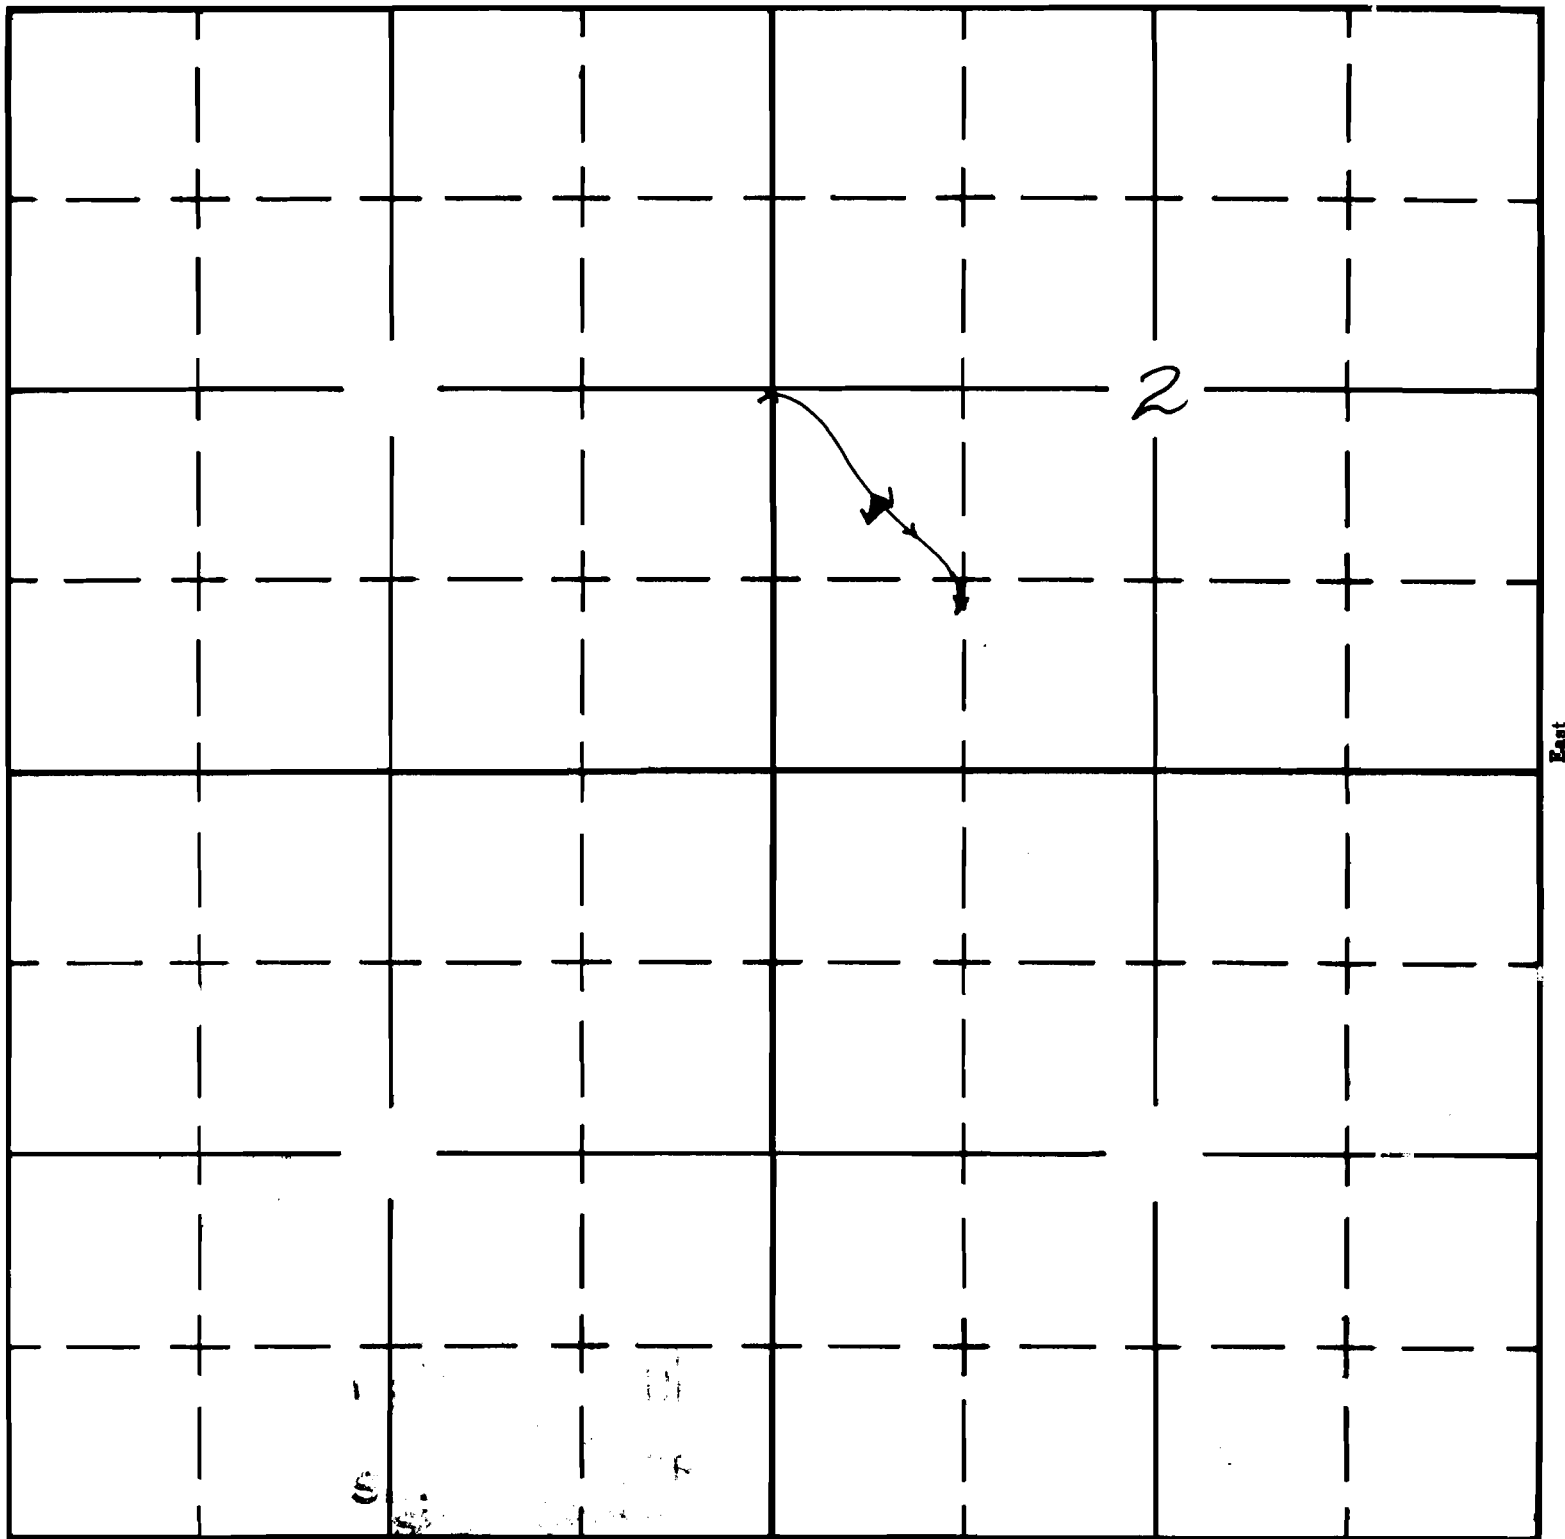

South

APPLICATION No. R-35672
PERMIT No. R-4195