

UNITED STATES
DEPARTMENT OF THE INTERIOR
BUREAU OF LAND MANAGEMENT

SECTION


Oregon State Water Filings

NE 1/4 SE 1/4

TOWNSHIP 22S, RANGE 29E, W. M.

Sec. 3

North

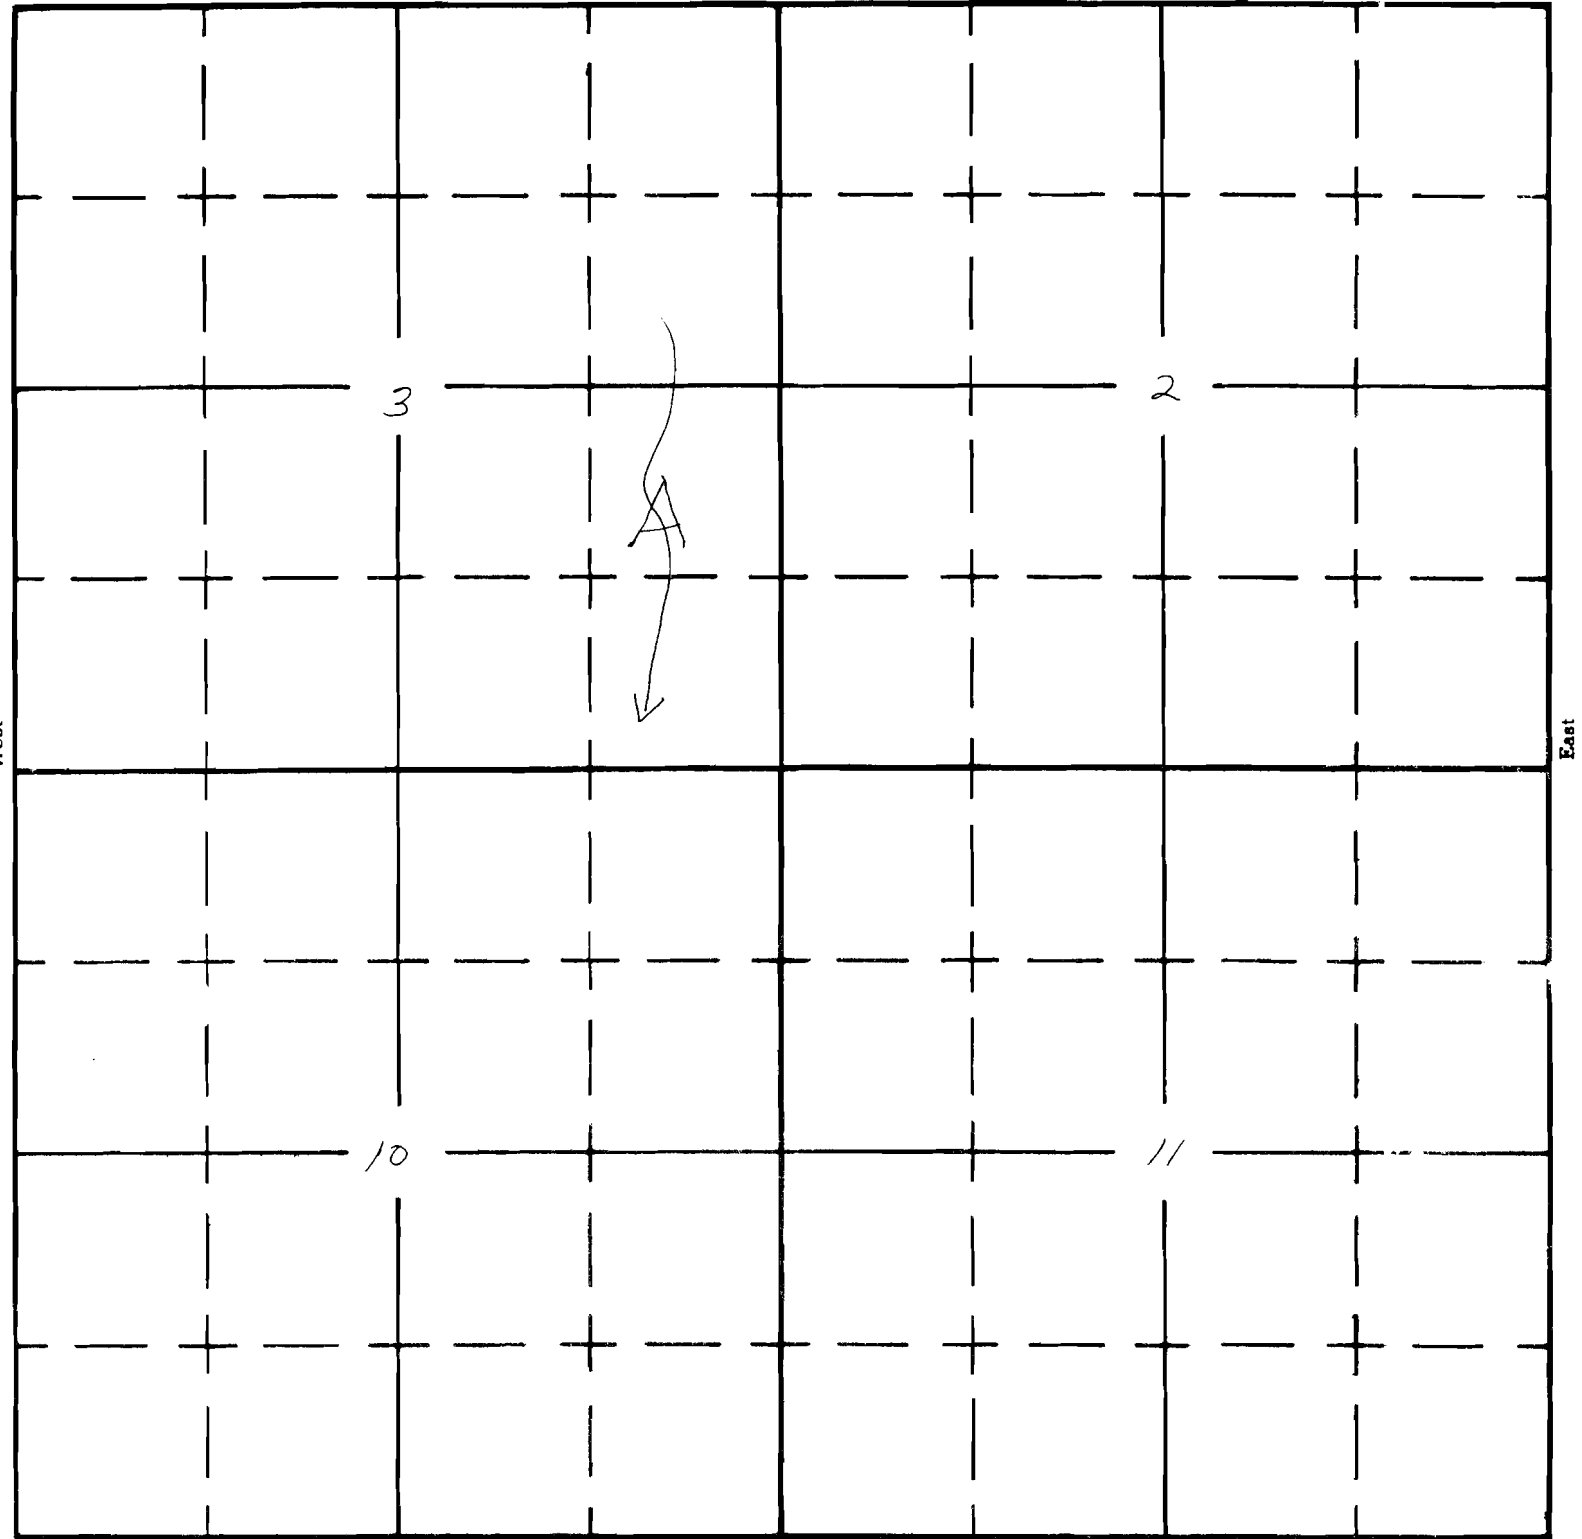

South