

UNITED STATES
DEPARTMENT OF THE INTERIOR
BUREAU OF LAND MANAGEMENT

SECTION


Oregon State Water Filings

SE 1/4 NW 1/4

TOWNSHIP 21S, RANGE 29E, W. M.

Sec. 22

North

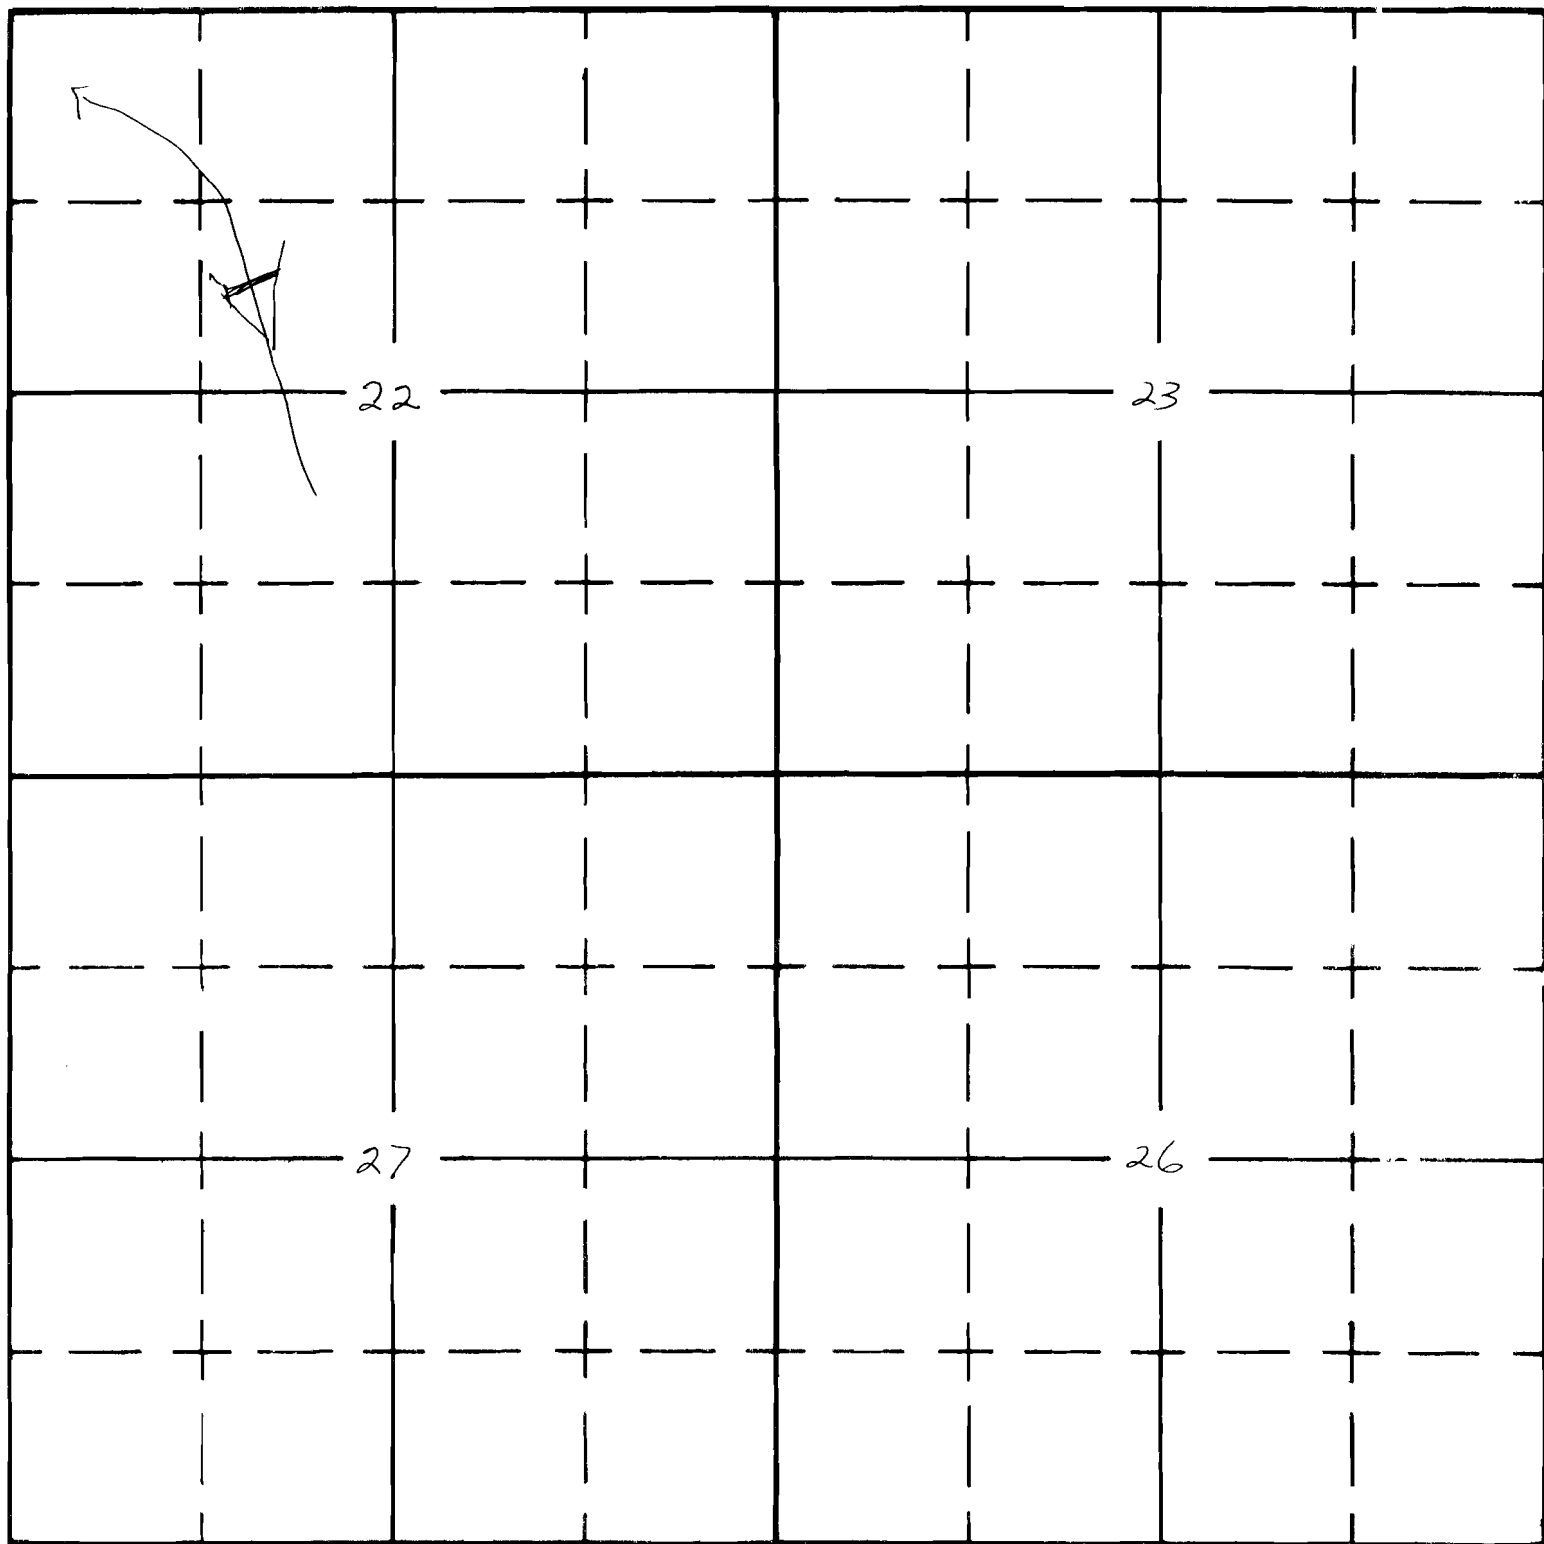

West

East

South

APPLICATION No. 11-37-200
PERMIT No. 4-11-37