

UNITED STATES
DEPARTMENT OF THE INTERIOR
BUREAU OF LAND MANAGEMENT

SECTION


32

SE $\frac{1}{4}$

Oregon State Water Filings

TOWNSHIP 26 S, RANGE 34, W. M.

North

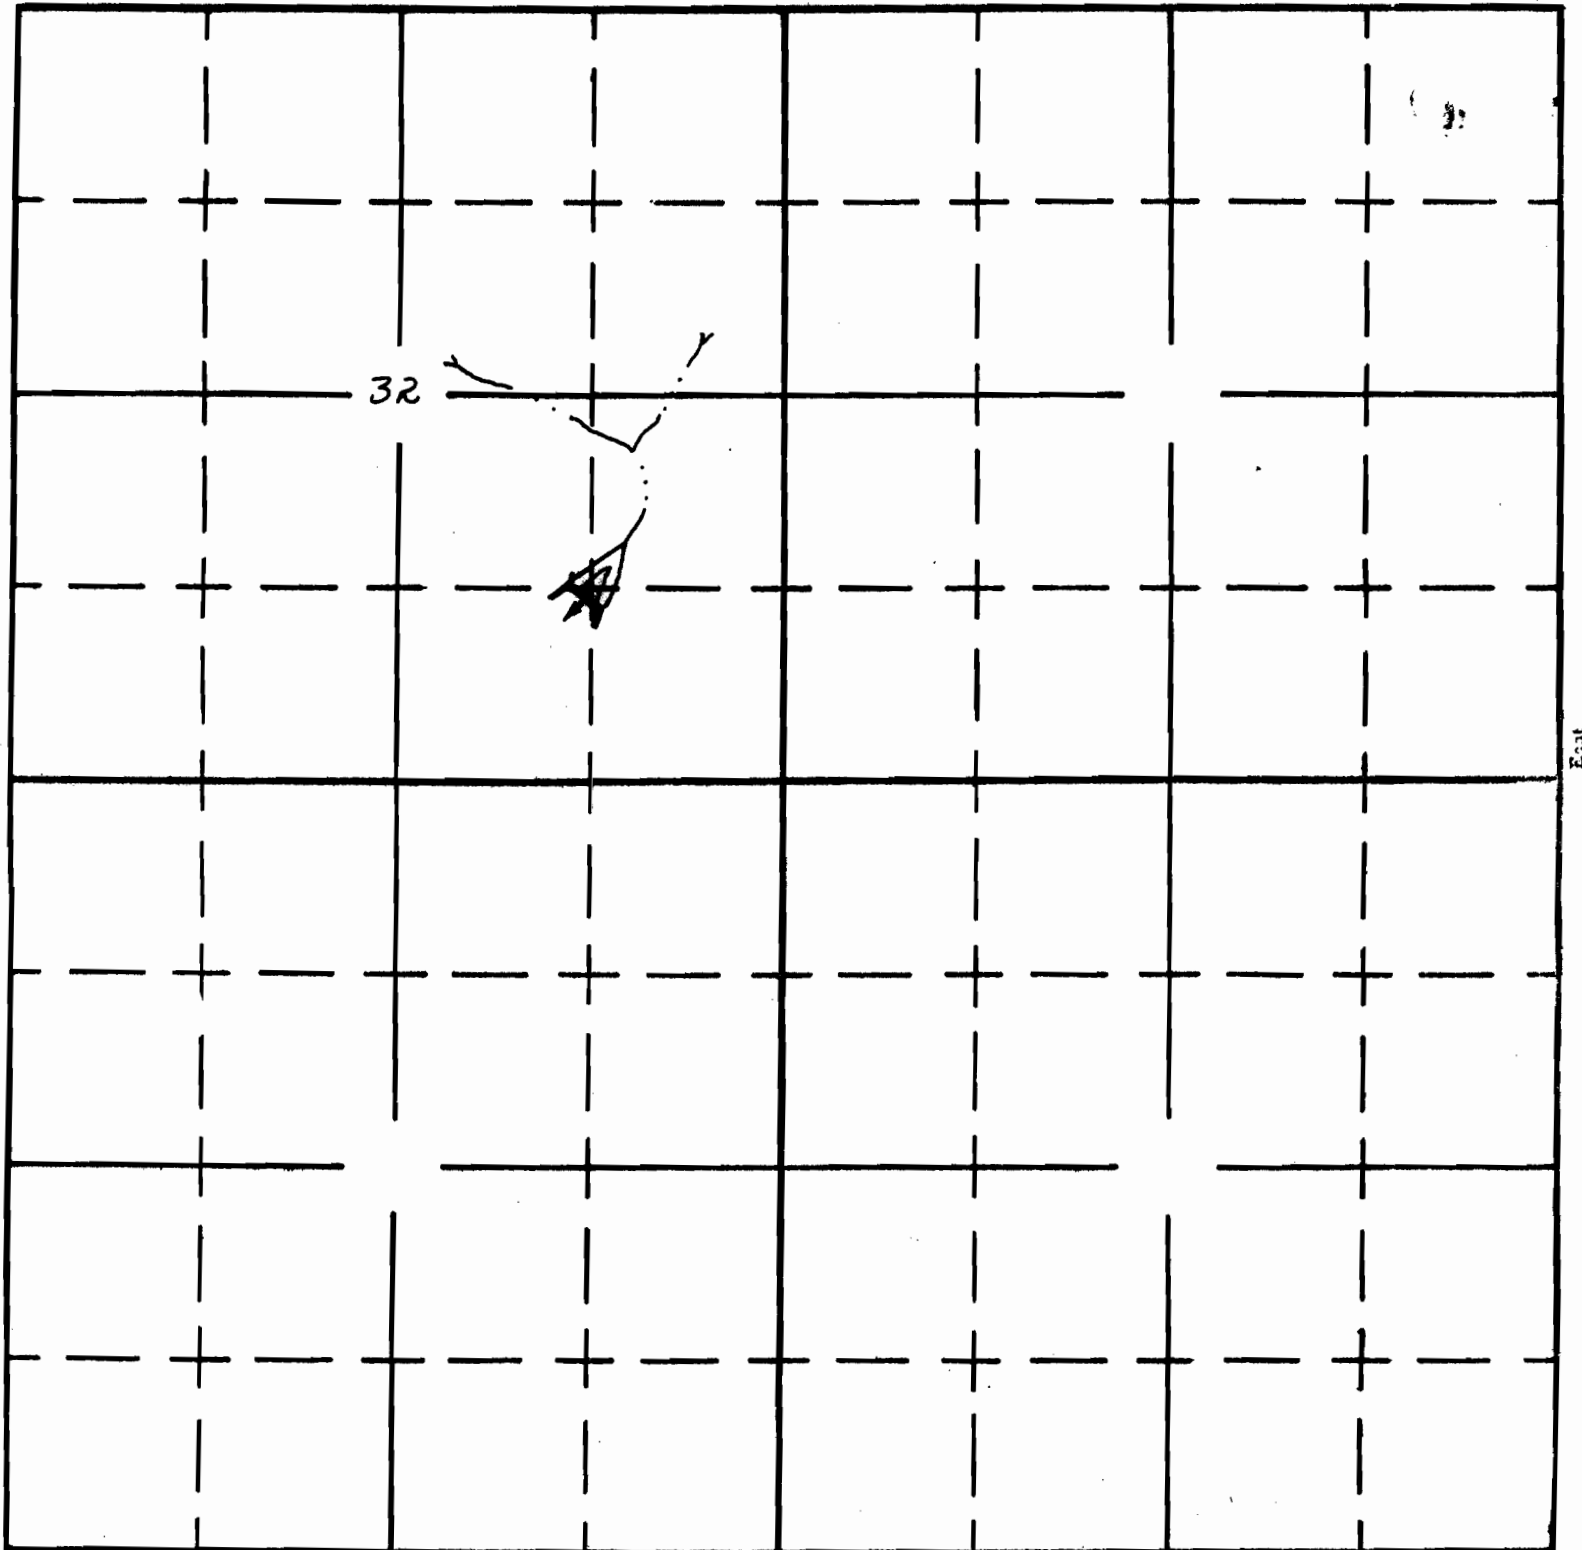

South

APPLICATION No. R-35000

PERMIT No. 6225