

UNITED STATES
DEPARTMENT OF THE INTERIOR
BUREAU OF LAND MANAGEMENT

SECTION


4

E¹/₂ SE¹/₄

Oregon State Water Filings

TOWNSHIP 27 S, RANGE 34 E, W. M.

North

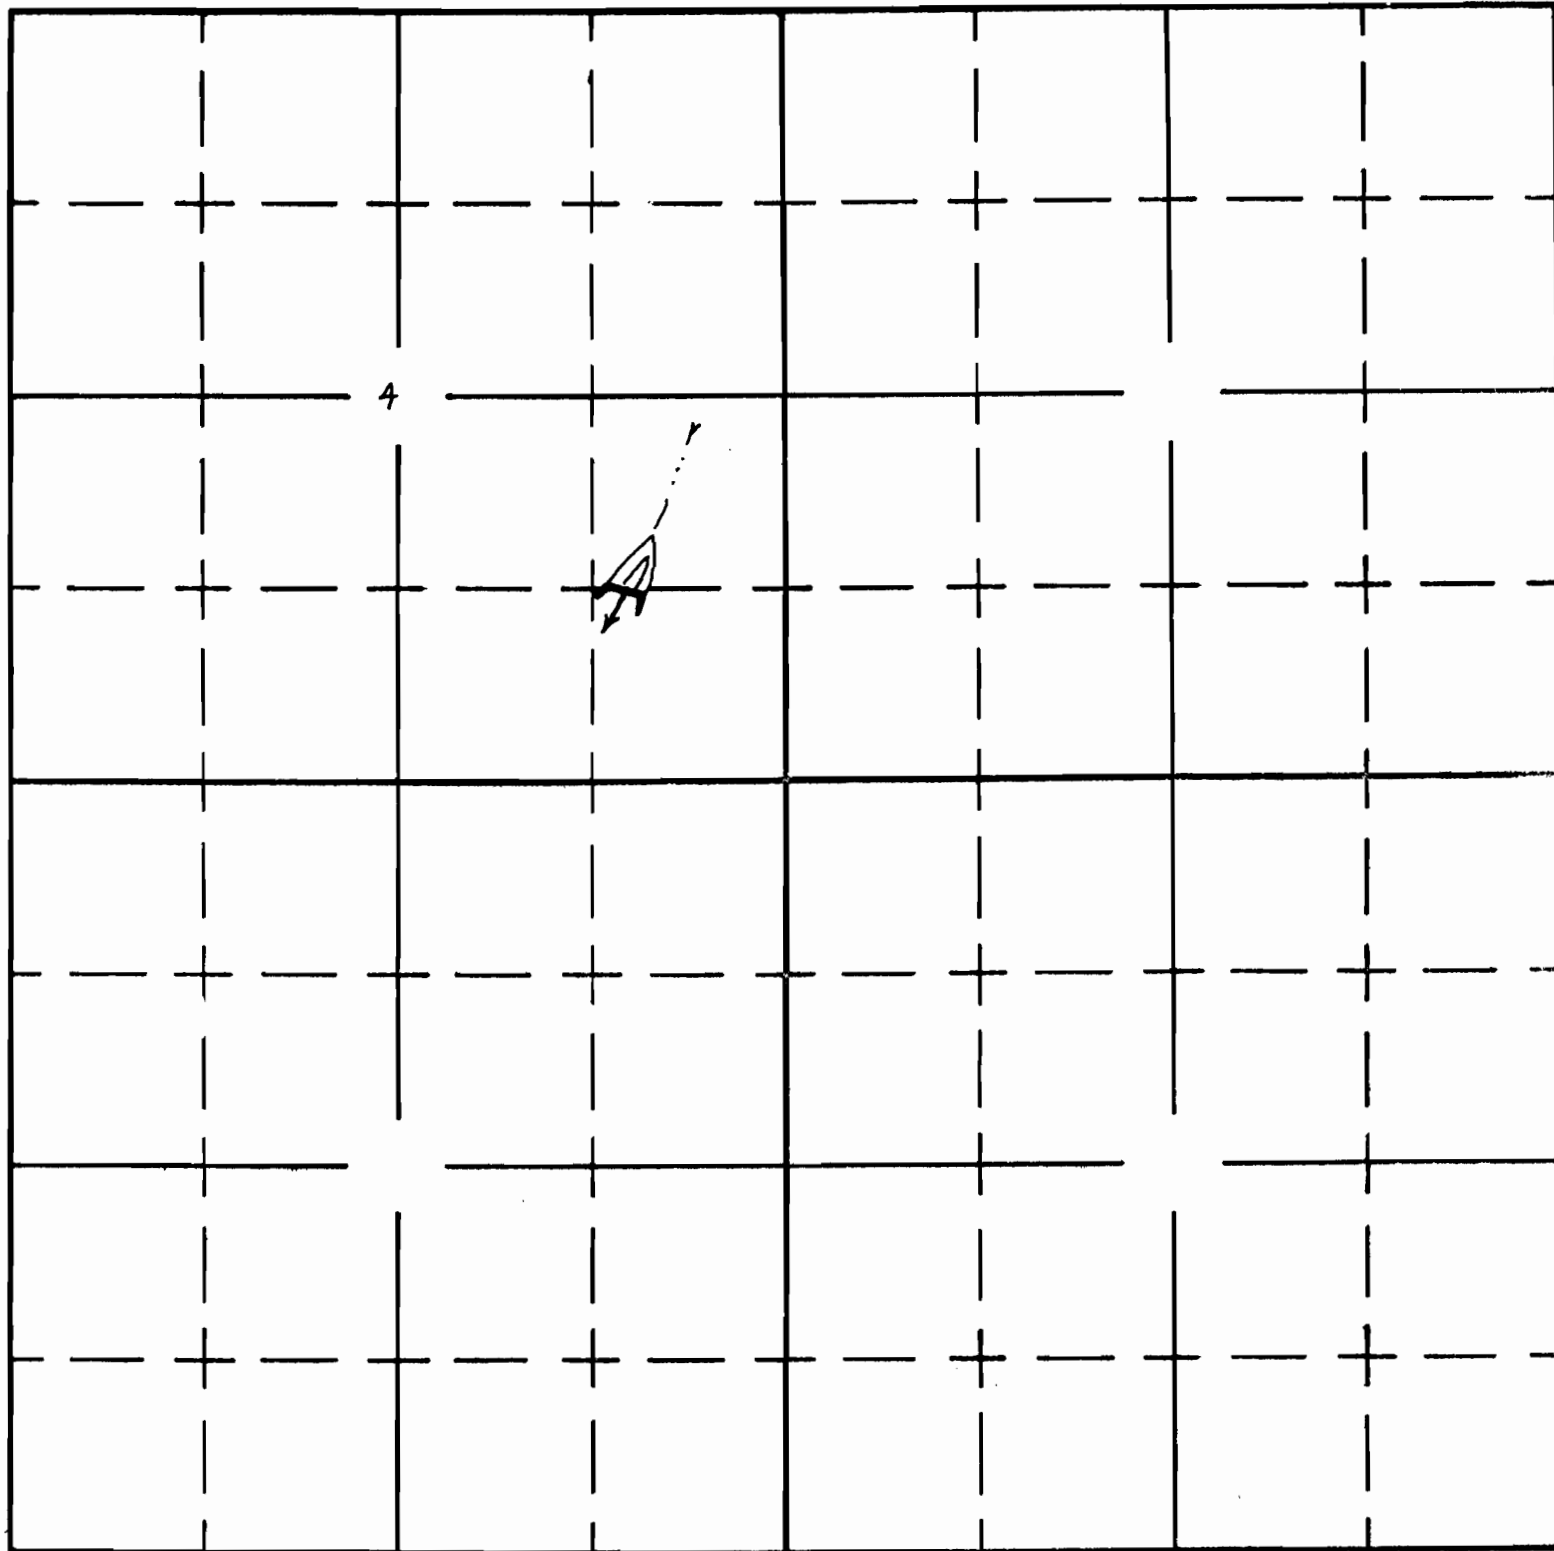

South

APPLICATION No. R-35001
PERMIT No. R 6776