

Form AI-187
March 1961

UNITED STATES
DEPARTMENT OF THE INTERIOR
BUREAU OF LAND MANAGEMENT

SECTION


Oregon State Water Filings

SE 1/4 NE 1/4

TOWNSHIP 28S, RANGE 34E, W. M.

Sec 12

North

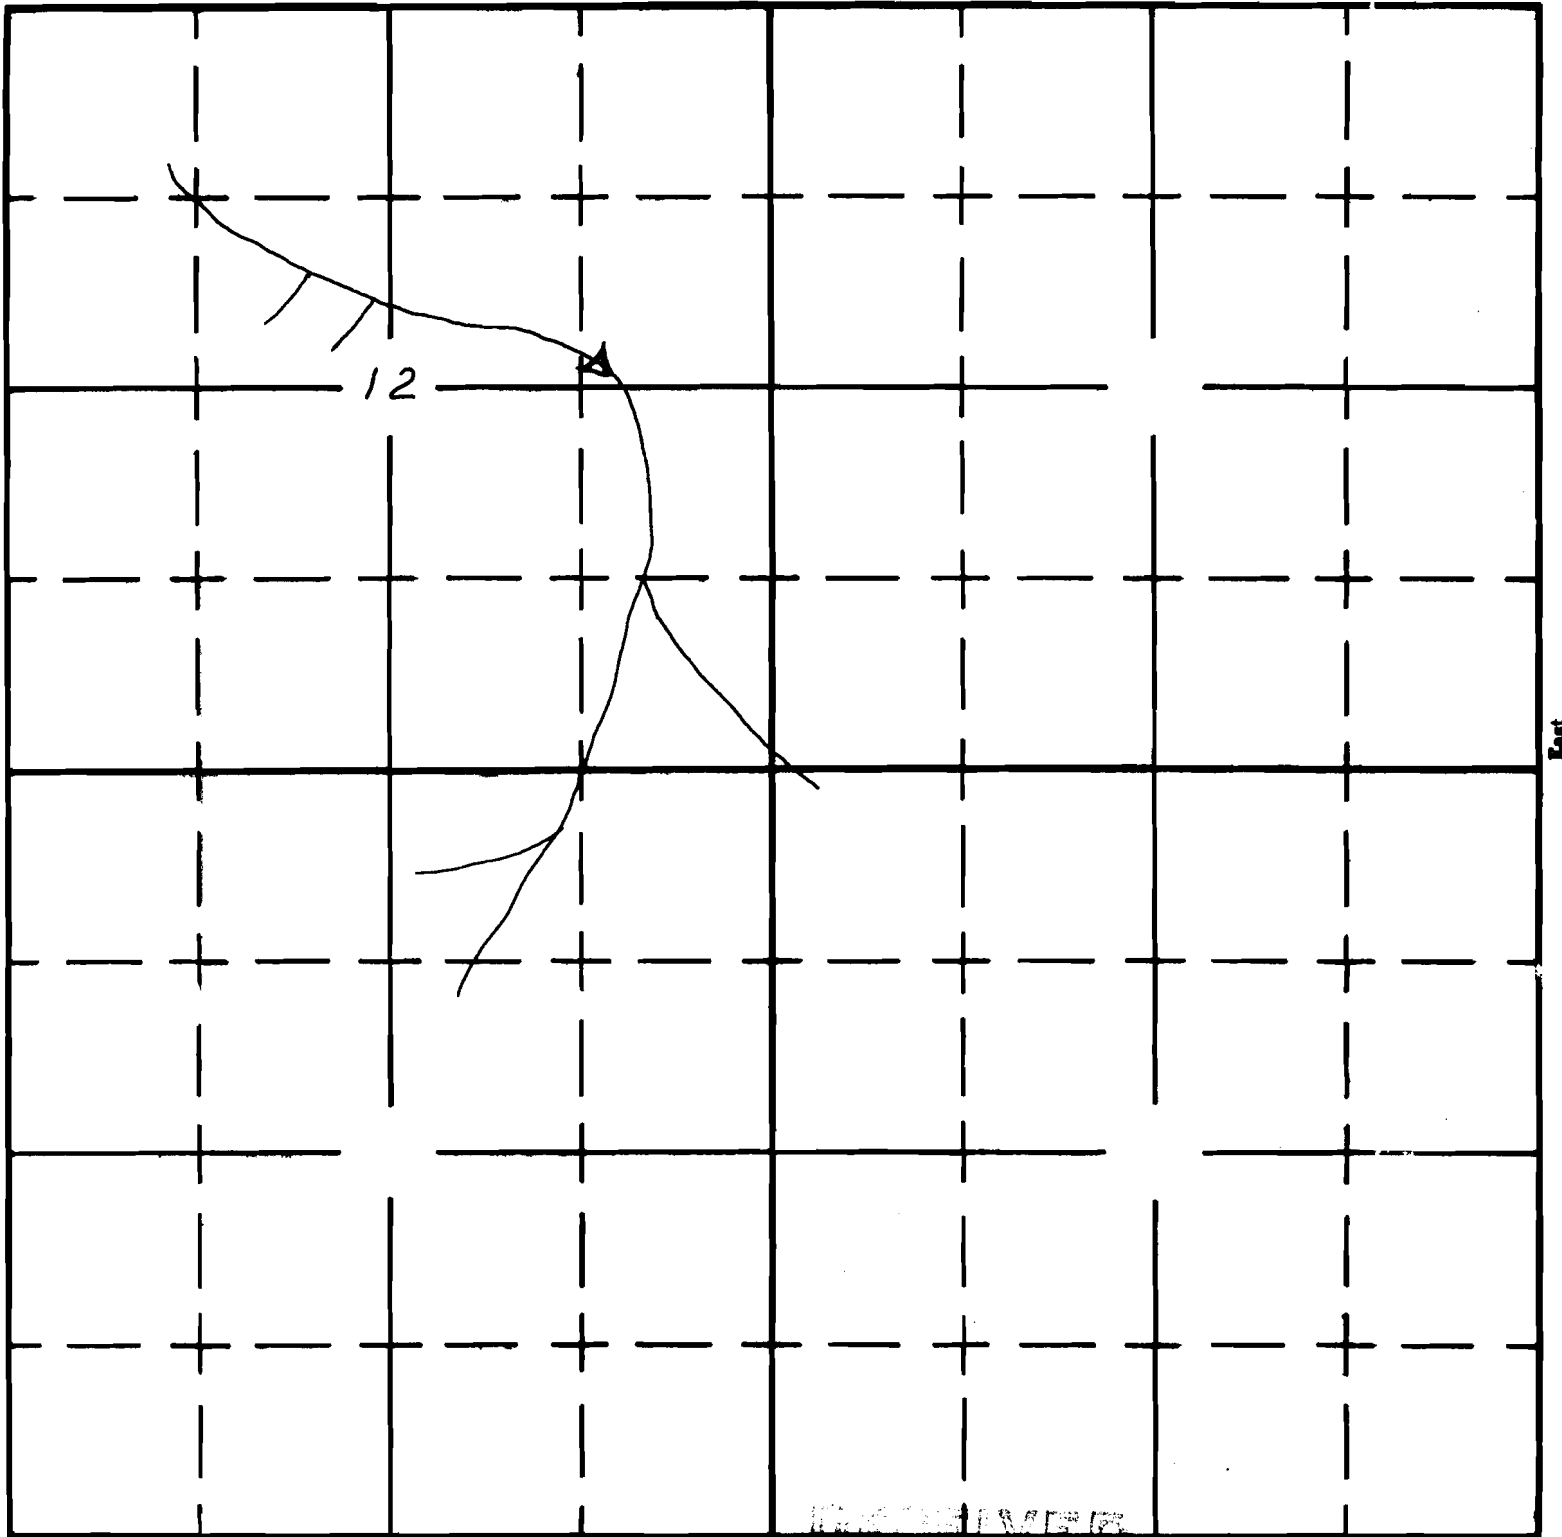

South

RECEIVED
STATE ENGINEER
SALEM, OREGON

APPLICATION No. R-35668
PERMIT No. R 6781