

Form AI-187
March 1961


UNITED STATES
DEPARTMENT OF THE INTERIOR
BUREAU OF LAND MANAGEMENT

SECTION
SW $\frac{1}{4}$ NW $\frac{1}{4}$
SEC. 7

Oregon State Water Filings

TOWNSHIP 21S, RANGE 30E, W. M.

North

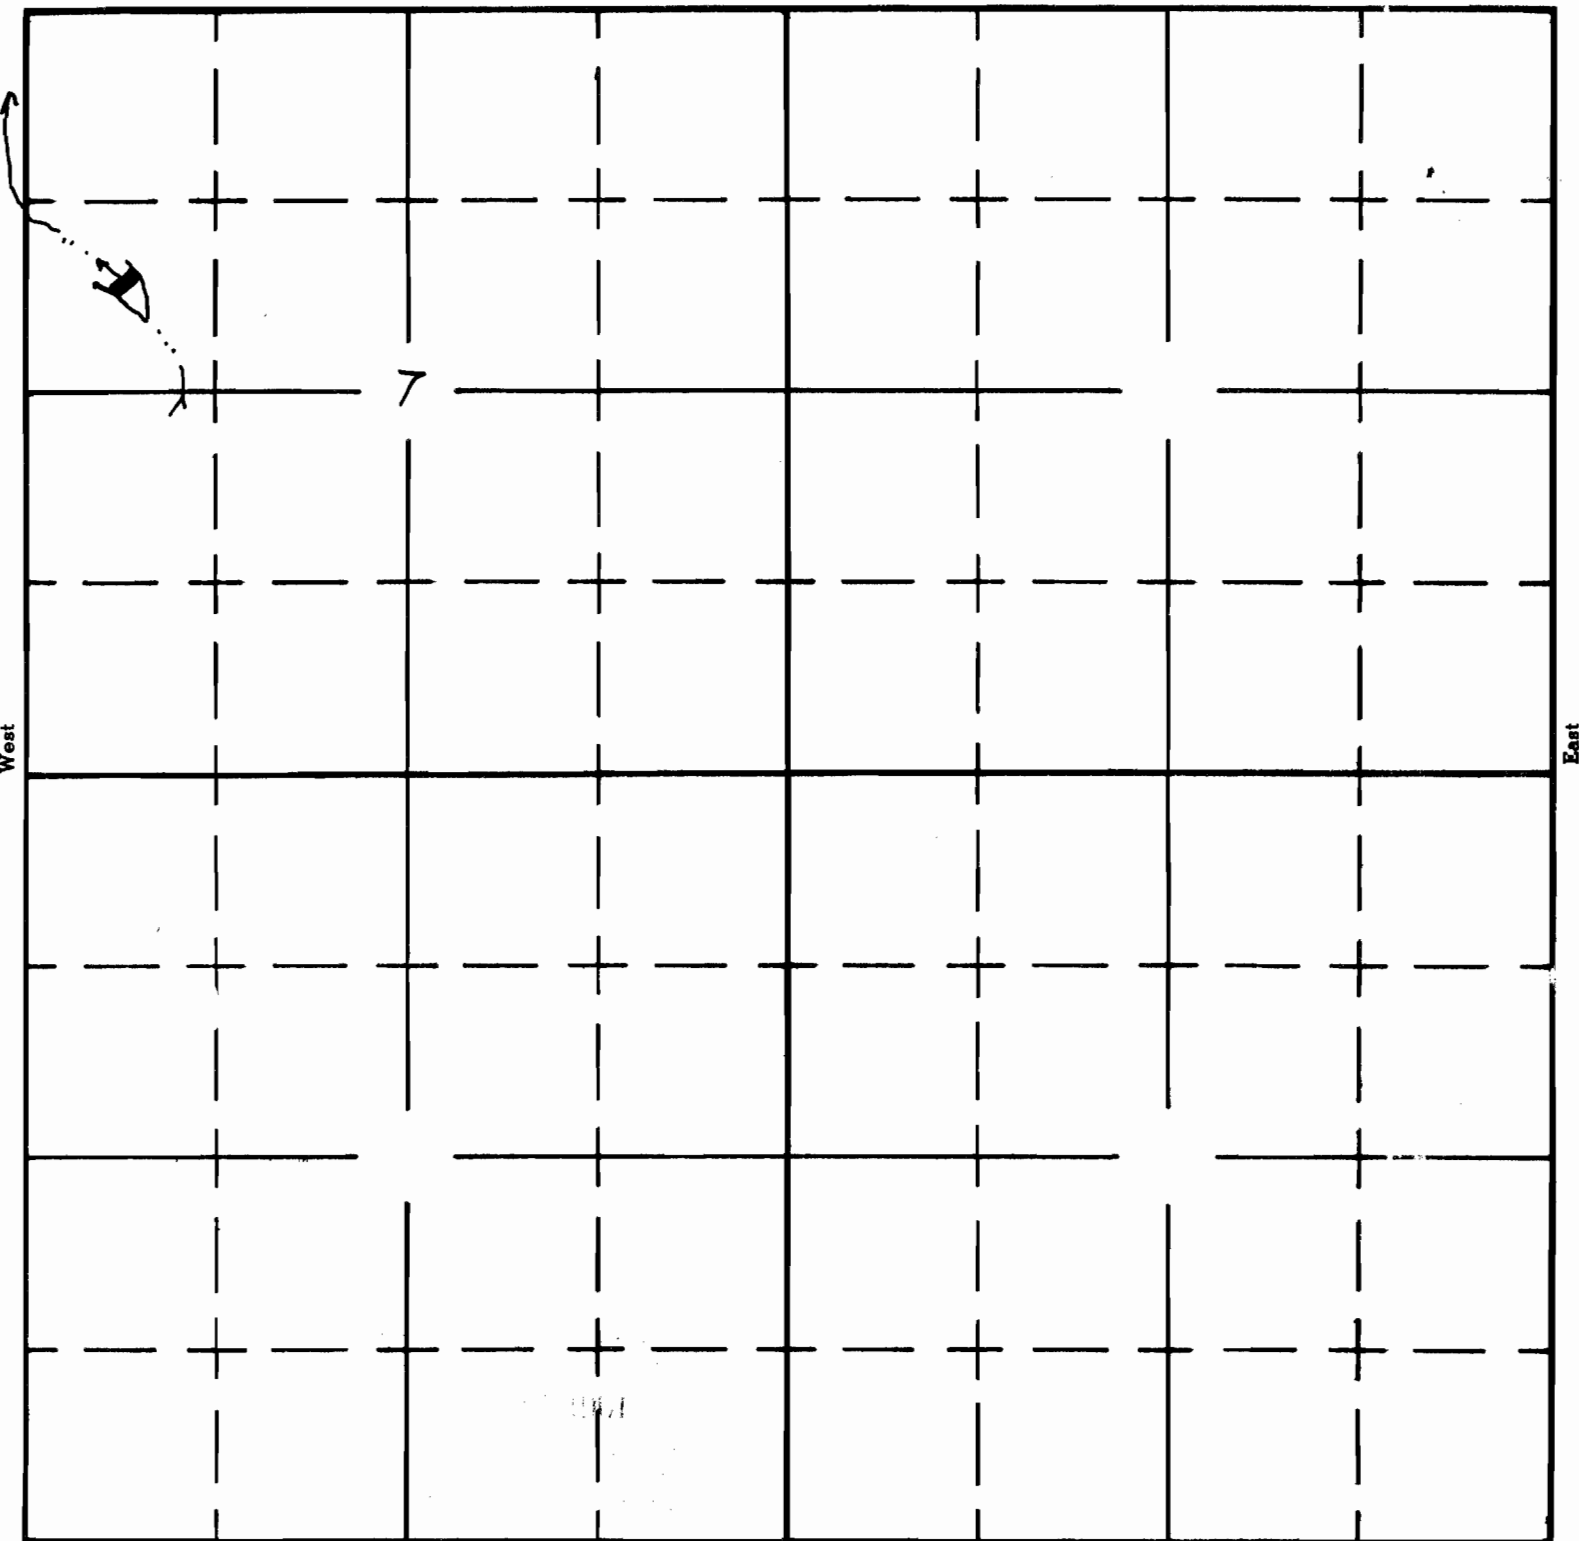

South

*Unrecorded
Land Co.*

APPLICATION No. R-35475
PERMIT No. R 6785