

Form AI-187  
March 1961

UNITED STATES  
DEPARTMENT OF THE INTERIOR  
BUREAU OF LAND MANAGEMENT

SECTION


NE  $\frac{1}{4}$  SE  $\frac{1}{4}$


SEC. 14

TOWNSHIP 29 S., RANGE 30 E., W. M.

North

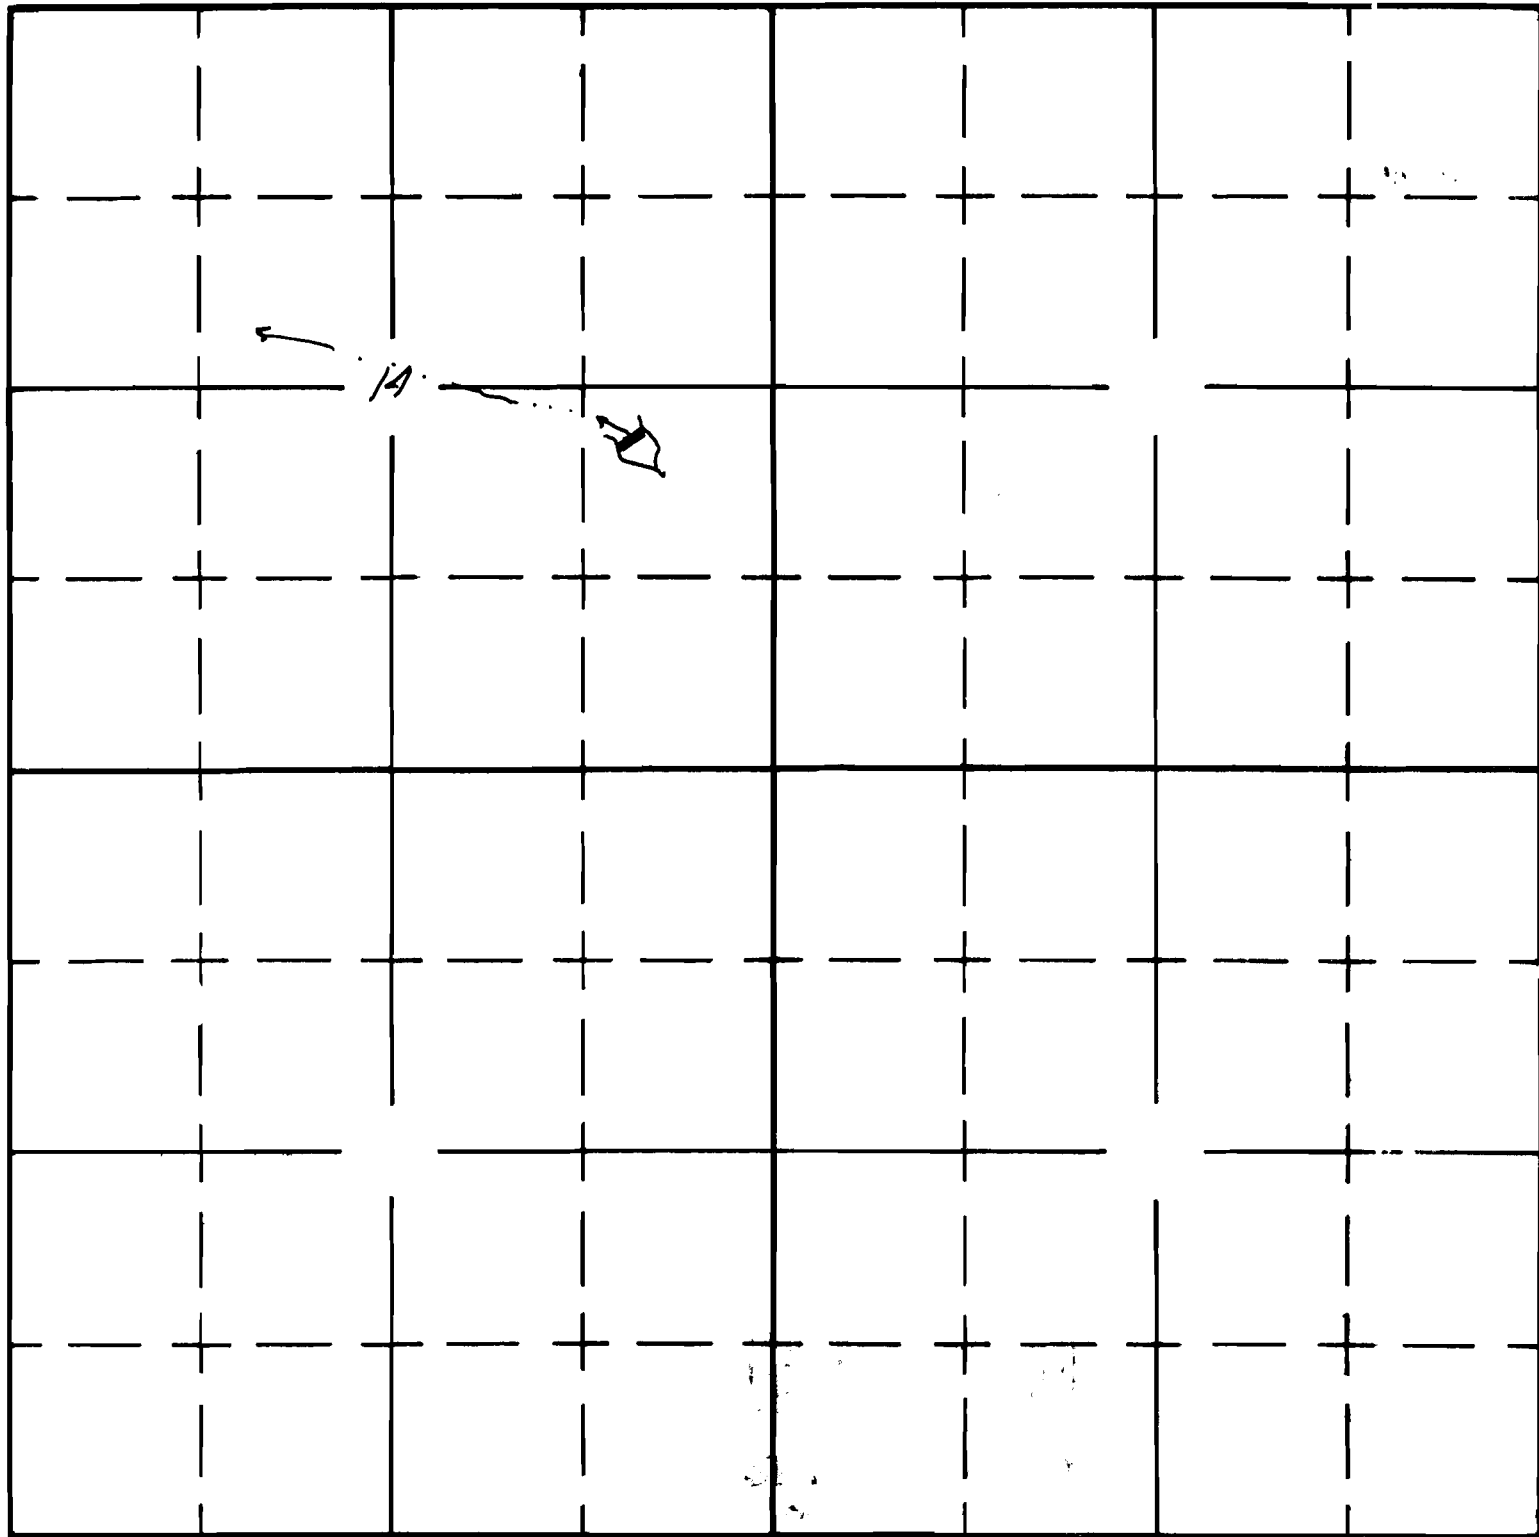

South

APPLICATION No. R-35607

PERMIT No. 7704