

Form A1-187
March 1961

UNITED STATES
DEPARTMENT OF THE INTERIOR
BUREAU OF LAND MANAGEMENT

SECTION


SE 4 SE 4

Oregon State Water Filings

6

TOWNSHIP 22 S, RANGE 36 E, W. M.

North

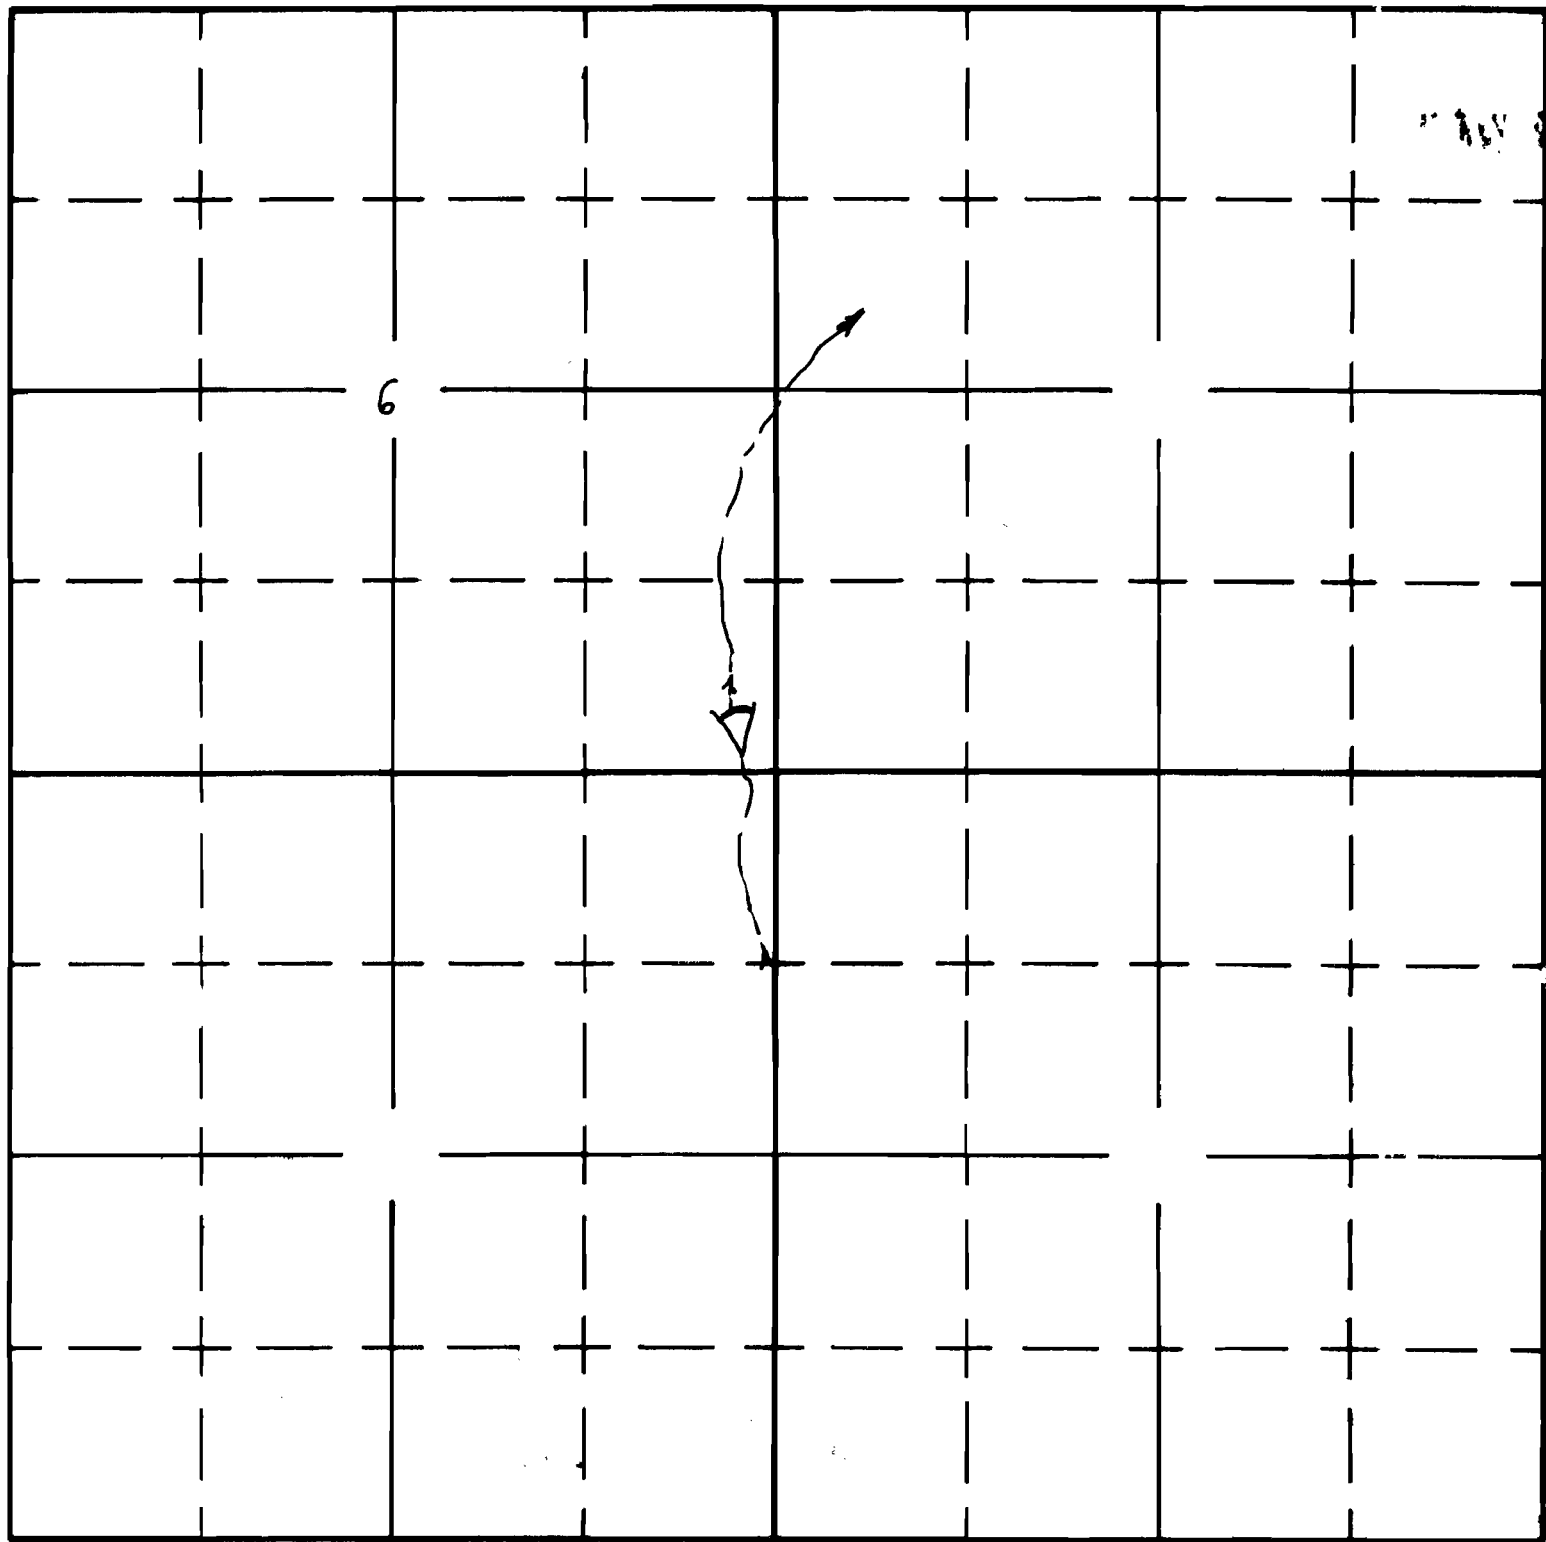

South

APPLICATION No. R-35613

PERMIT No. H 8798