

Form A1-187
March 1961

UNITED STATES
DEPARTMENT OF THE INTERIOR
BUREAU OF LAND MANAGEMENT

SECTION


SE 1/4 NW 1/4

Oregon State Water Filings

26.

TOWNSHIP 21 S, RANGE 29 E, W. M.

North

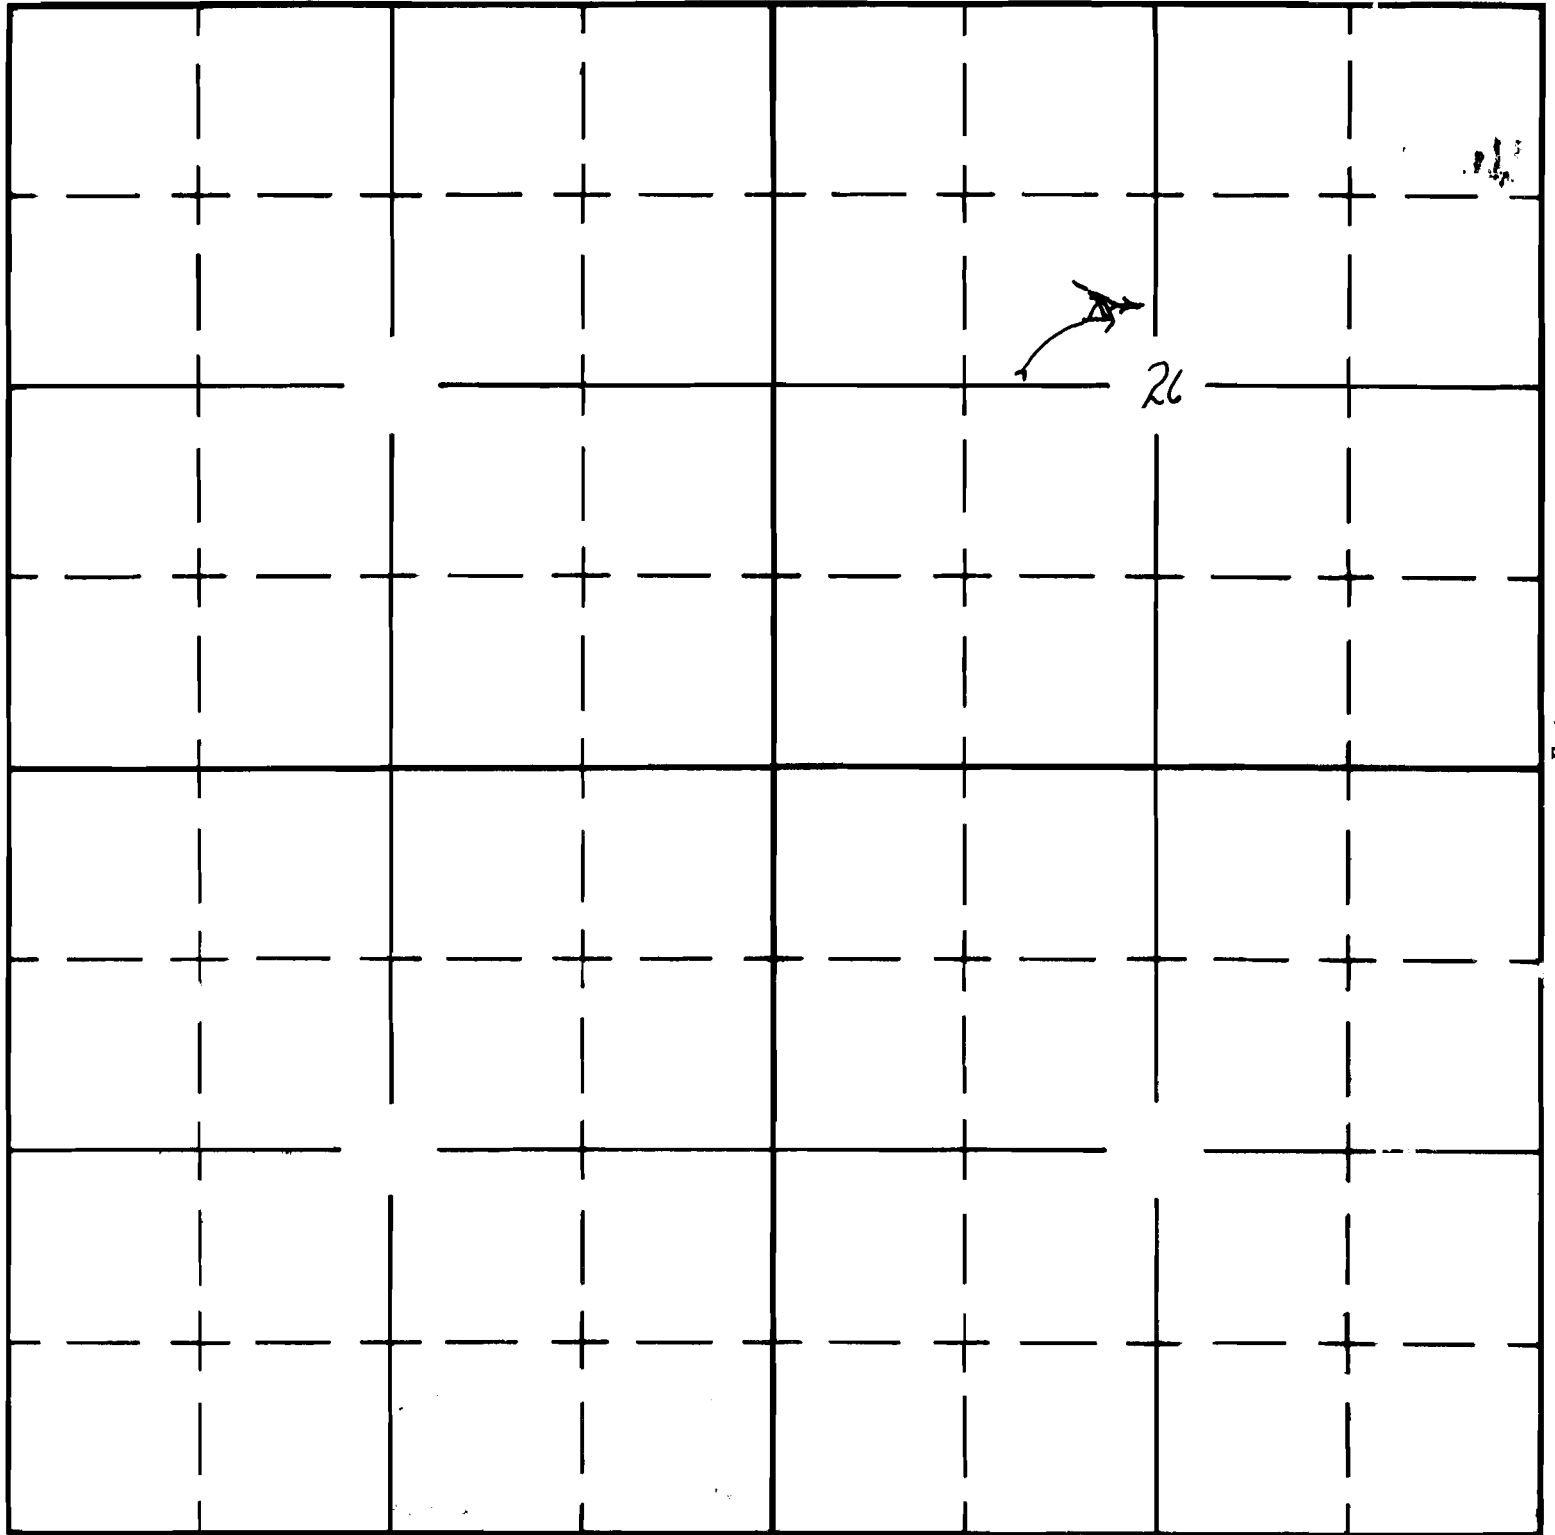

South

APPLICATION No. R-35614

PERMIT No. **13797**