

UNITED STATES
DEPARTMENT OF THE INTERIOR
BUREAU OF LAND MANAGEMENT

SECTION


SE 1/4 28 1/2

Oregon State Water Filings

7

TOWNSHIP 22S, RANGE 26E, W. M.

North

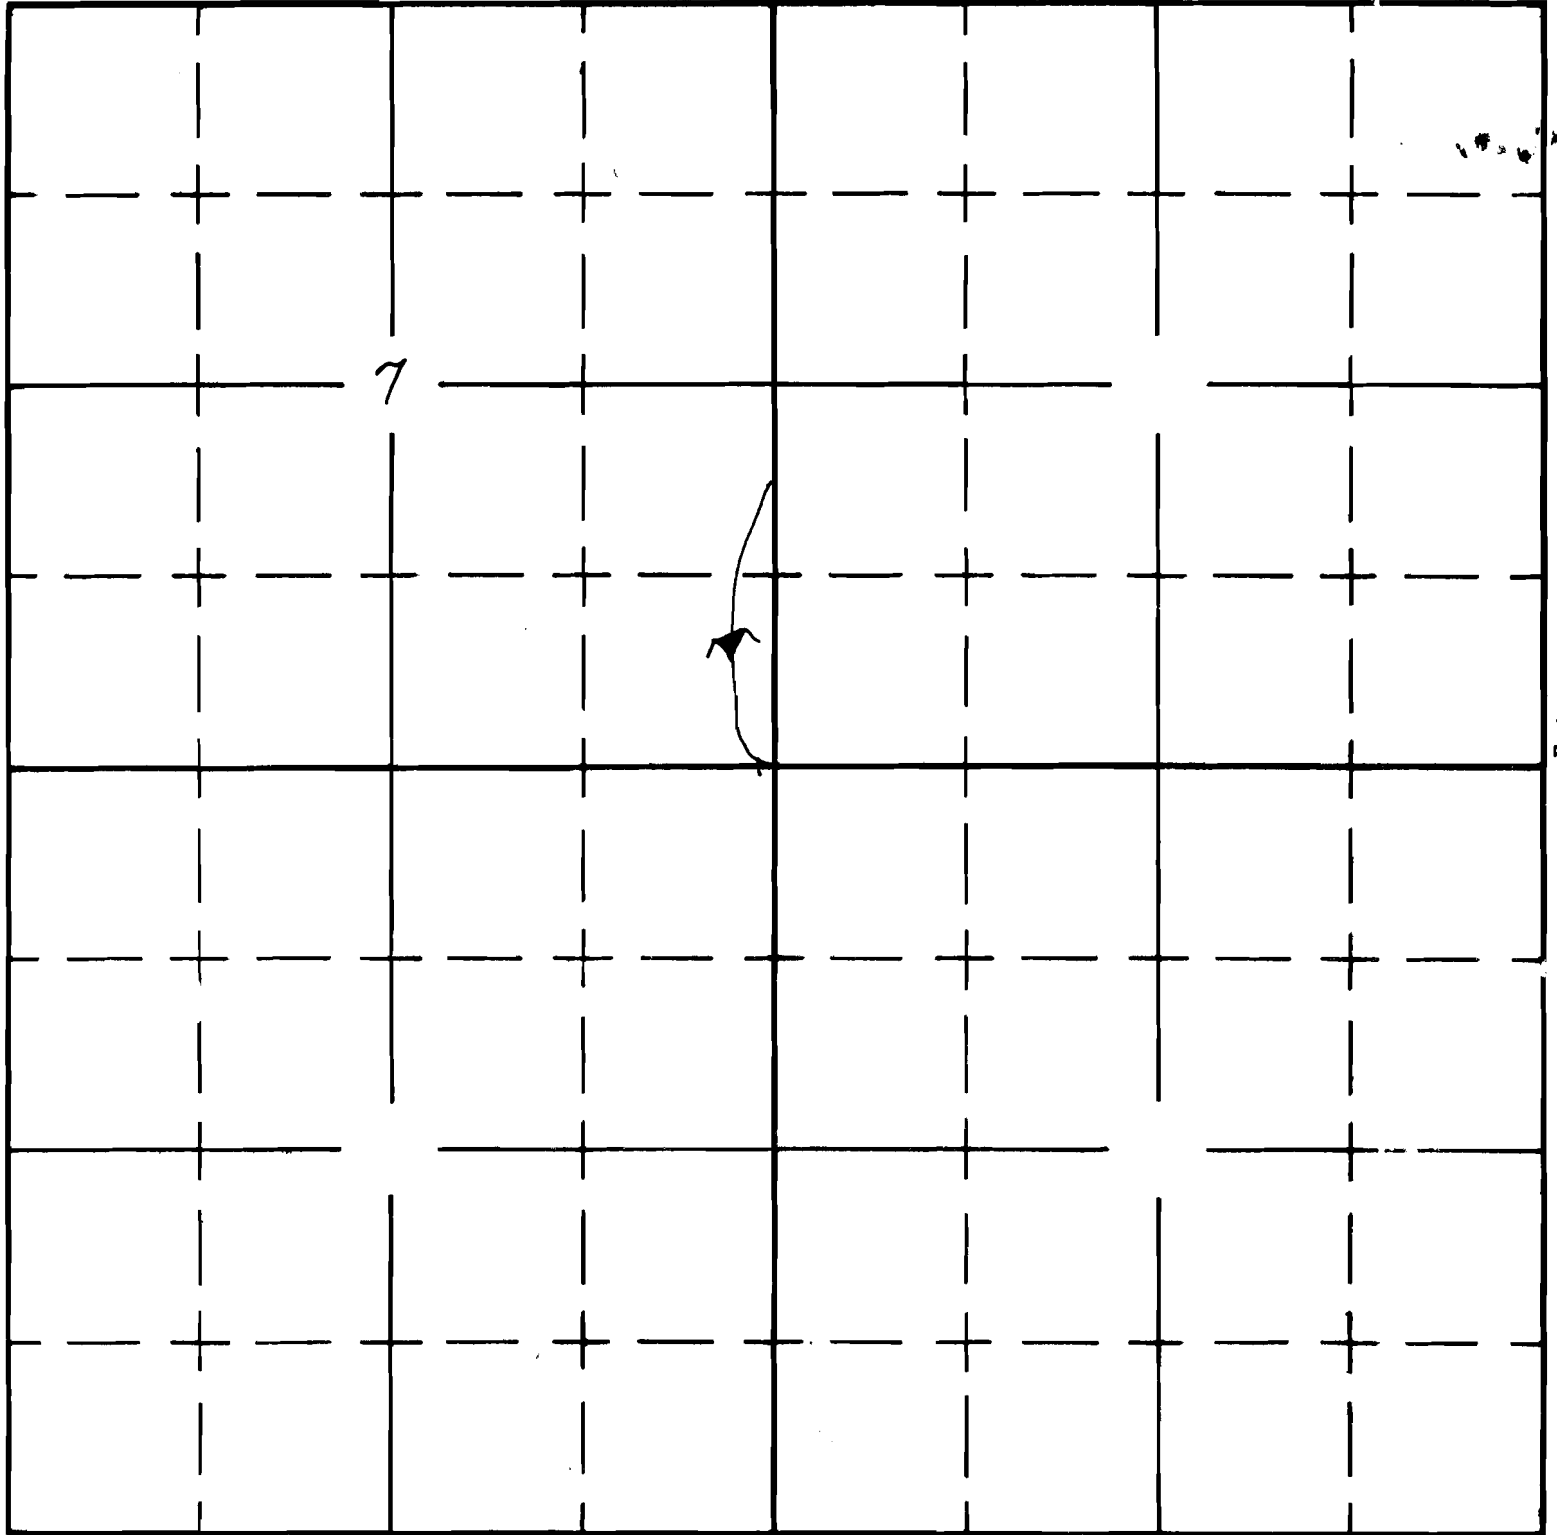

South

APPLICATION No. R-35619
PERMIT No. **H 8801**