

Form A1-187
March 1961

UNITED STATES
DEPARTMENT OF THE INTERIOR
BUREAU OF LAND MANAGEMENT

SECTION


SW $\frac{1}{4}$ NW $\frac{1}{4}$

Oregon State Water Filings

SEC. 34

TOWNSHIP 20S, RANGE 30E, W. M.

North

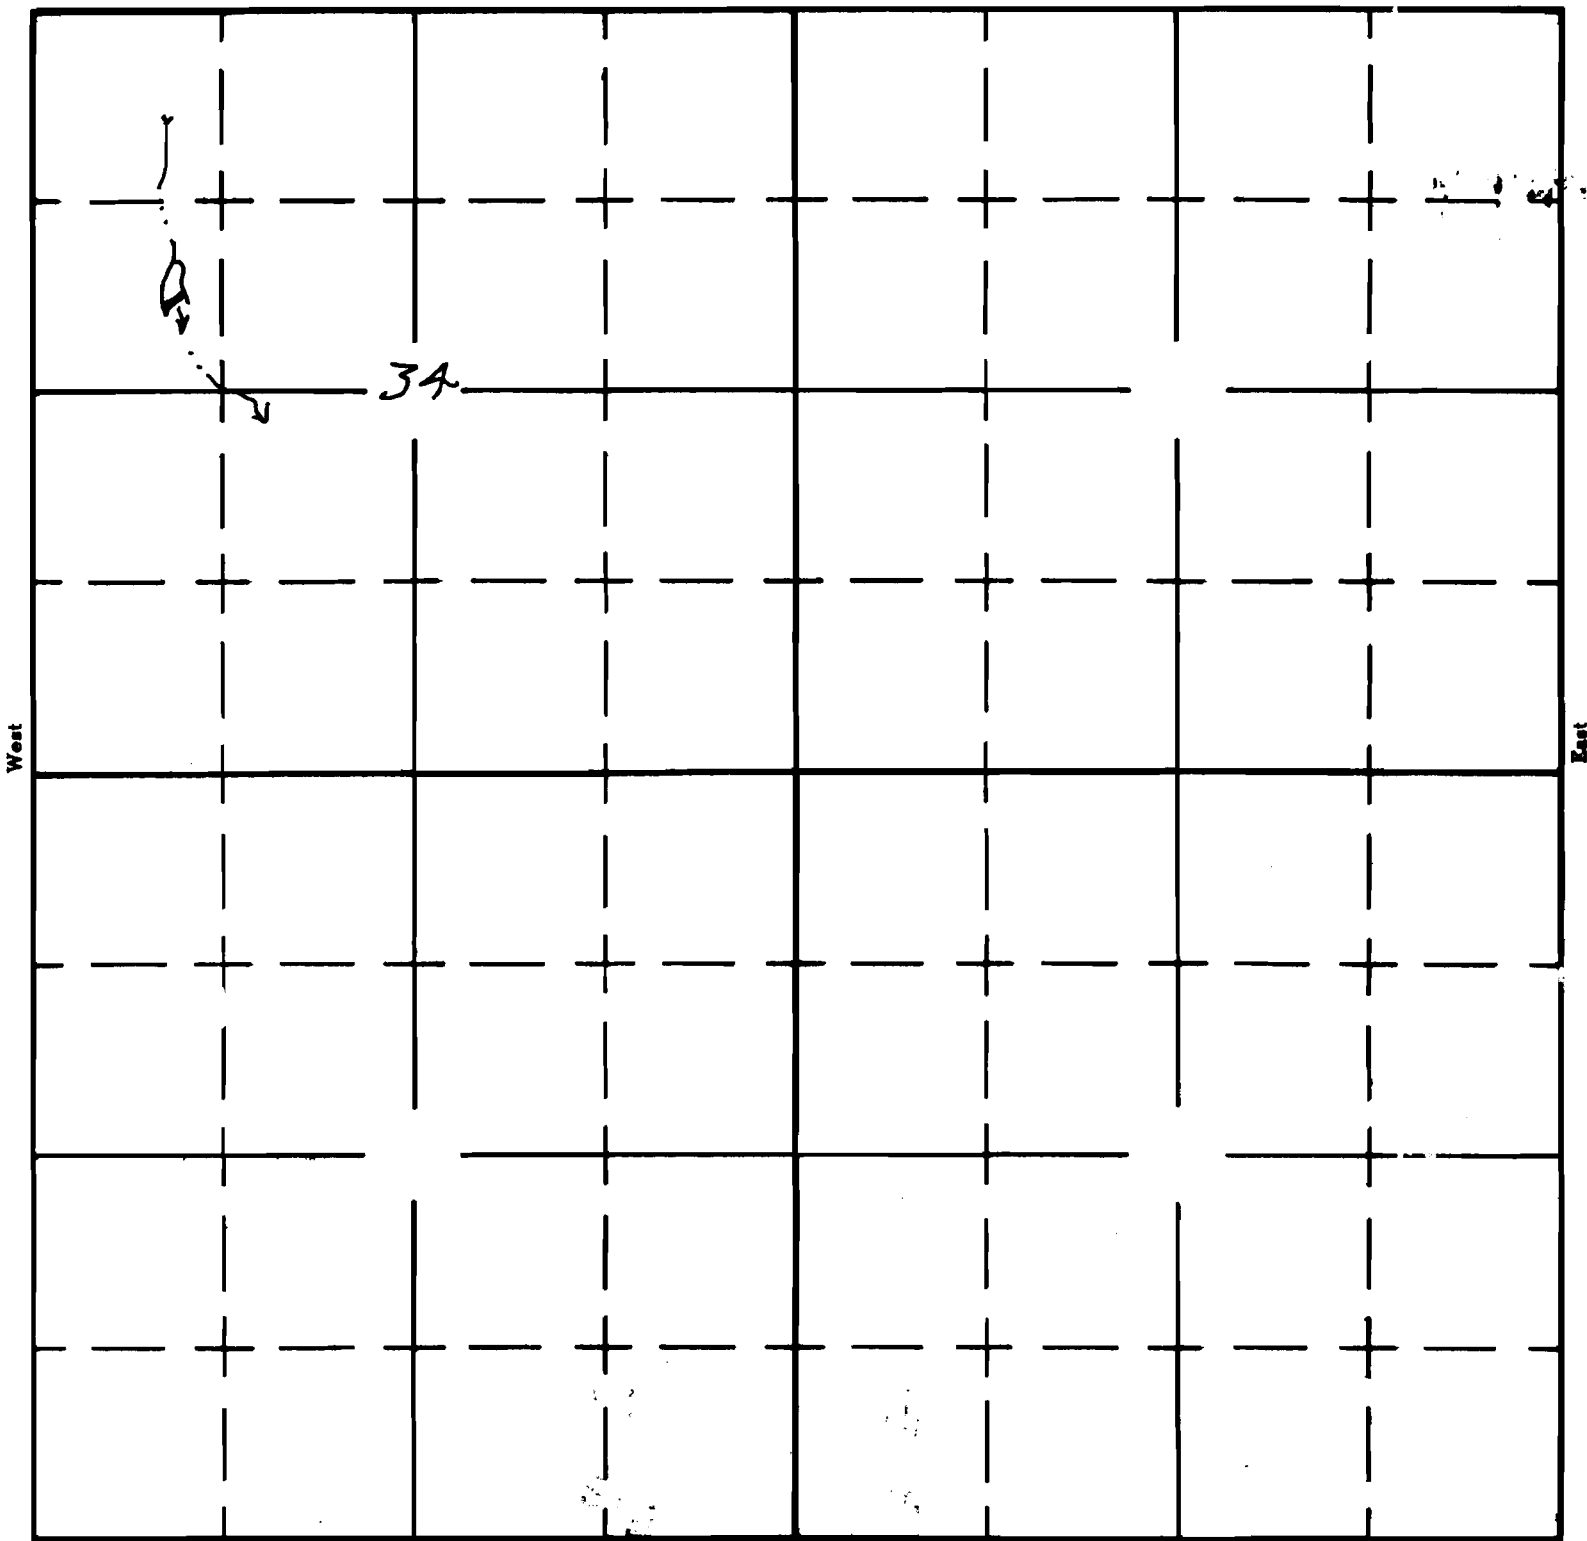

South

APPLICATION No. R-35632
PERMIT No. 6503