

Form A1-187
March 1961

UNITED STATES
DEPARTMENT OF THE INTERIOR
BUREAU OF LAND MANAGEMENT

SECTION


SW¹/₄ NW¹/₄

Oregon State Water Filings

SEC. 25

TOWNSHIP 23 S., RANGE 28 E., W. M.

North

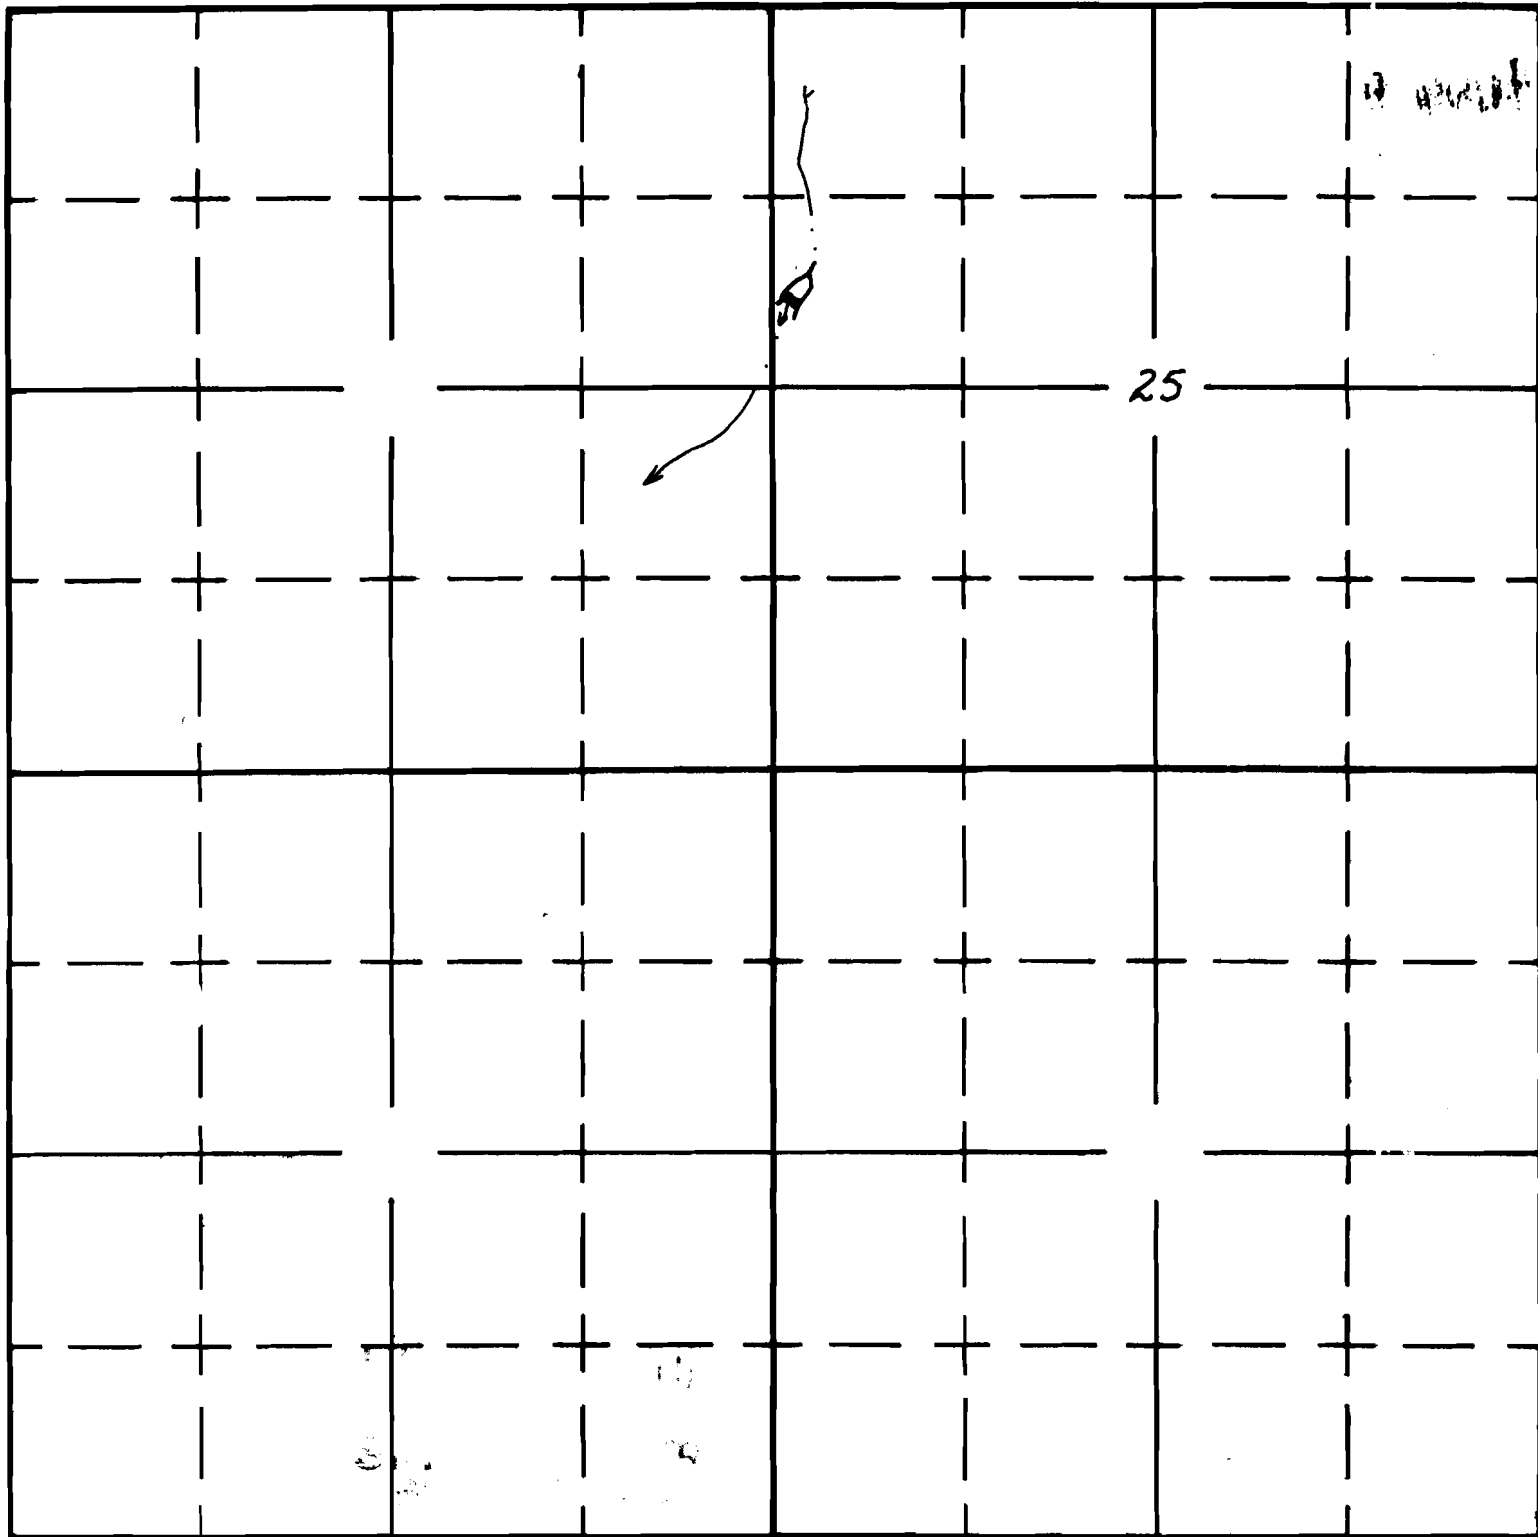

South

APPLICATION No. R-35636

PERMIT No. **H 6804**