

Form A1-187
March 1961

UNITED STATES
DEPARTMENT OF THE INTERIOR
BUREAU OF LAND MANAGEMENT

SECTION


SE $\frac{1}{4}$ NW $\frac{1}{4}$

Oregon State Water Filings

SEC. 28

TOWNSHIP 23 S, RANGE 28 E, W. M.

North

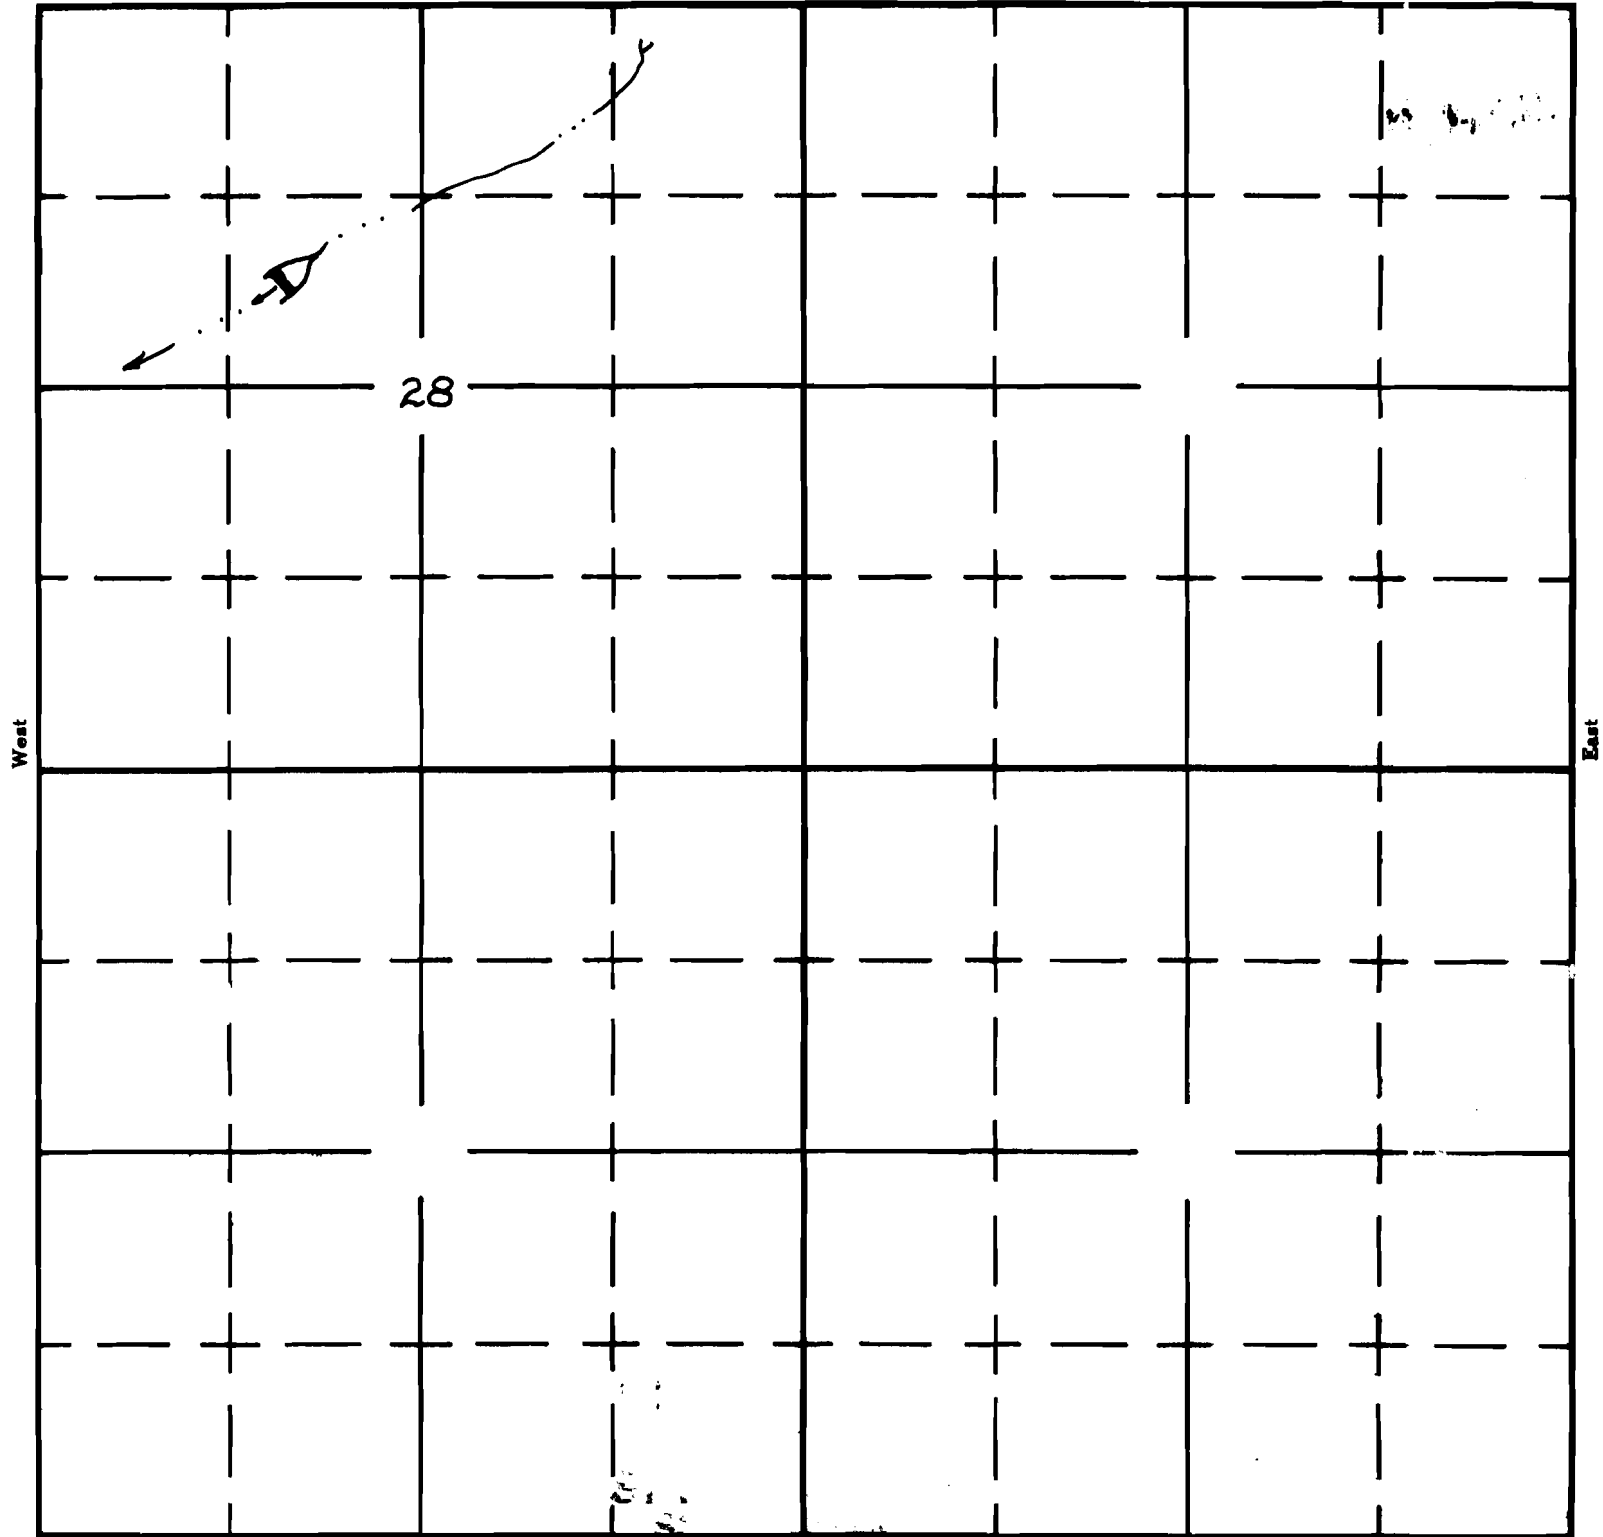

South

APPLICATION No. R-35639

PERMIT No. **A 6907**