

UNITED STATES
DEPARTMENT OF THE INTERIOR
BUREAU OF LAND MANAGEMENT

SECTION


N 1/4 SW 1/4

Oregon State Water Filings

Sec. 18

TOWNSHIP 21 S, RANGE 30 E, W. M.

North

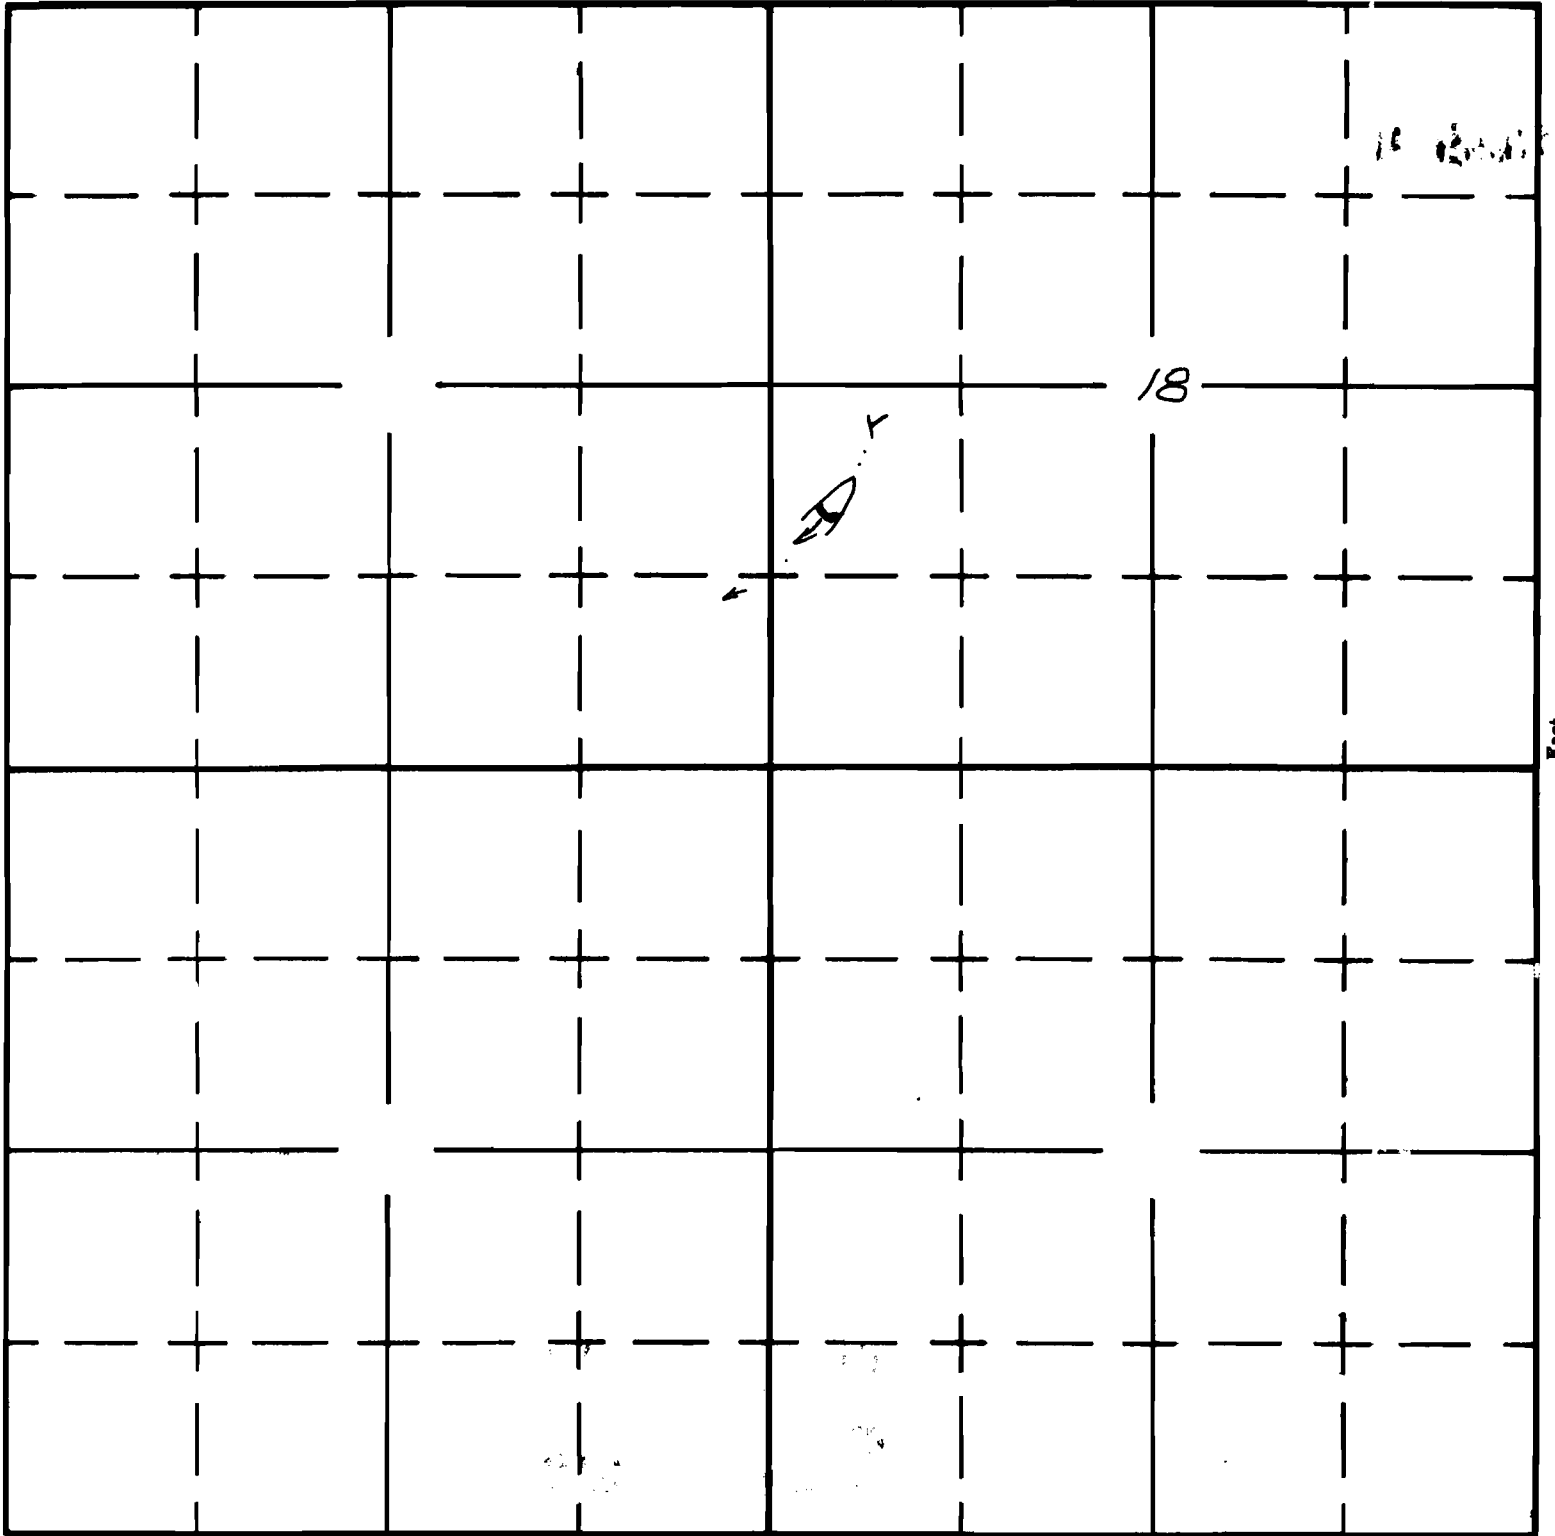

South

APPLICATION No. R-35653

PERMIT No. **6813**