

UNITED STATES
DEPARTMENT OF THE INTERIOR
BUREAU OF LAND MANAGEMENT

SECTION


NW 1/4 NW 1/4

Oregon State Water Filings

15

TOWNSHIP 27S, RANGE 23E, W. M.

North

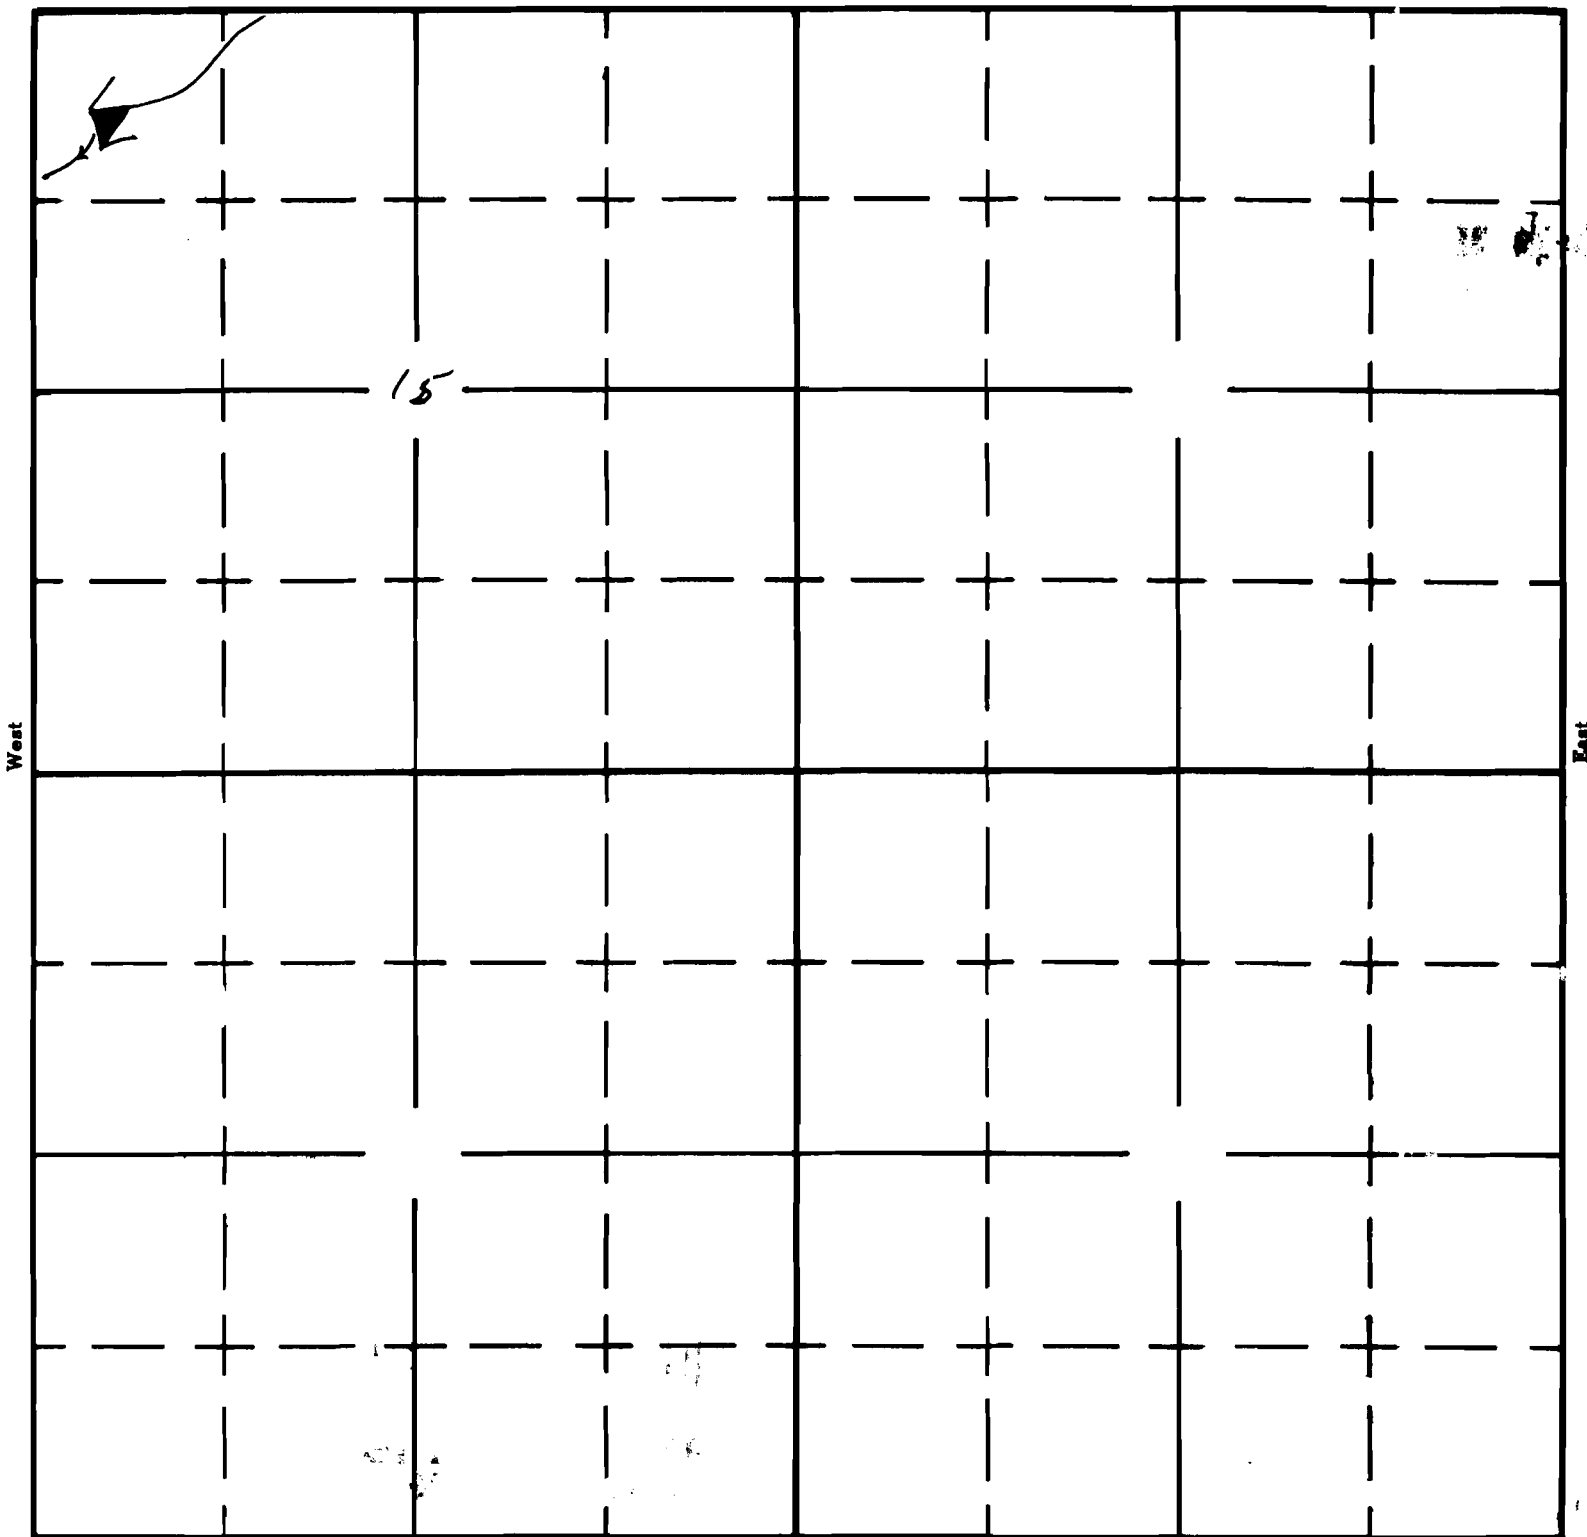

South

APPLICATION No. R-35622

PERMIT No. R 6509