

Form AI-187
March 1961


UNITED STATES
DEPARTMENT OF THE INTERIOR
BUREAU OF LAND MANAGEMENT

SECTION

NW 1/4 Sec 30 Oregon State Water Filings

30 TOWNSHIP 26 S, RANGE 24 E, W. M.

North

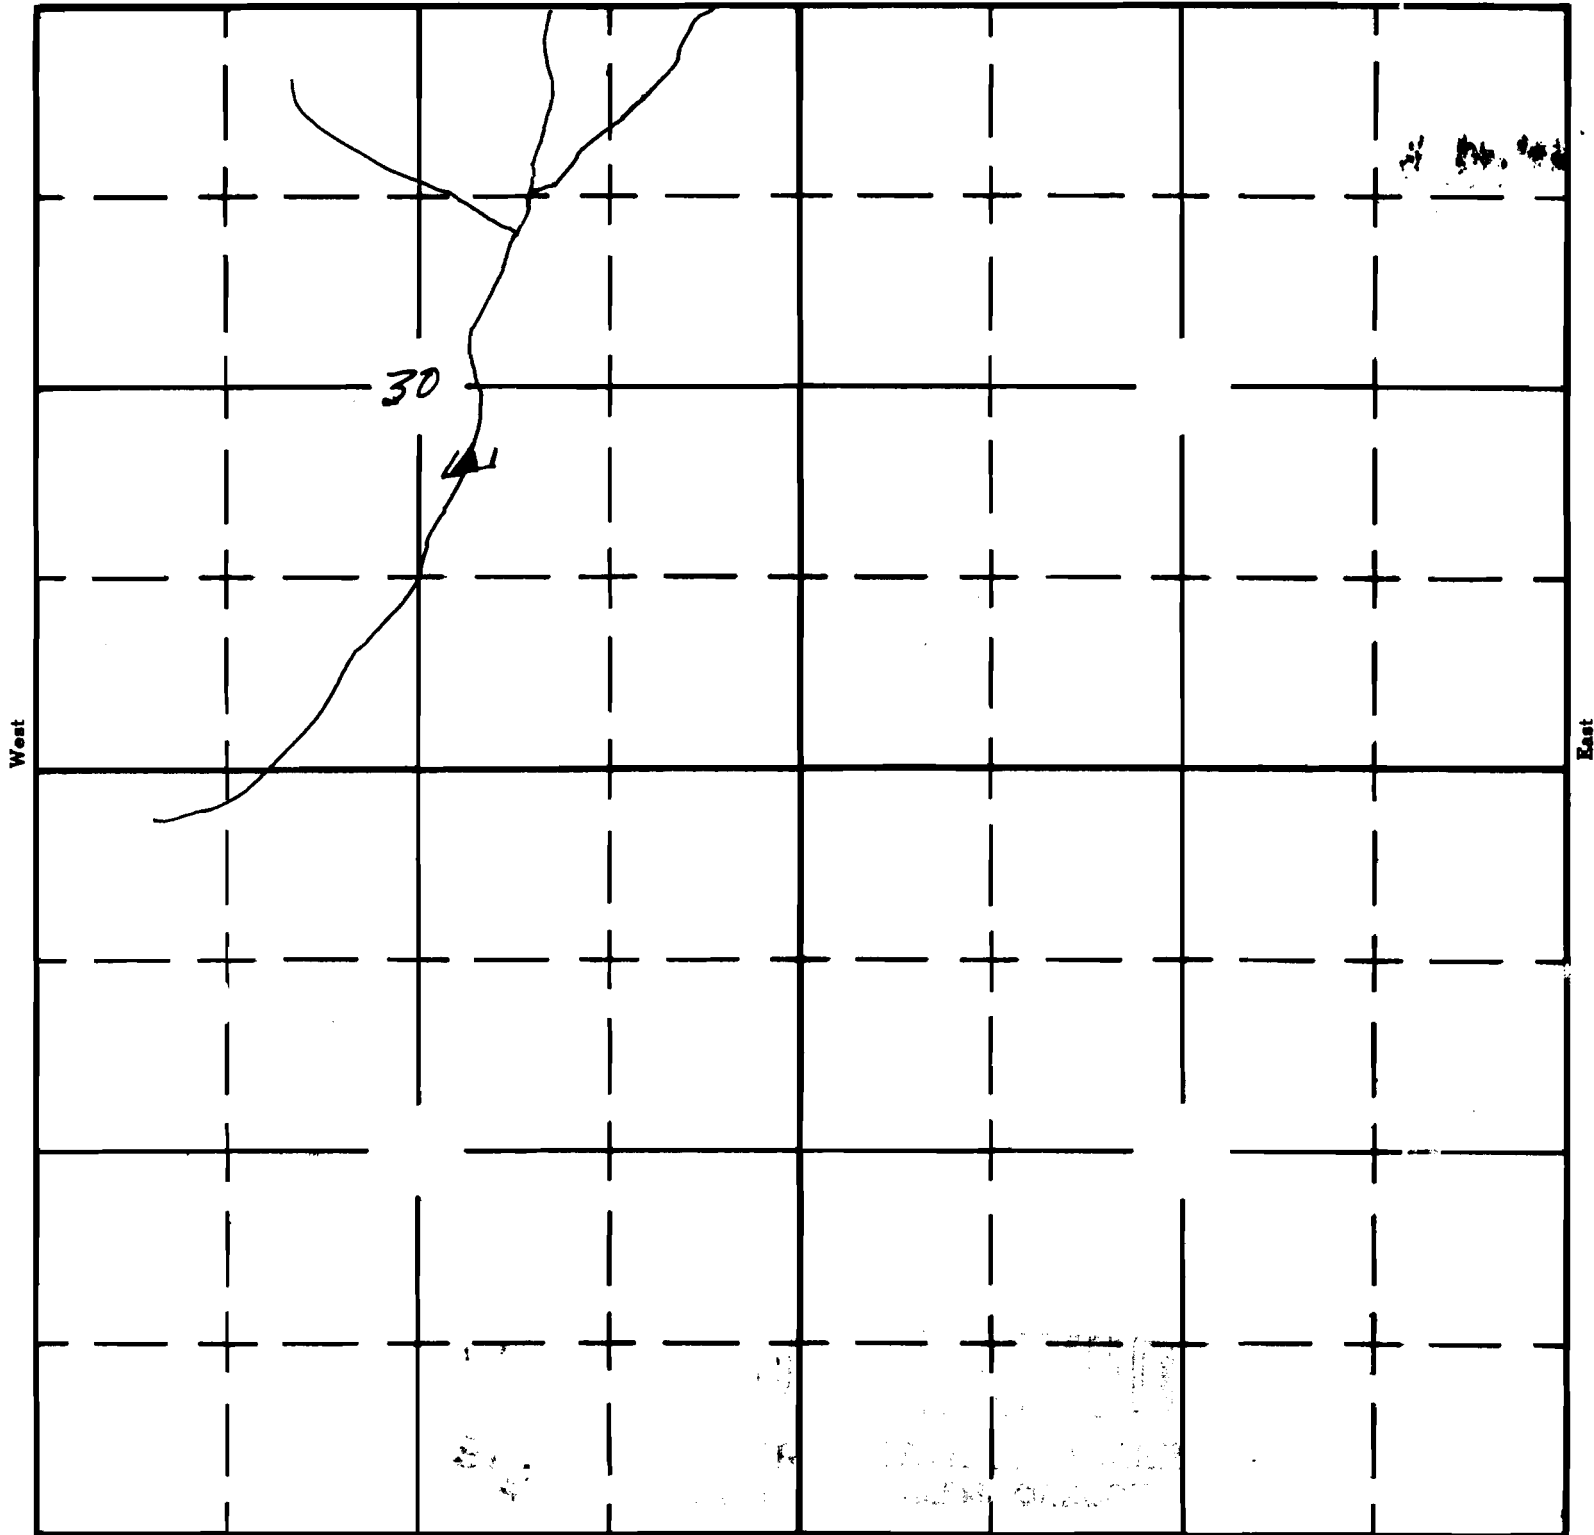

South

APPLICATION No. R-35625

PERMIT No. 12731