

Form A1-187
March 1961

UNITED STATES
DEPARTMENT OF THE INTERIOR
BUREAU OF LAND MANAGEMENT

SECTION


Oregon State Water Filings

SE 1/4 SW 1/4

TOWNSHIP 24S, RANGE 36E, W. M.

Sec 33

North

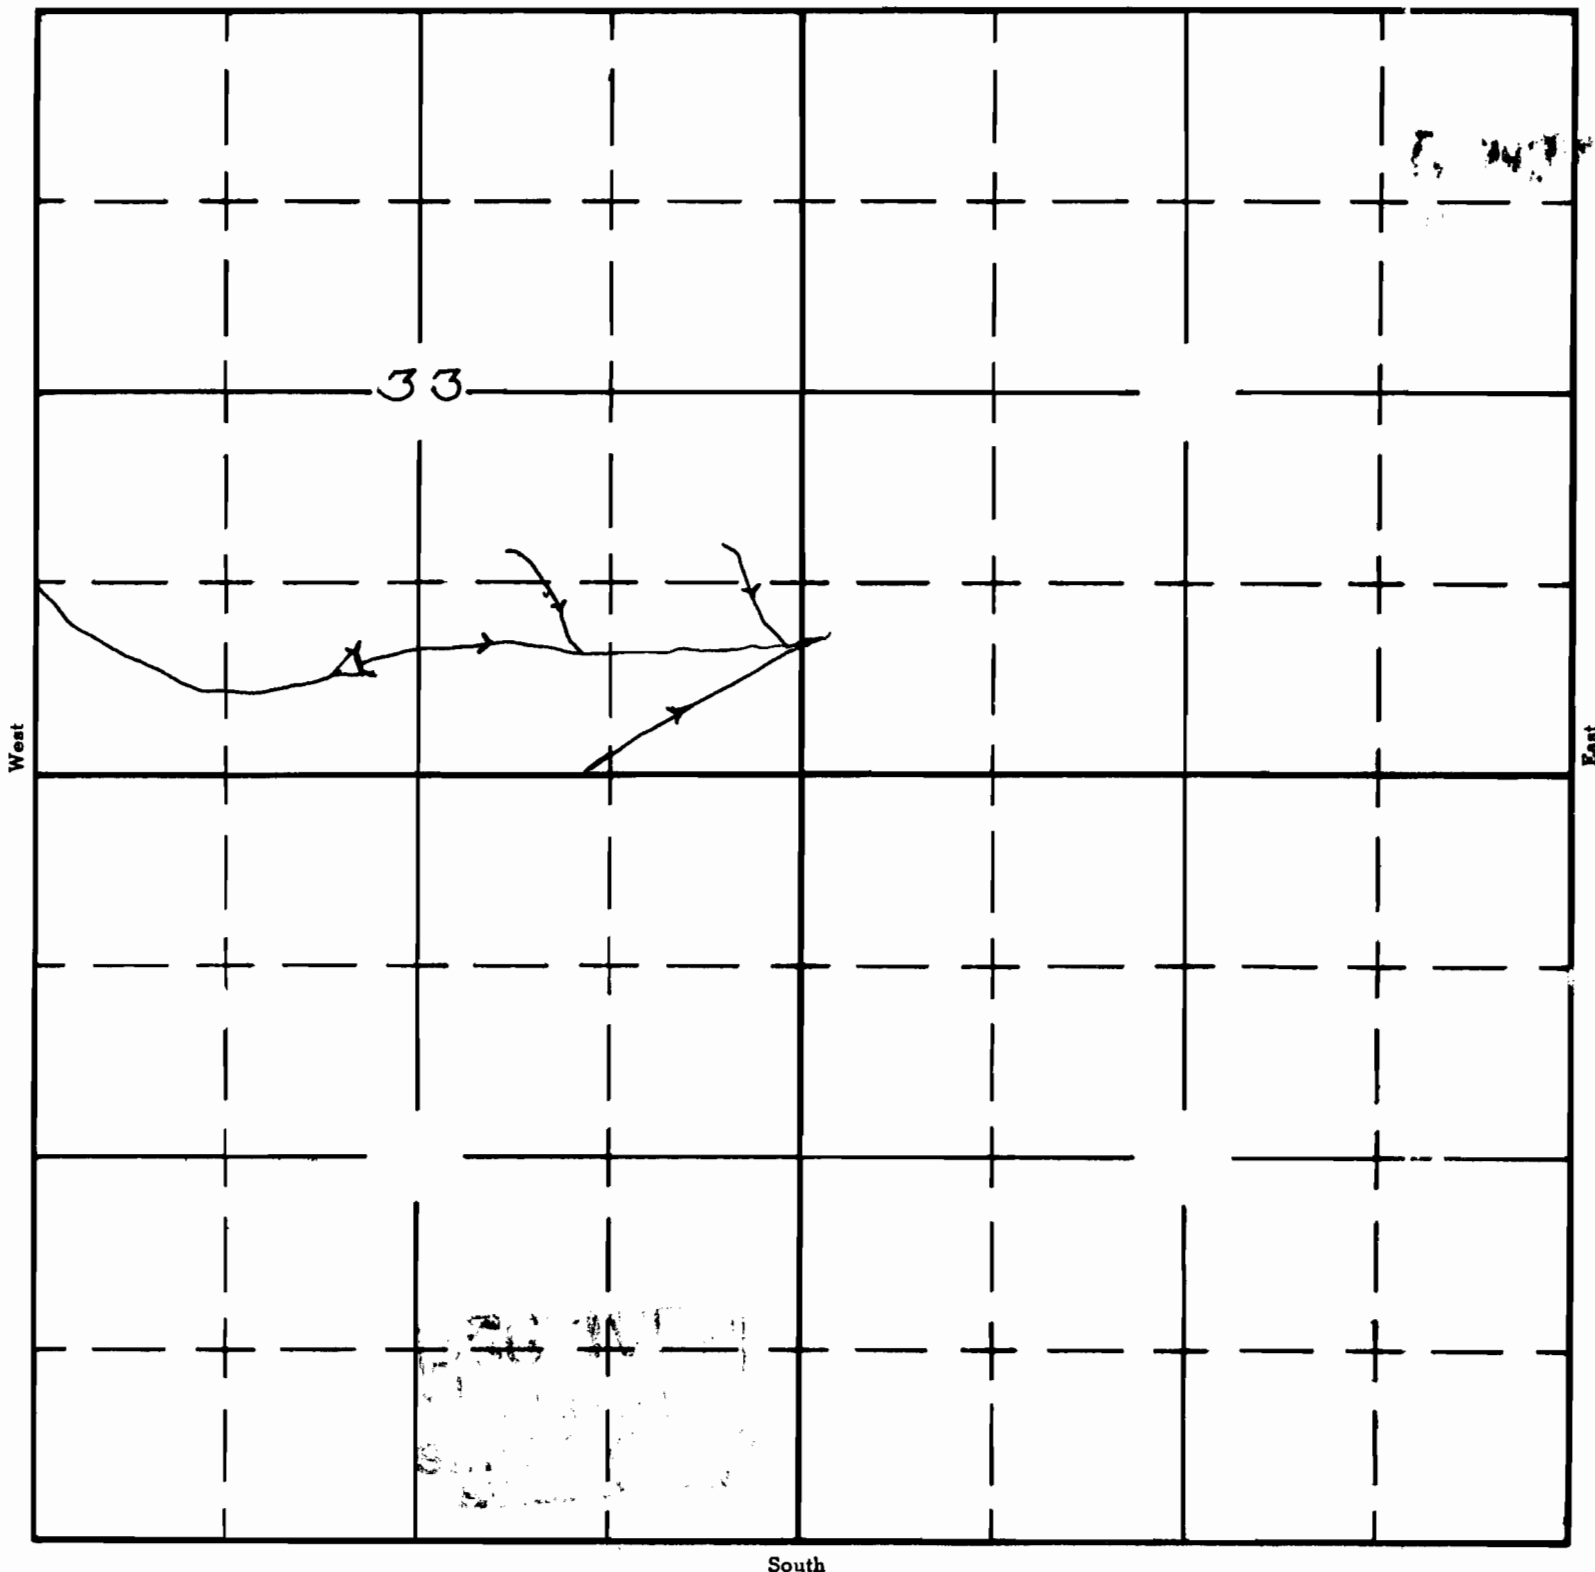

South

APPLICATION No. R-35830
PERMIT No. 6892