

T. 11. S. R. 11 W. W. M.

I. H. M. Teel of Toledo, Oregon do hereby certify that this map was made from notes taken by me during an actual survey made by me on June 14, 1928, and that it correctly represents the work described in the accompanying application, together with the location of streams and other ditches in the immediate vicinity.

*H. M. Teel*


Registered Professional Engineer

Oregon No. 1013


Date of Registration

May 8 1920

Scale 4" = 1 mi.

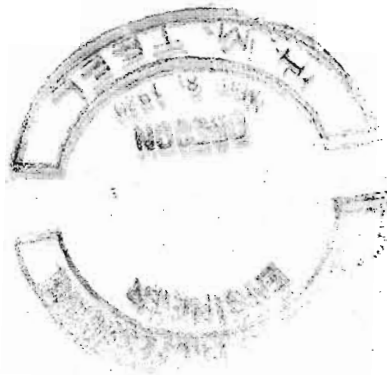

N

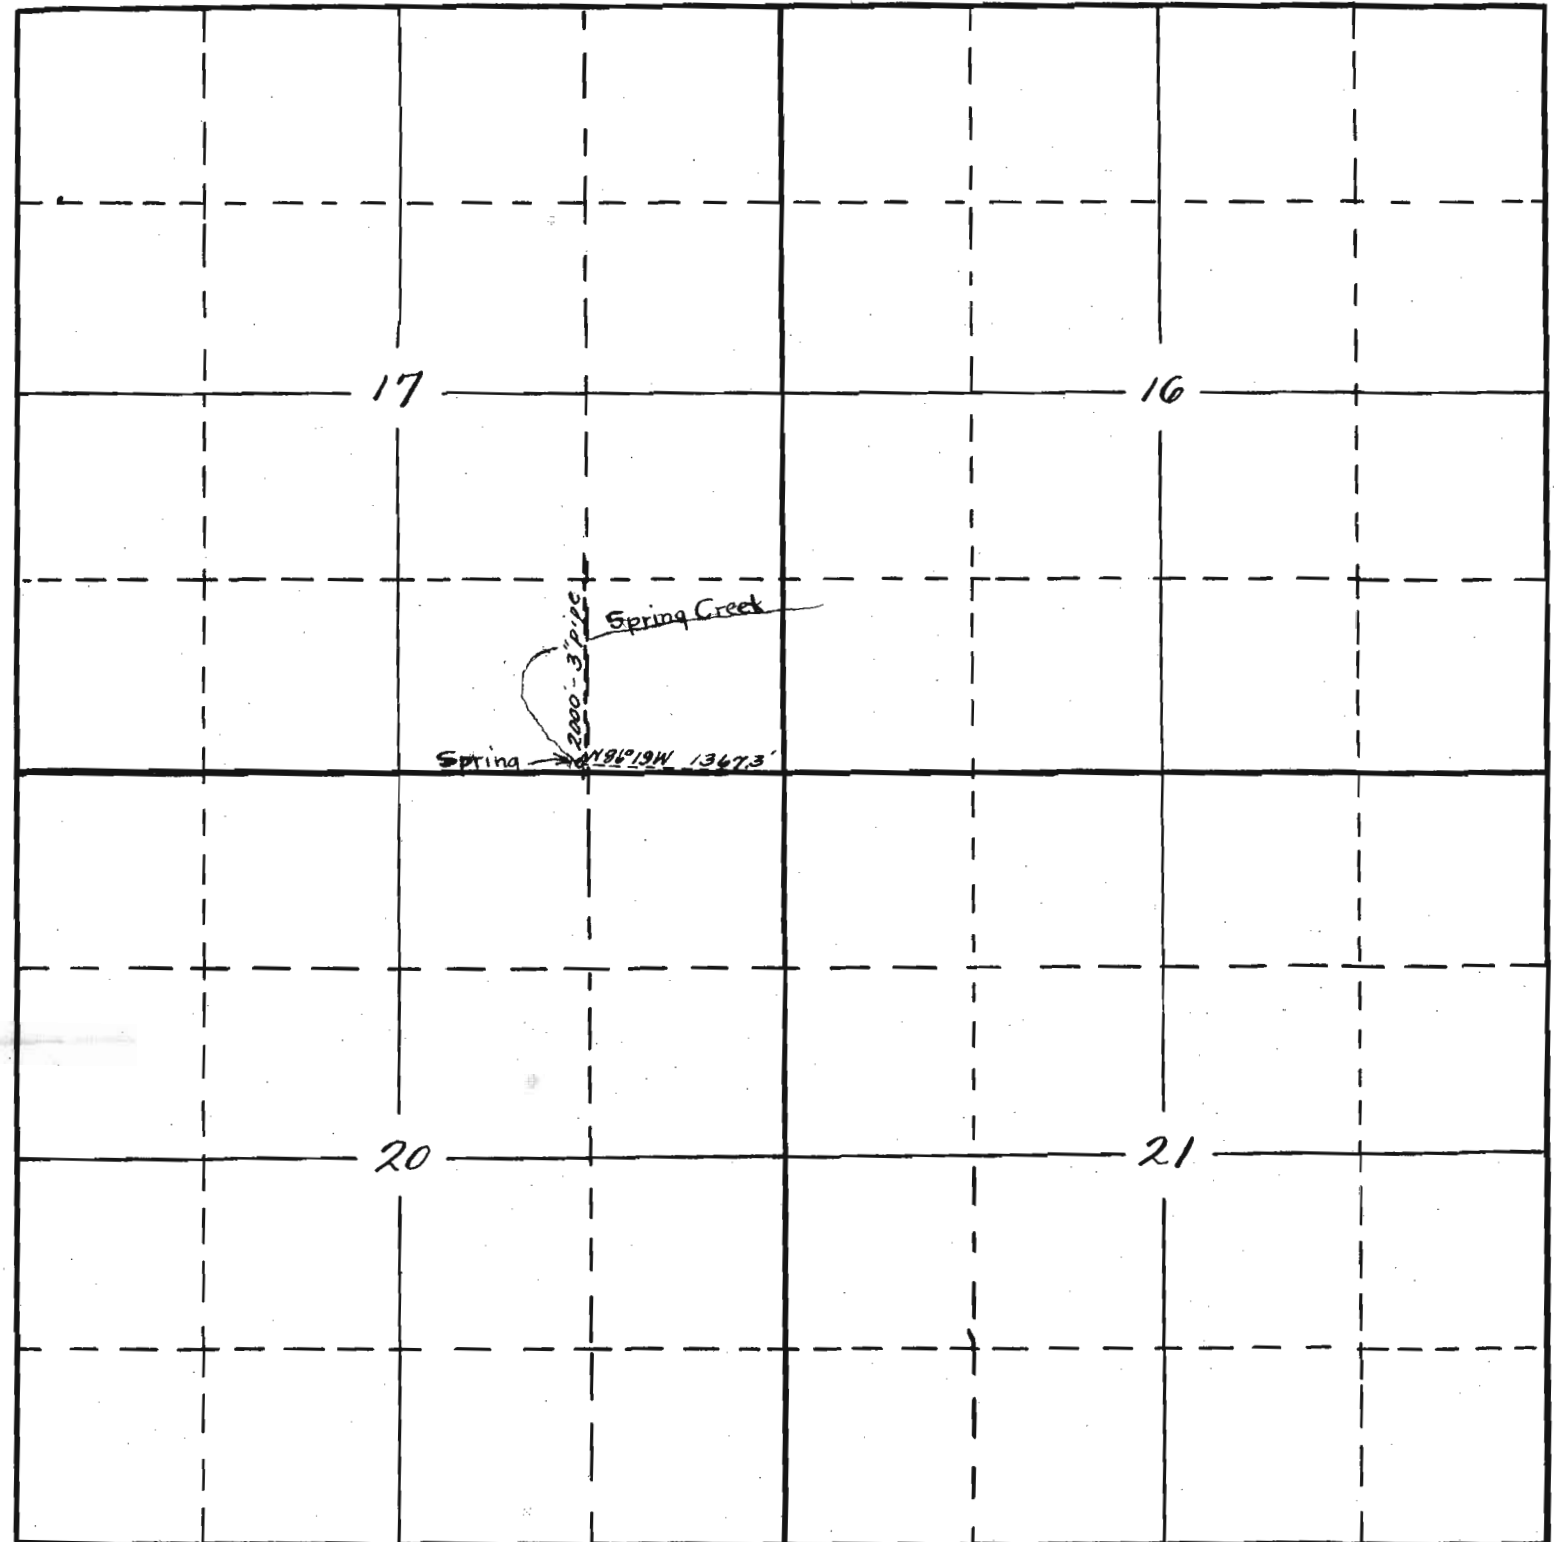

Application No. 12145

Permit No. 8540