

UNITED STATES
DEPARTMENT OF THE INTERIOR
BUREAU OF LAND MANAGEMENT

SECTION


Oregon State Water Filings

SE 1/4 SW 1/4

TOWNSHIP 28_S, RANGE 35_E, W. M.

Sec 8

North

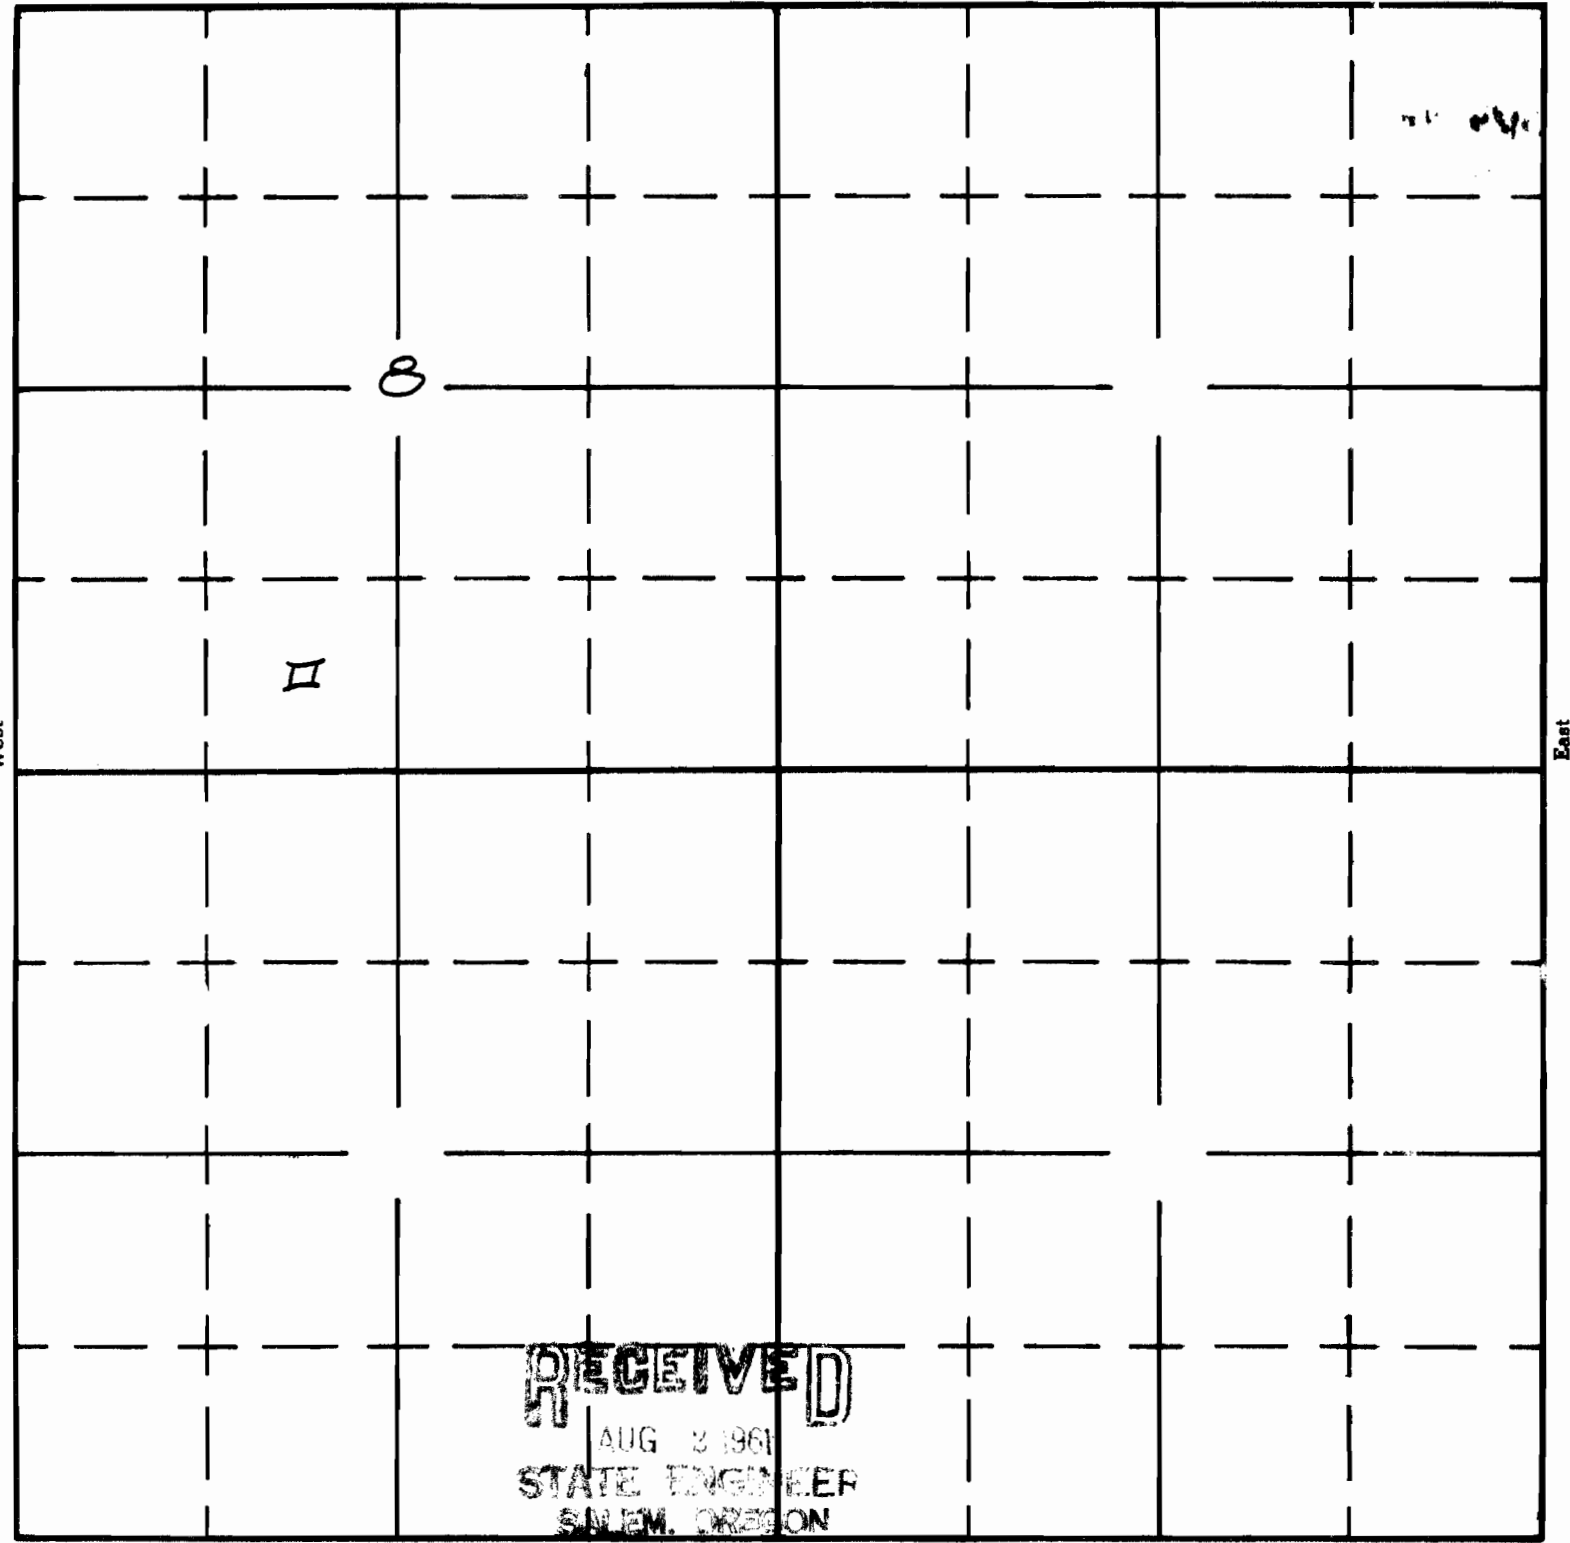

RECEIVED
AUG 2 1961
STATE ENGINEER
SALEM, OREGON

APPLICATION No. R-36015
PERMIT No. R-6200