

UNITED STATES
DEPARTMENT OF THE INTERIOR
BUREAU OF LAND MANAGEMENT

SECTION


Oregon State Water Filings

SE 1/4 NW 1/4

TOWNSHIP 28 S, RANGE 36 E, W. M.

Sec 18

North

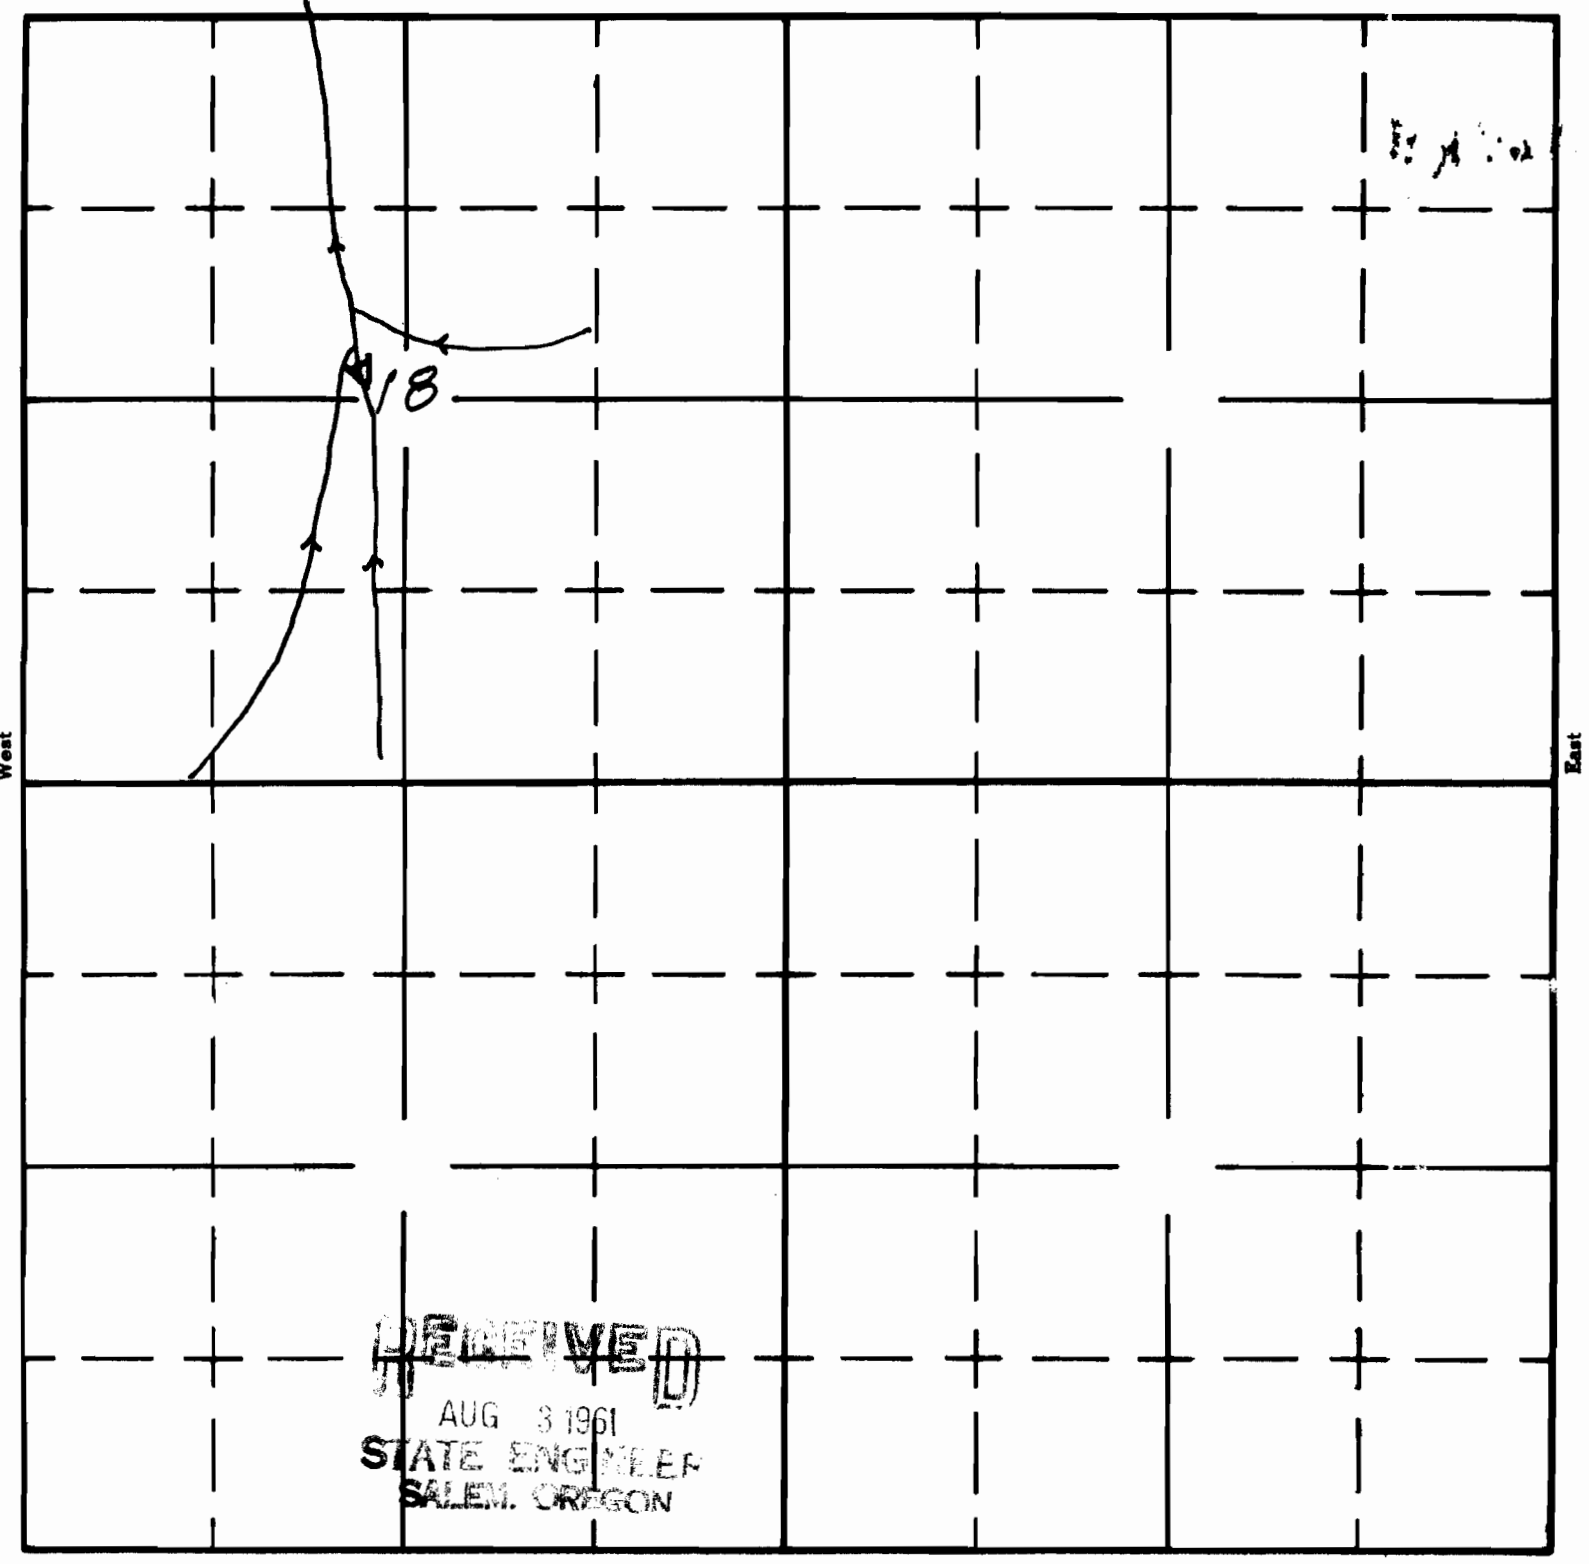

RECEIVED
AUG 3 1961
STATE ENGINEER
SALEM, OREGON

South

APPLICATION No. R-36071

PERMIT No. 36071