

Form AI-187
March 1961

UNITED STATES
DEPARTMENT OF THE INTERIOR
BUREAU OF LAND MANAGEMENT


SECTION

SE 1/4 SE 1/4
25

Oregon State Water Filings

TOWNSHIP 20S, RANGE 36E, W. M.

North

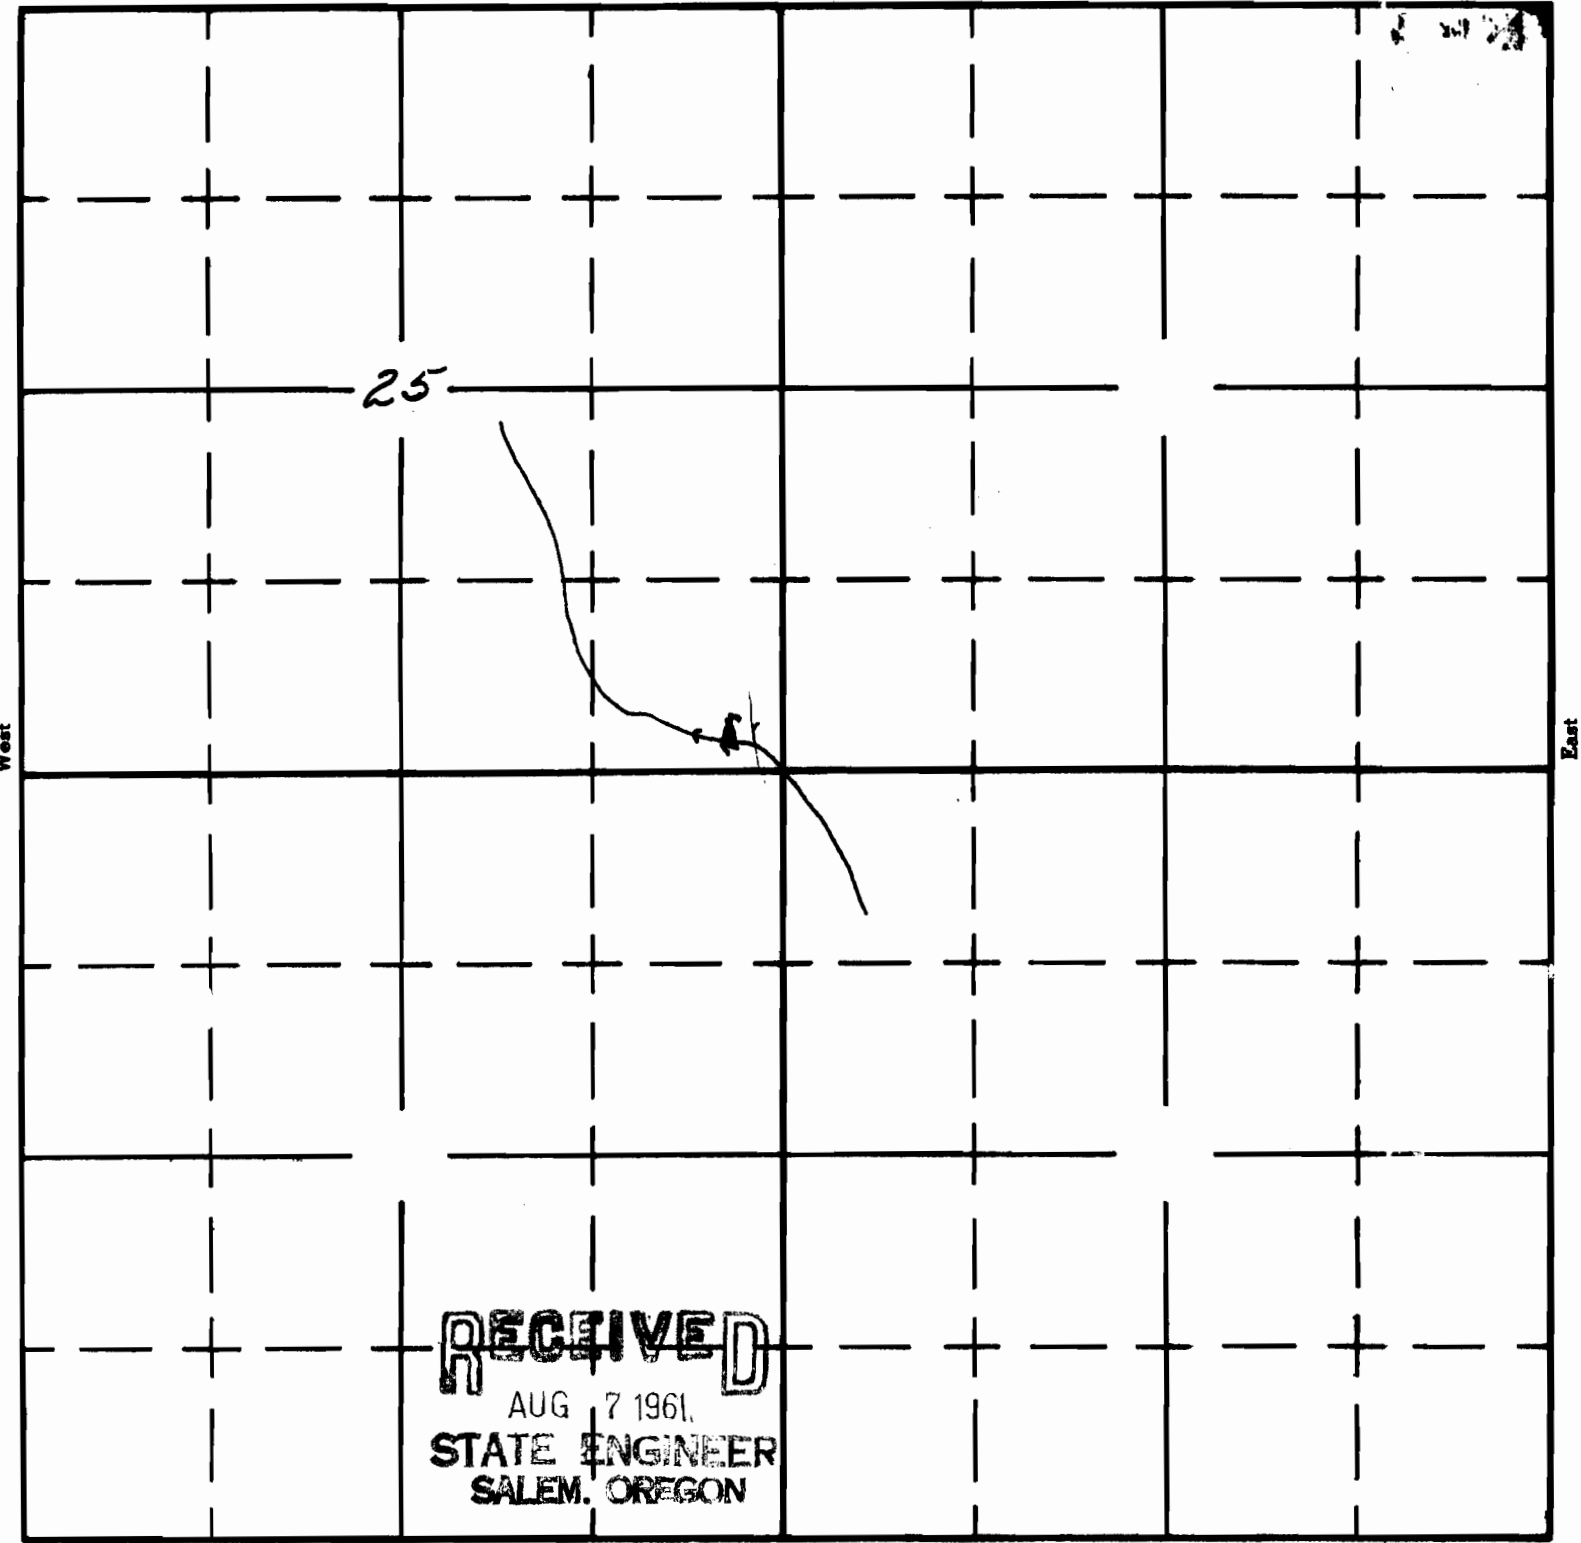

RECEIVED
AUG 7 1961
STATE ENGINEER
SALEM, OREGON

South

APPLICATION No. R-36107

PERMIT No. 4 9904