

Form AI-187
March 1961

UNITED STATES
DEPARTMENT OF THE INTERIOR
BUREAU OF LAND MANAGEMENT

SECTION


NE 1/4 SW 1/4

Oregon State Water Filings

SFC 11

TOWNSHIP 27S, RANGE 24E, W. M.

North

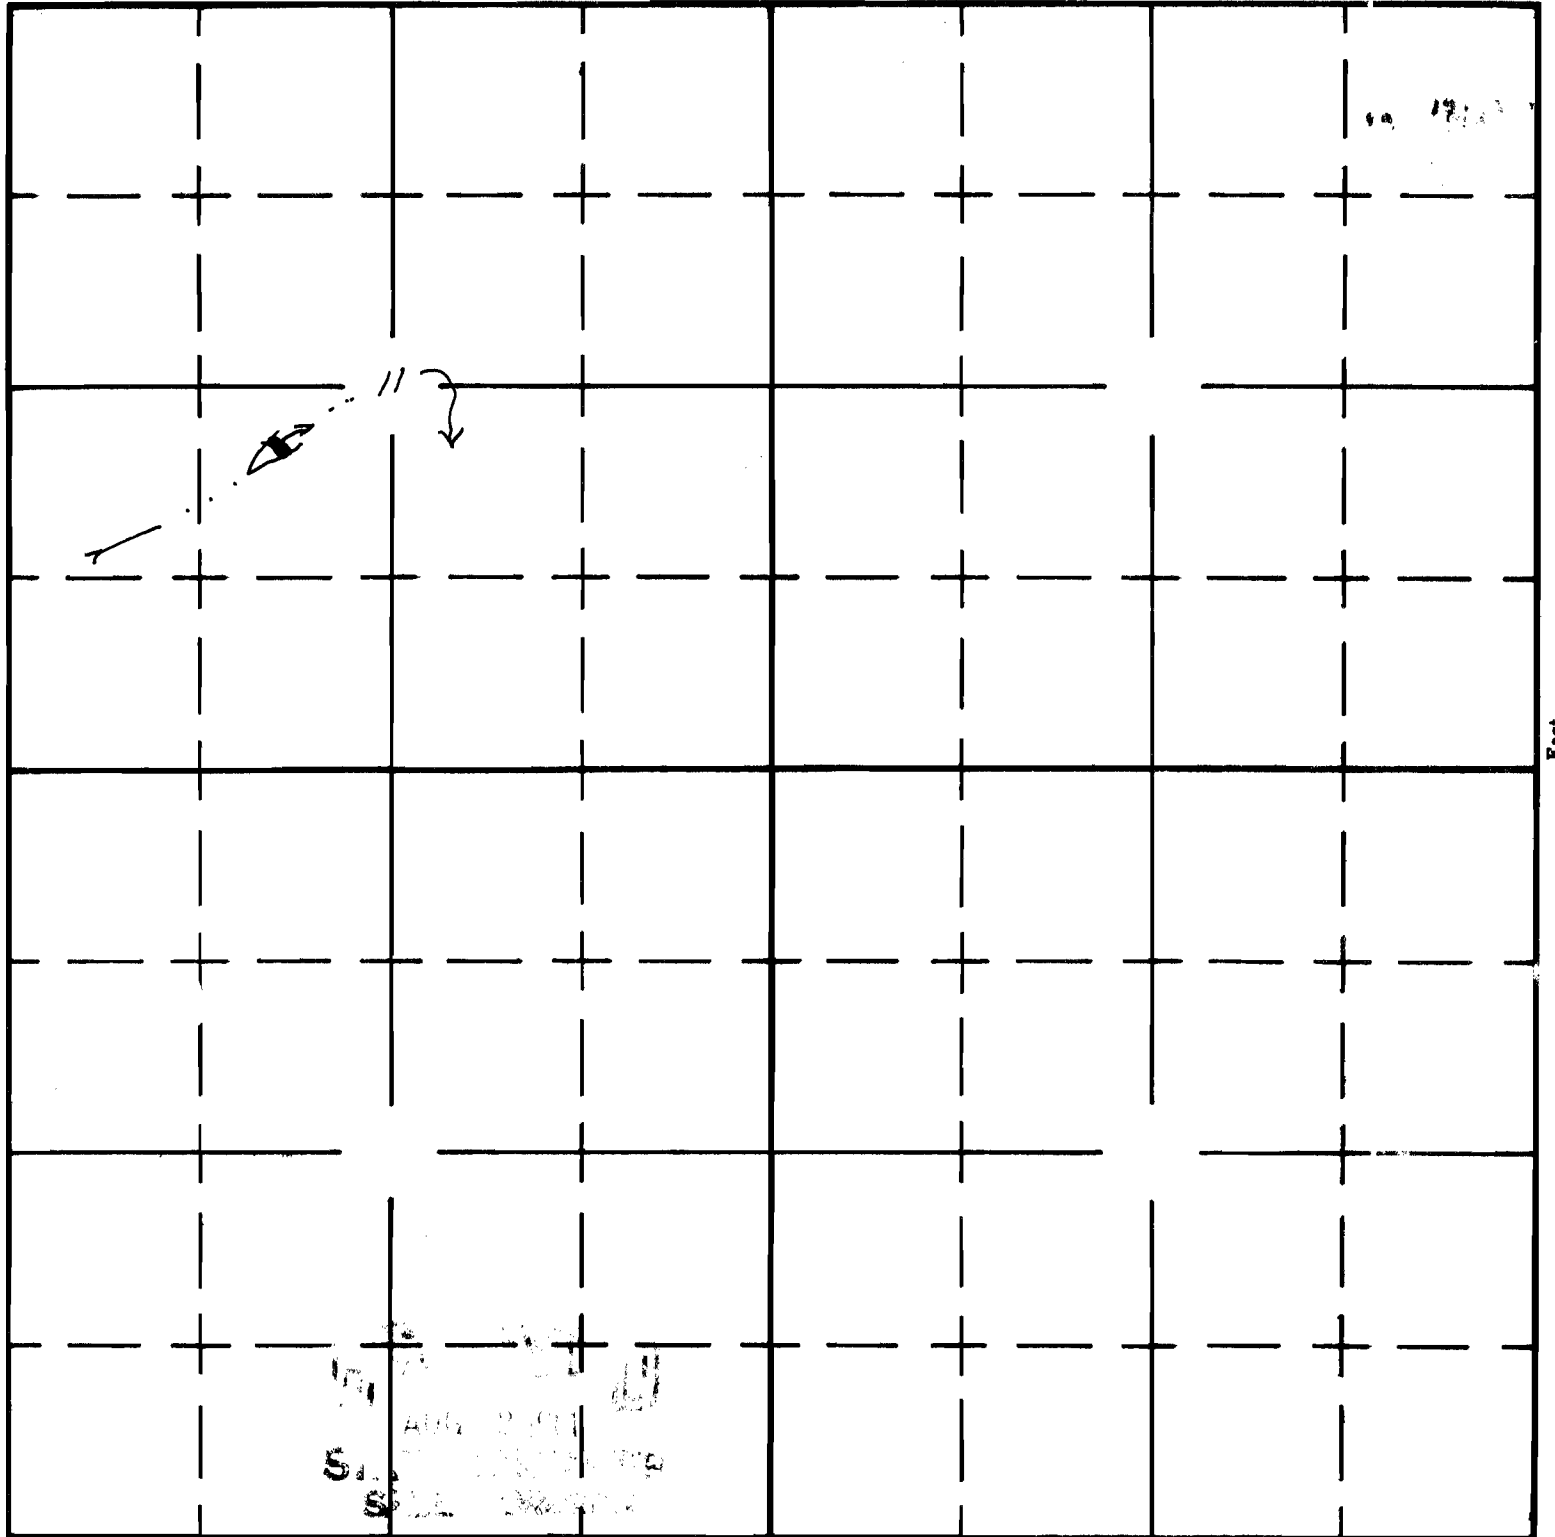

South

APPLICATION No. R-36033

PERMIT No. **R 6911**