


Form AI-187
March 1961

UNITED STATES
DEPARTMENT OF THE INTERIOR
BUREAU OF LAND MANAGEMENT

SECTION
SW 1/4 NE 1/4
SFC 28

Oregon State Water Filings

TOWNSHIP 29 S, RANGE 29 1/2 E, W. M.

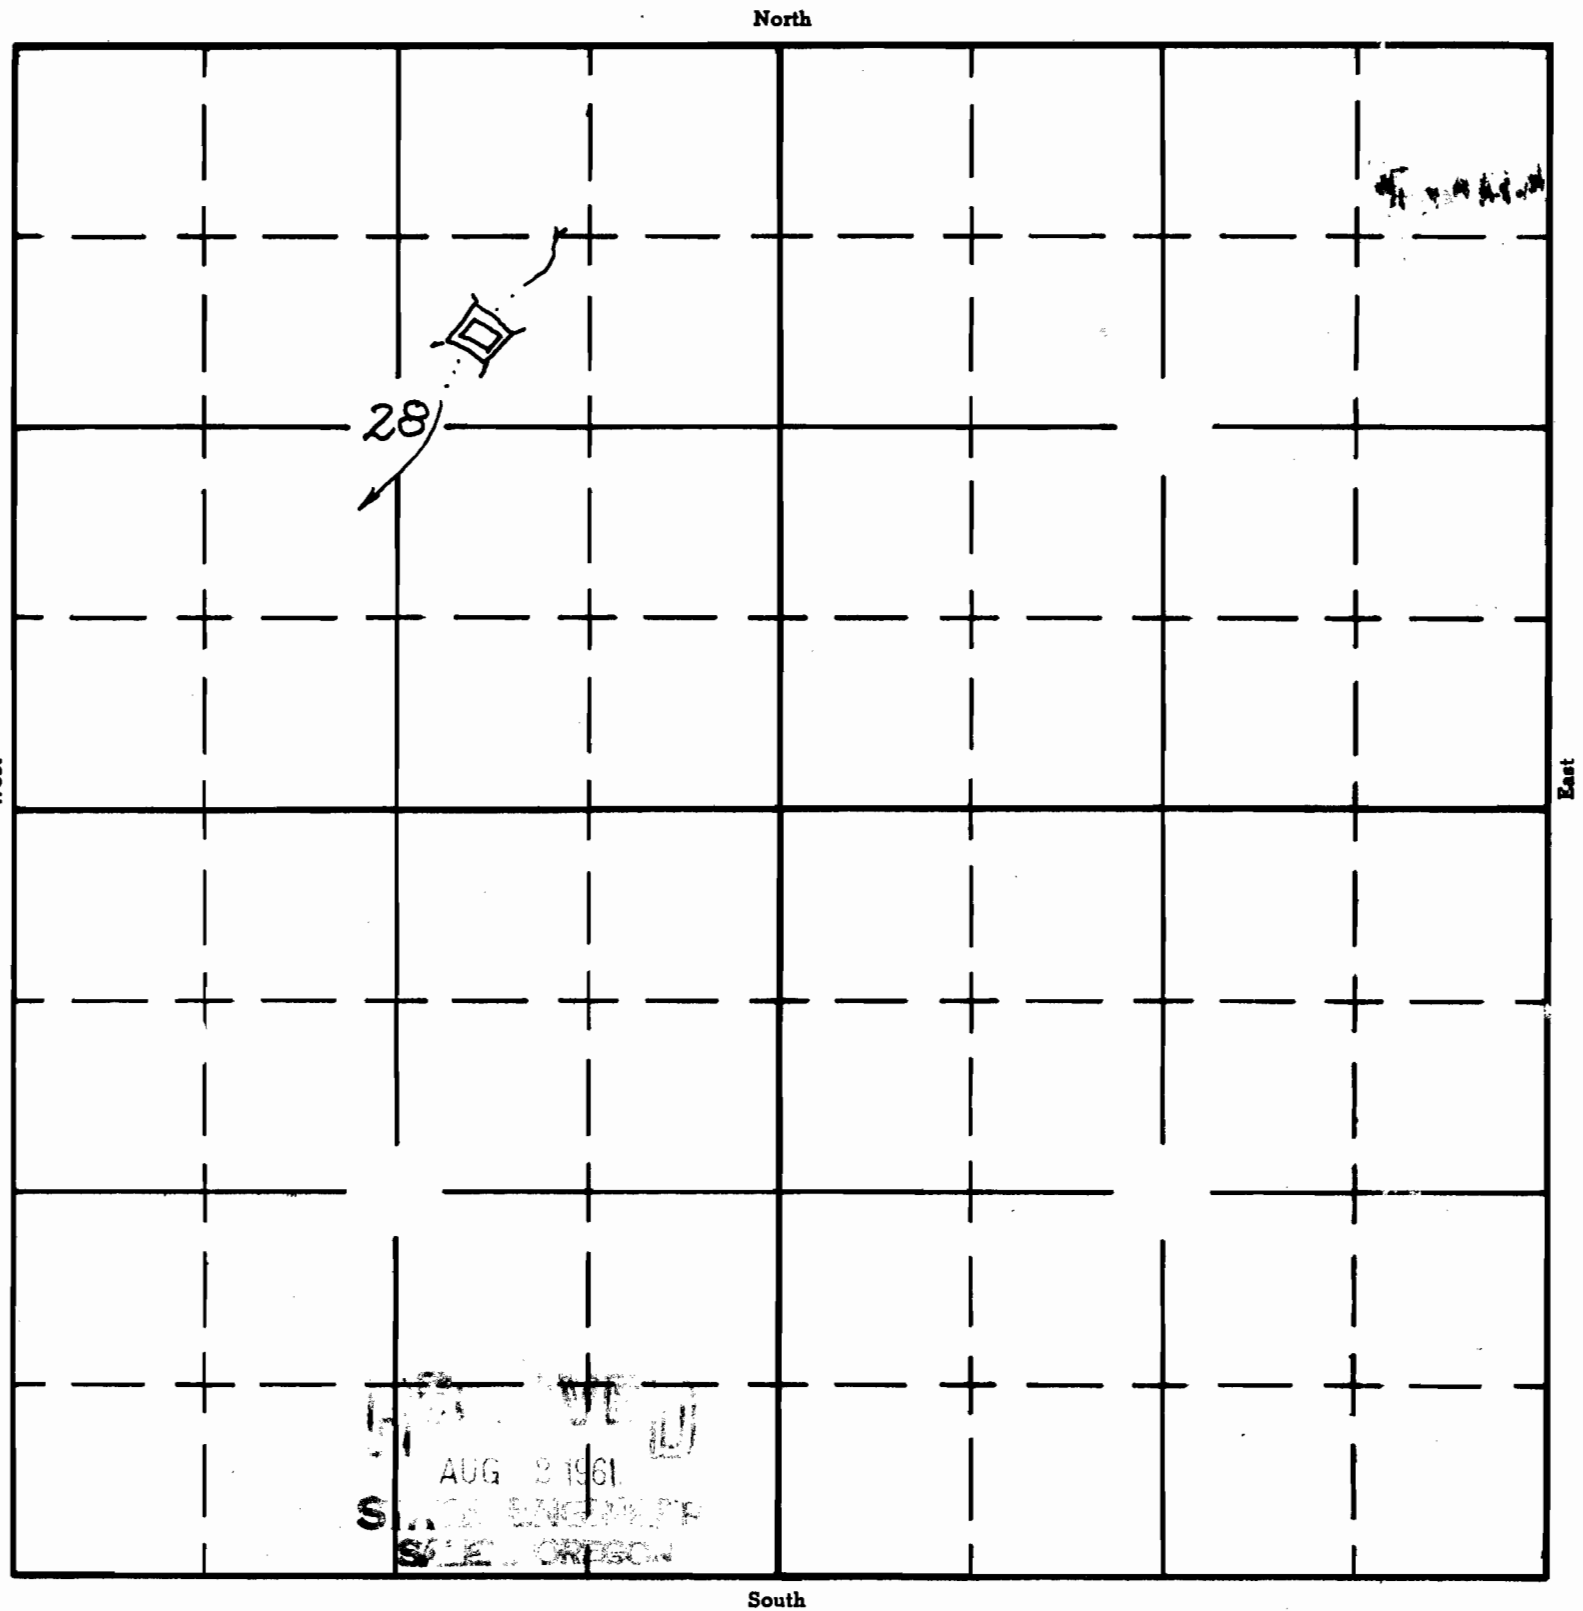

AUG 2 1961
S. C. ENGINEER
STATE OF OREGON

APPLICATION No. R-36042

PERMIT No. 16