

Form AI-187
March 1961

UNITED STATES
DEPARTMENT OF THE INTERIOR
BUREAU OF LAND MANAGEMENT


SECTION

Oregon State Water Filings

W 1/2 NW 1/4
Sec 17
E 1/2 NE 1/4
Sec 18

TOWNSHIP 29 S, RANGE 29 1/2 W. M.

North

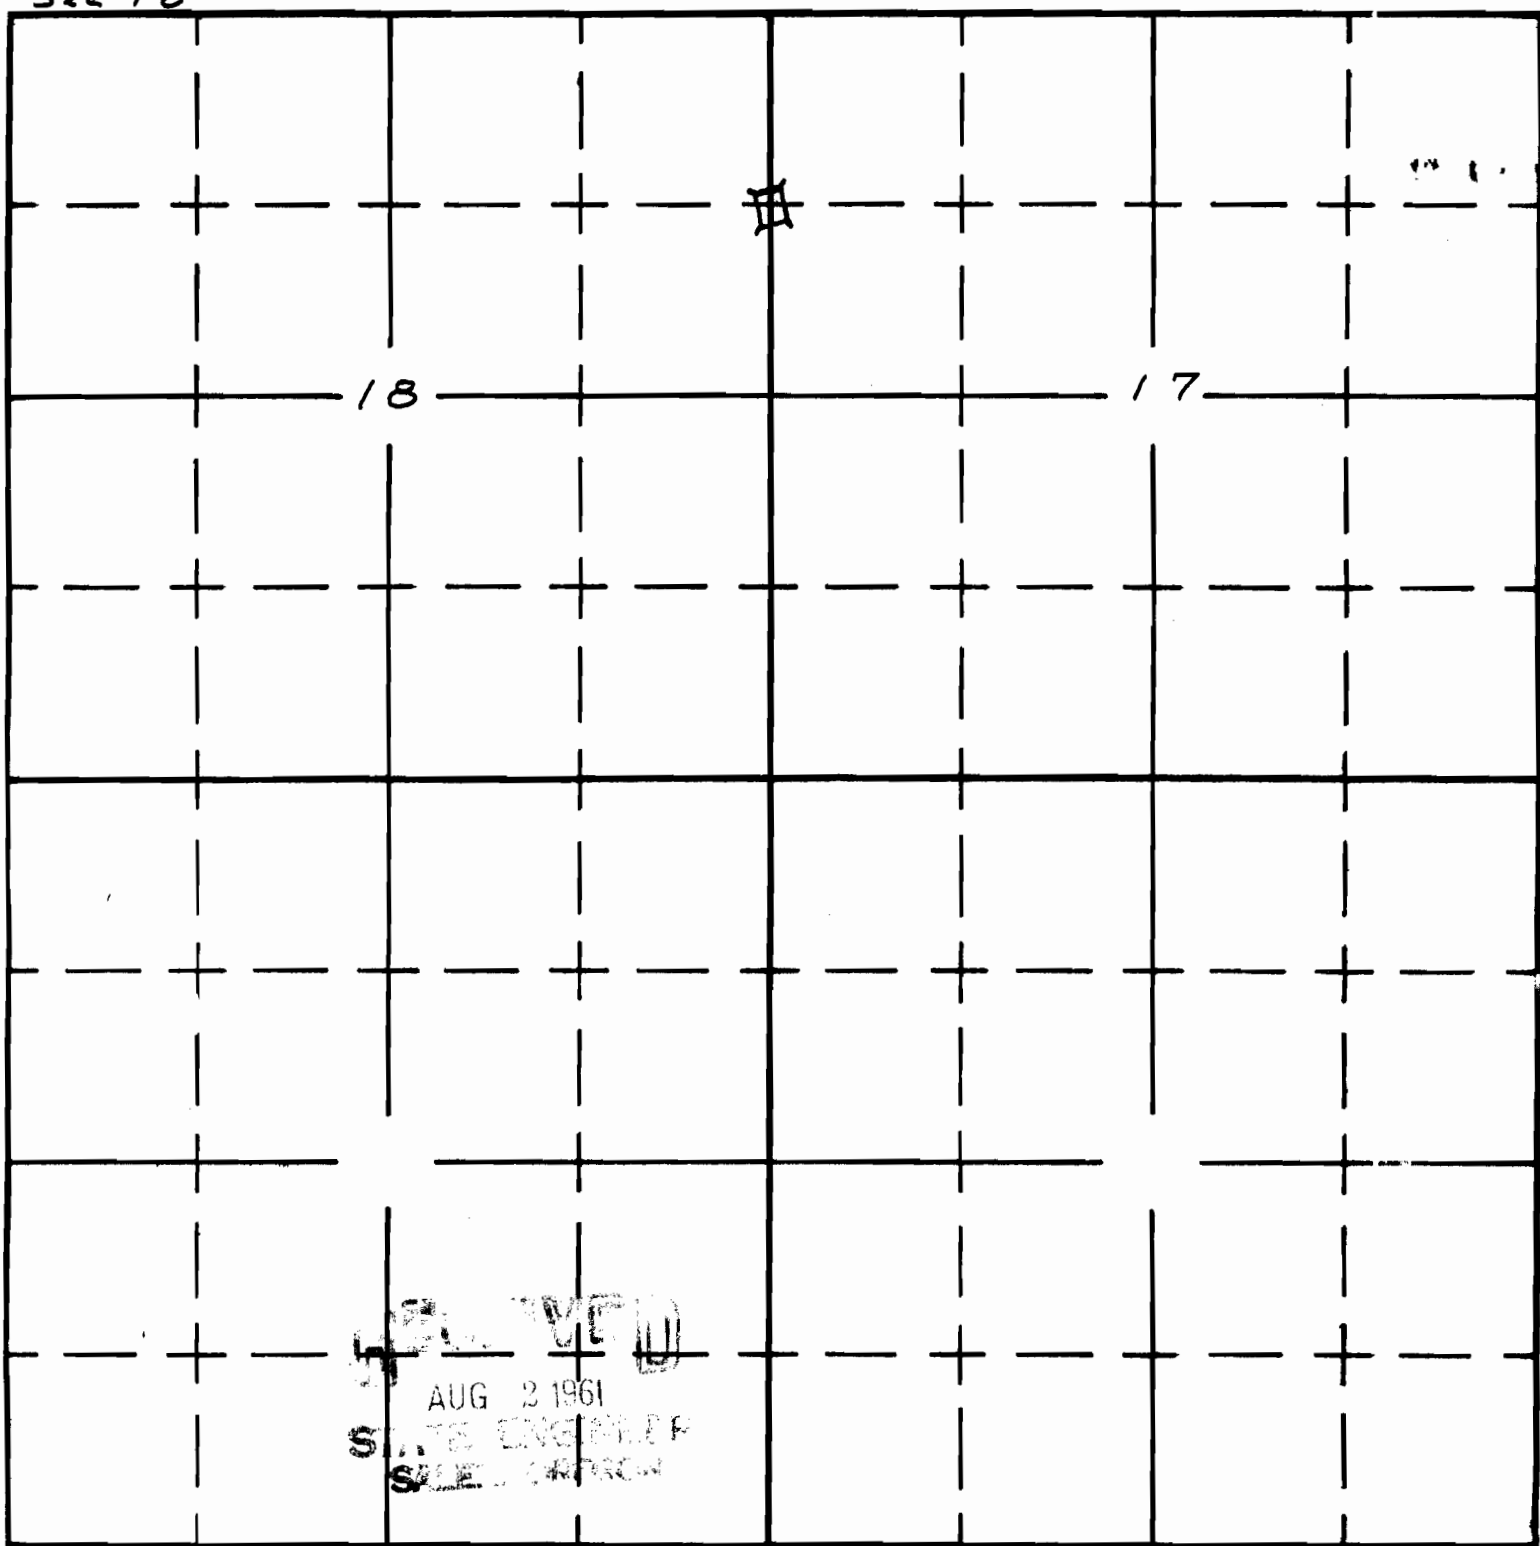

RECEIVED
AUG 2 1961
STATE ENGINEER
SALE OFFICE

South

APPLICATION No. R-36045

