

Form AI-187
March 1961


UNITED STATES
DEPARTMENT OF THE INTERIOR
BUREAU OF LAND MANAGEMENT

SECTION
SW $\frac{1}{4}$ SE $\frac{1}{4}$
SEC. 9

Oregon State Water Filings

TOWNSHIP 29 S, RANGE 33 E, W. M.

North

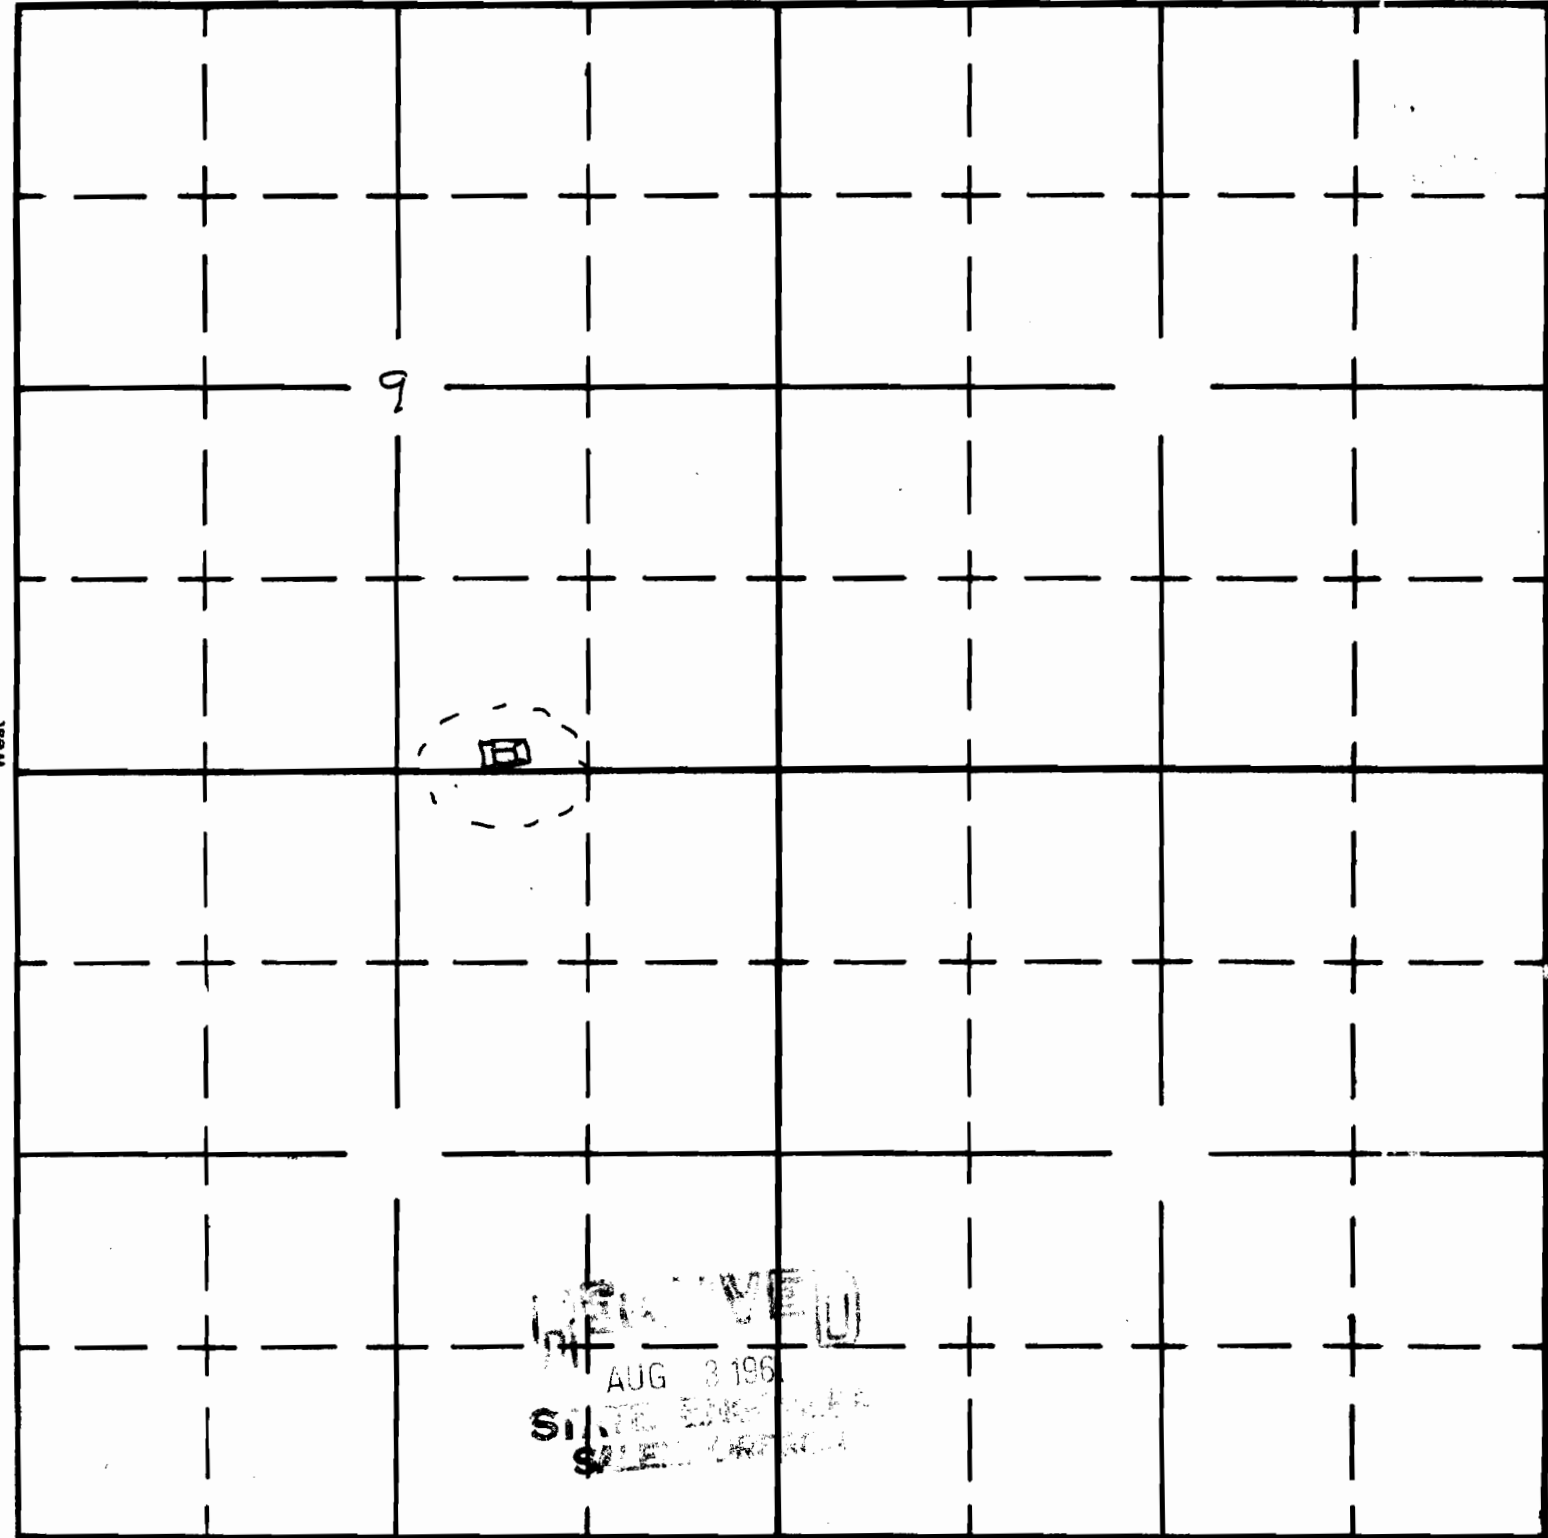

South

APPLICATION No. R-36077

PERMIT No. 8 6834