


House is located
at the Spring
Stock Water
at the House
in a trough
and below the
meadow in
the Spring branch.

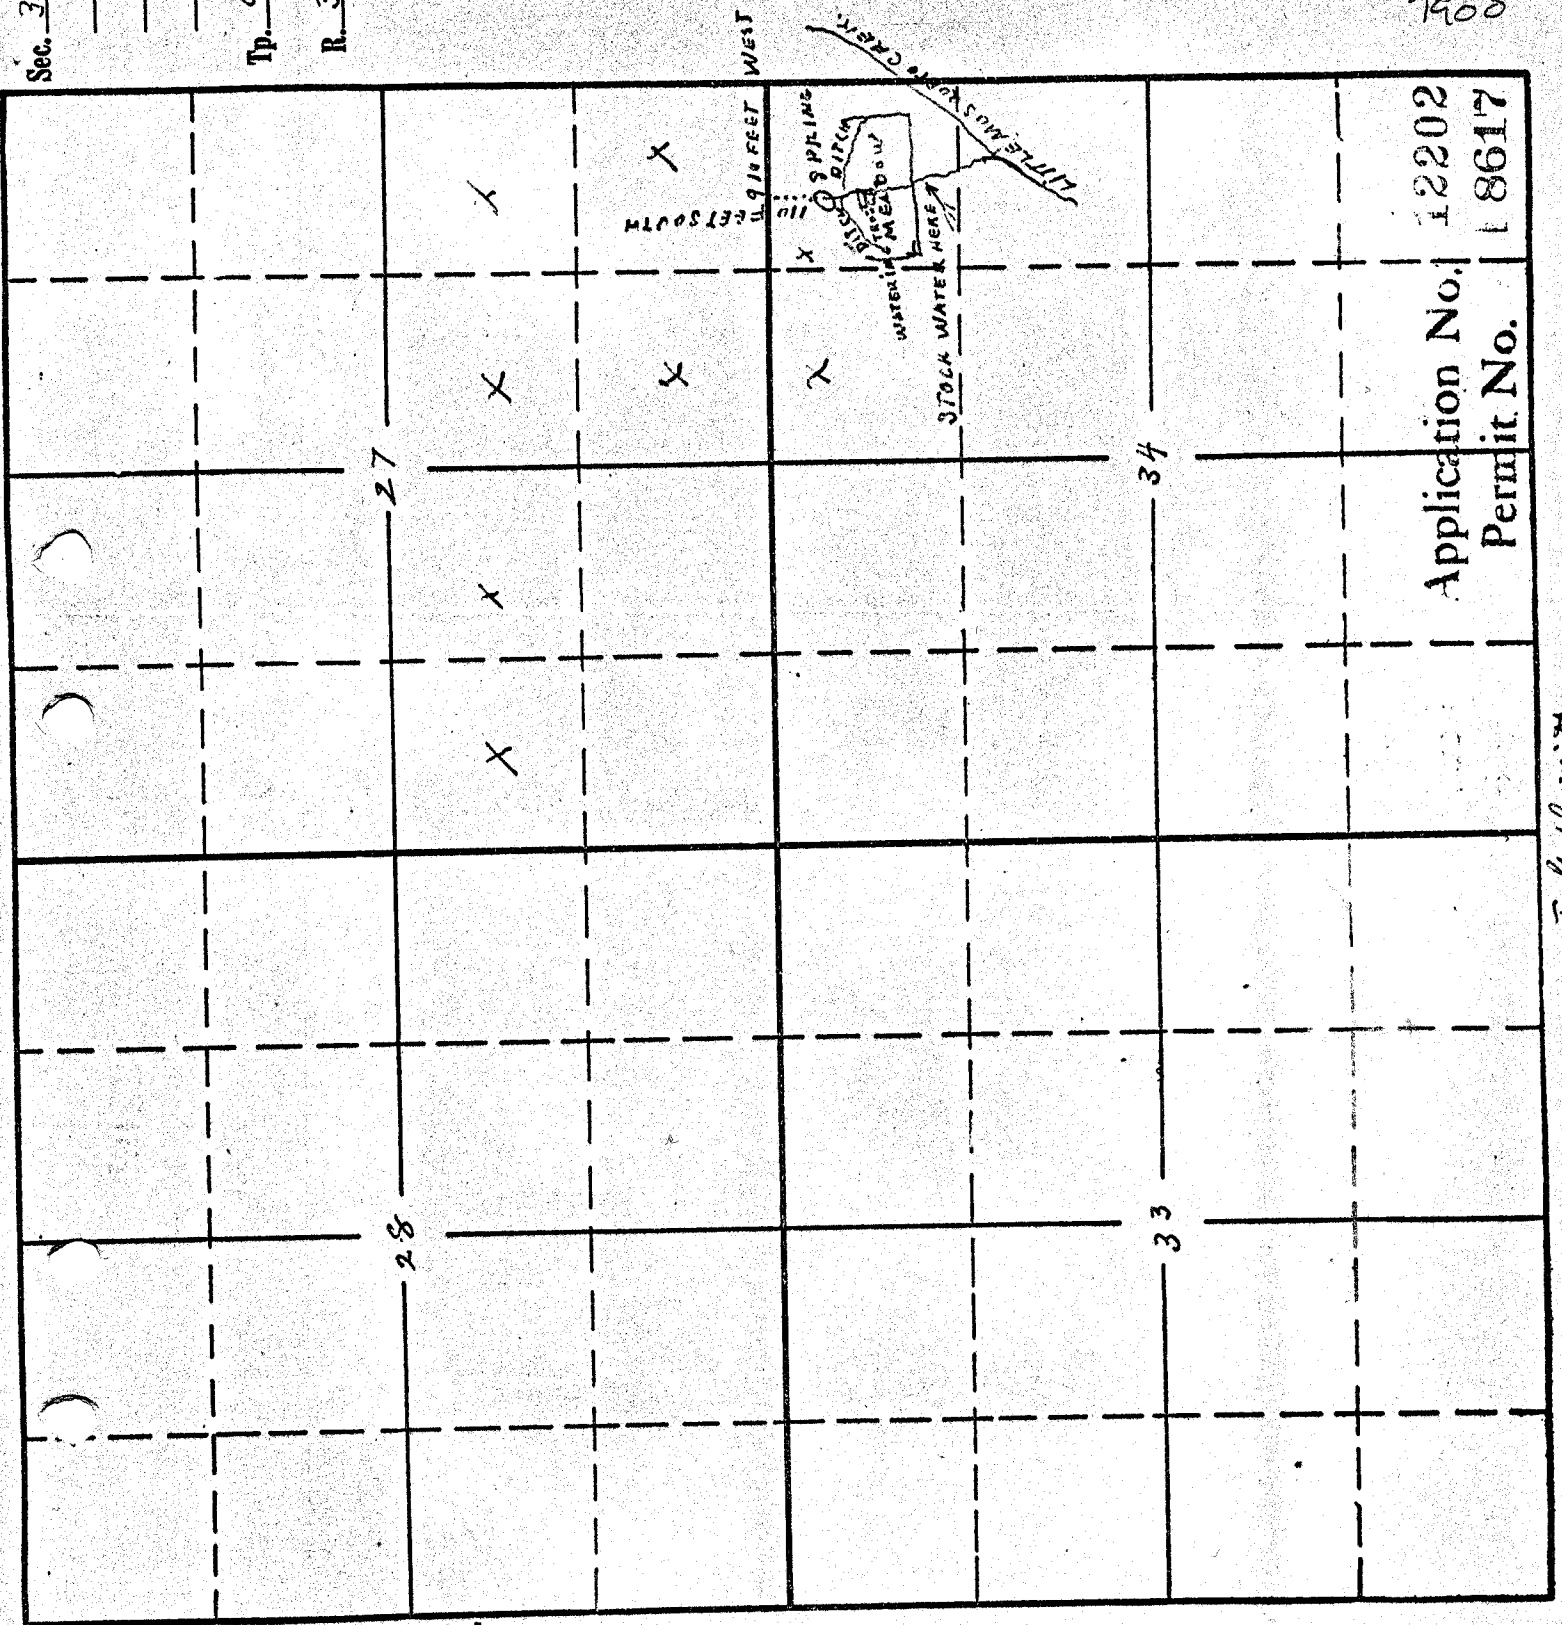

Application No.	12202
Permit No.	18617

T. G. Lewis.