


UNITED STATES
DEPARTMENT OF THE INTERIOR
BUREAU OF LAND MANAGEMENT

SECTION

Oregon State Water Filings

TOWNSHIP 22 S, RANGE 25 E, W. M.

North

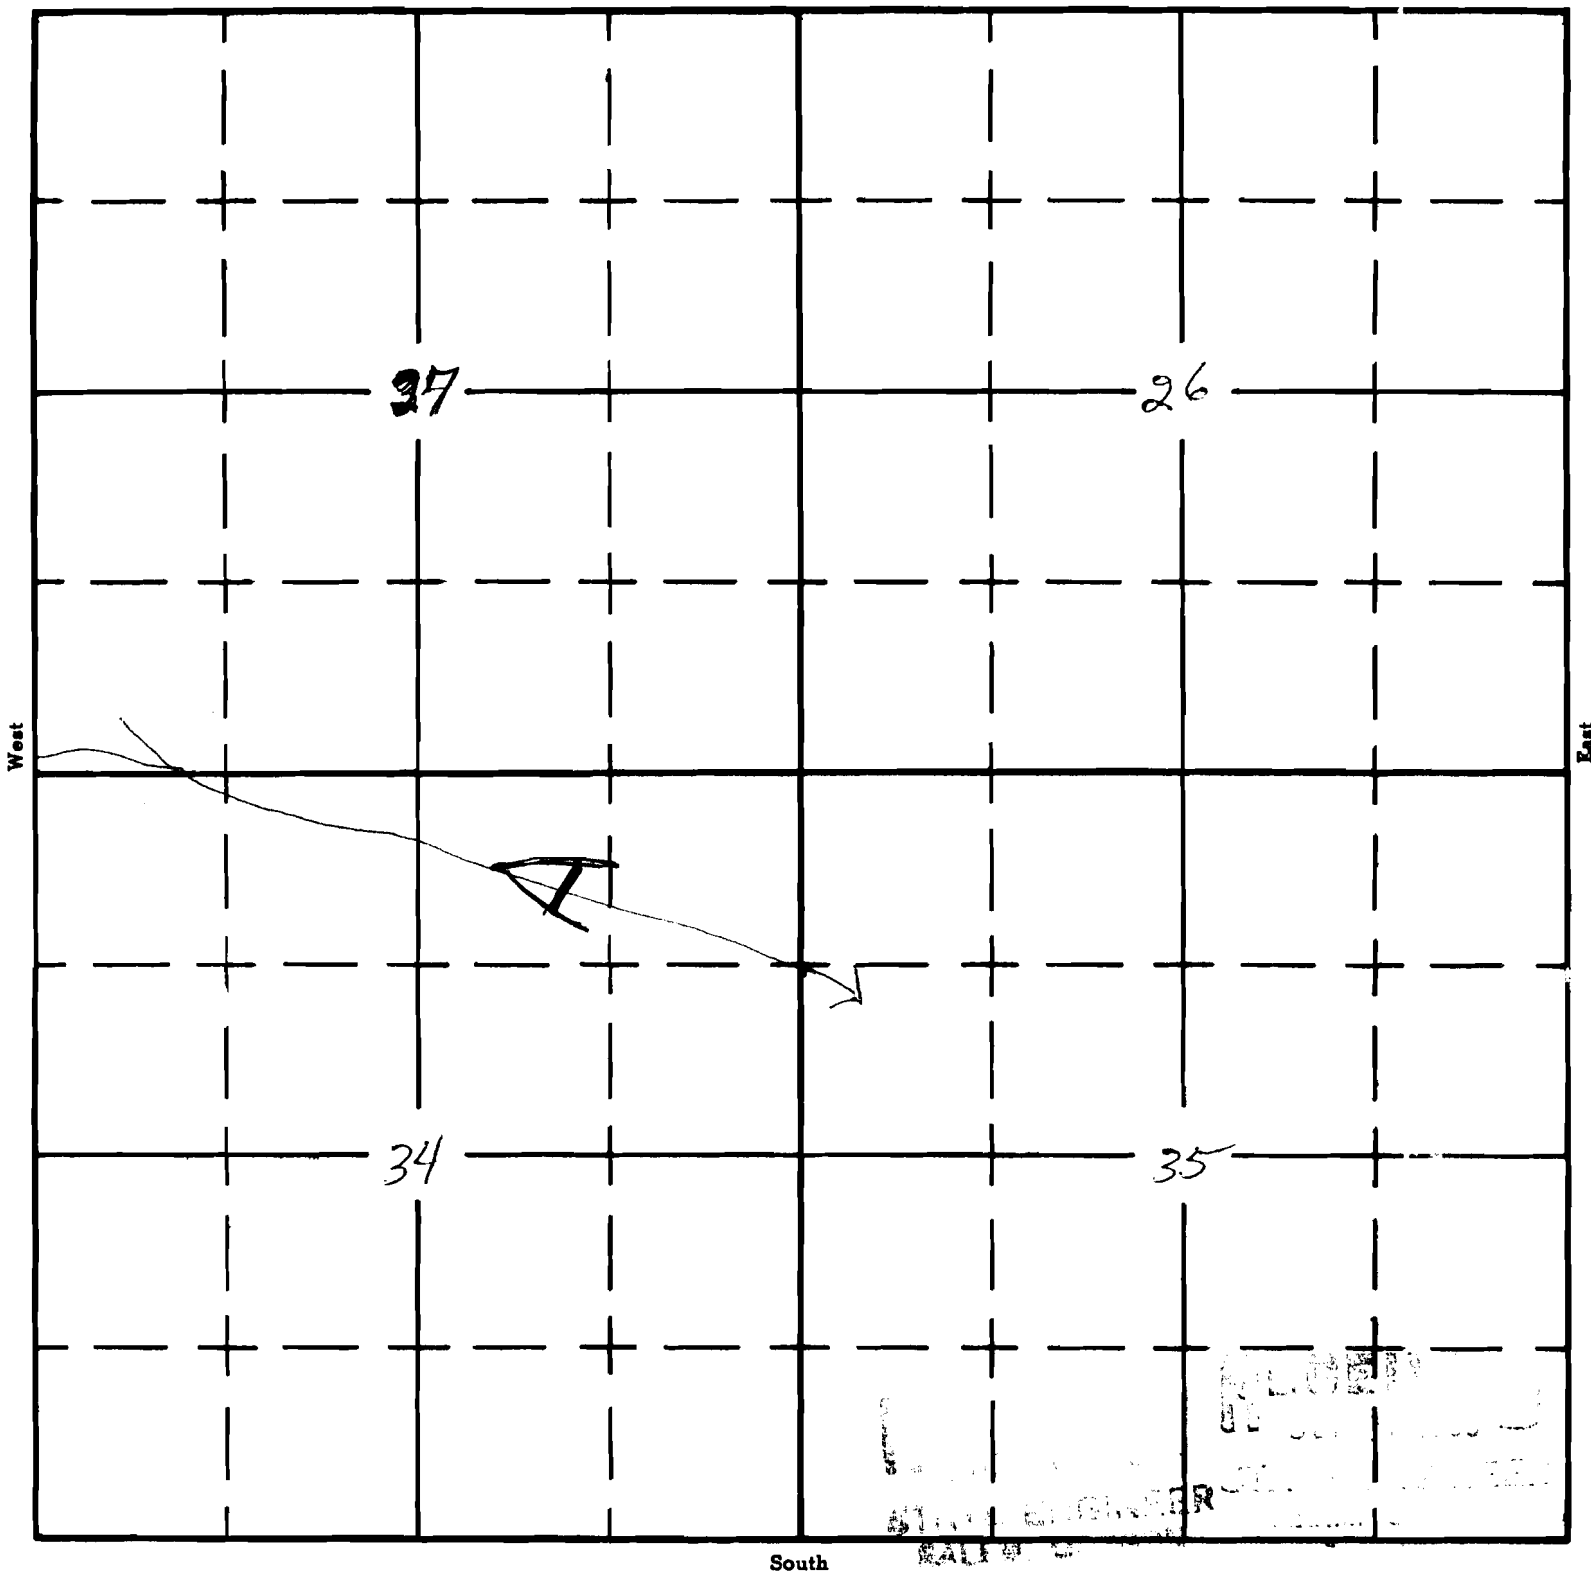

South

APPLICATION No. R-39027
PERMIT No. 7617