

Form AI-187
March 1961

UNITED STATES
DEPARTMENT OF THE INTERIOR
BUREAU OF LAND MANAGEMENT


SECTION

21

Oregon State Water Filings

TOWNSHIP 21S, RANGE 29E, W. M.

North

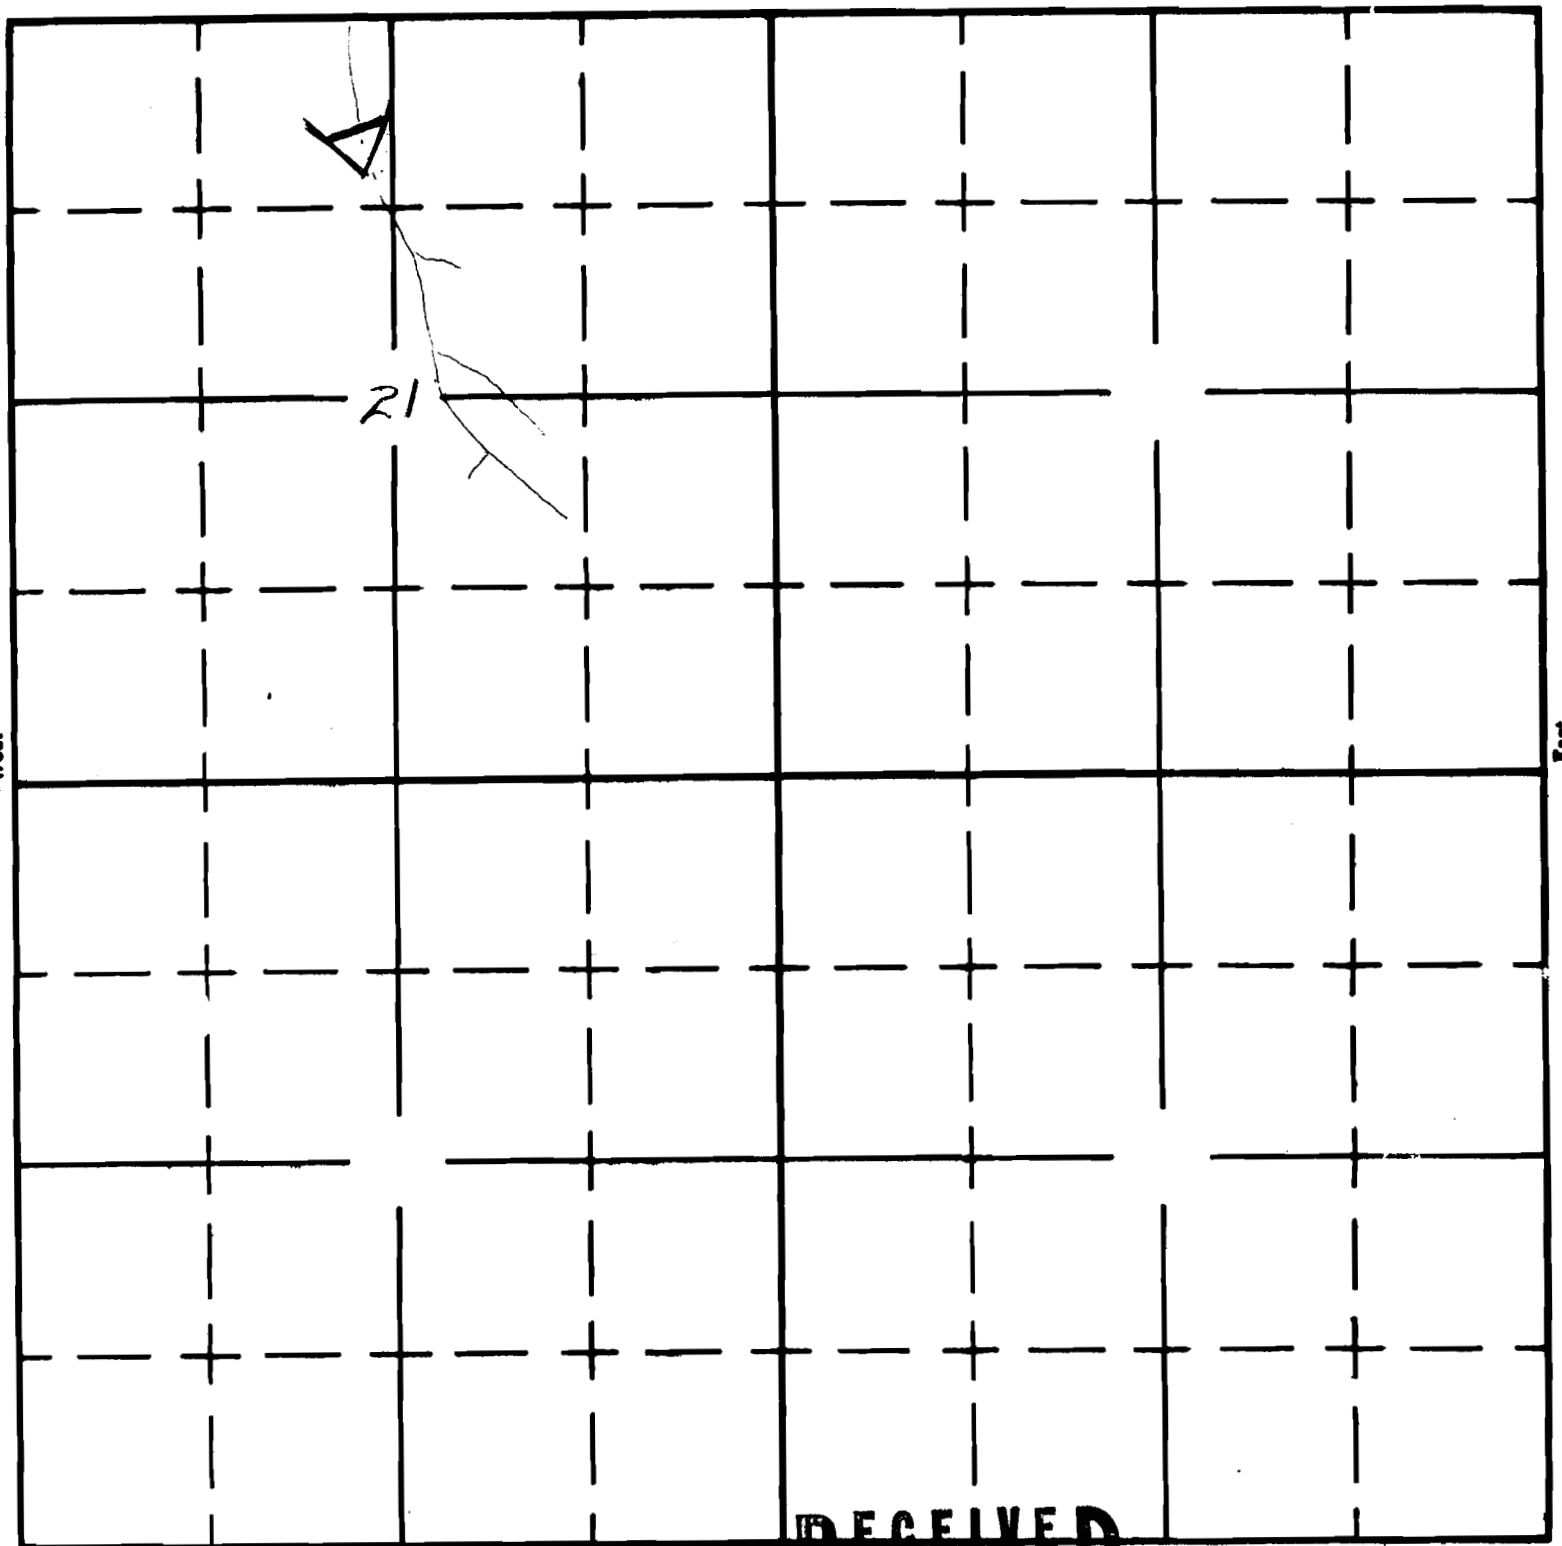

South

RECEIVED

FEB 16 1965

STATE ENGINEER
SALEM, OREGON

APPLICATION No. R-40941
PERMIT No. R 7625