

UNITED STATES
DEPARTMENT OF THE INTERIOR
BUREAU OF LAND MANAGEMENT

SECTION


SE 1/4 NE 1/4

Oregon State Water Filings

11

TOWNSHIP 20 S, RANGE 35 E, W. M.

North

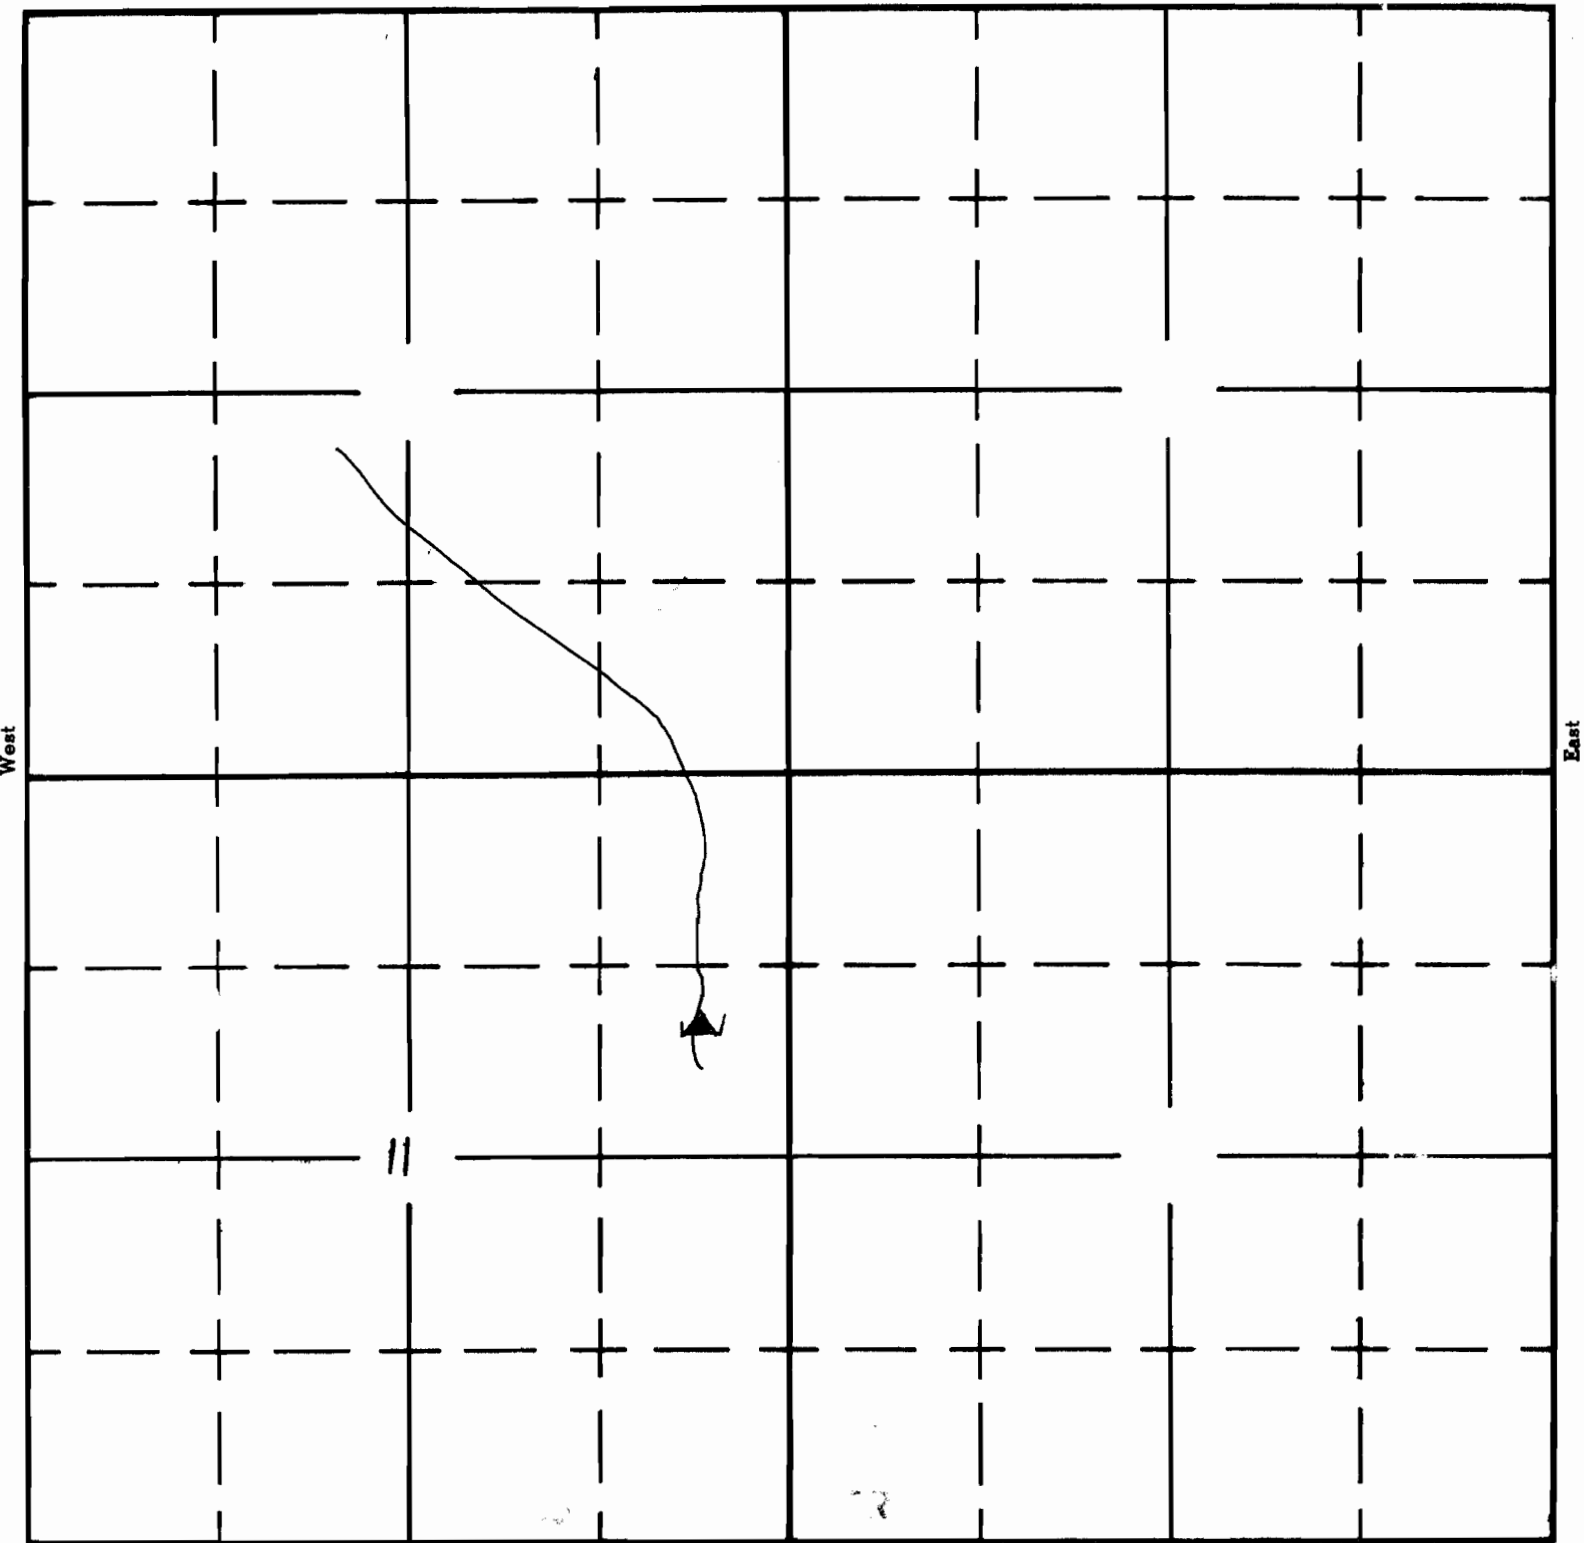

South

APPLICATION No. R-35428
PERMIT No. 7850