


UNITED STATES
DEPARTMENT OF THE INTERIOR
BUREAU OF LAND MANAGEMENT

SECTION NE 1/4 SW 1/4 **Oregon State Water Filings**

2 TOWNSHIP 20S, RANGE 35E, W. M.

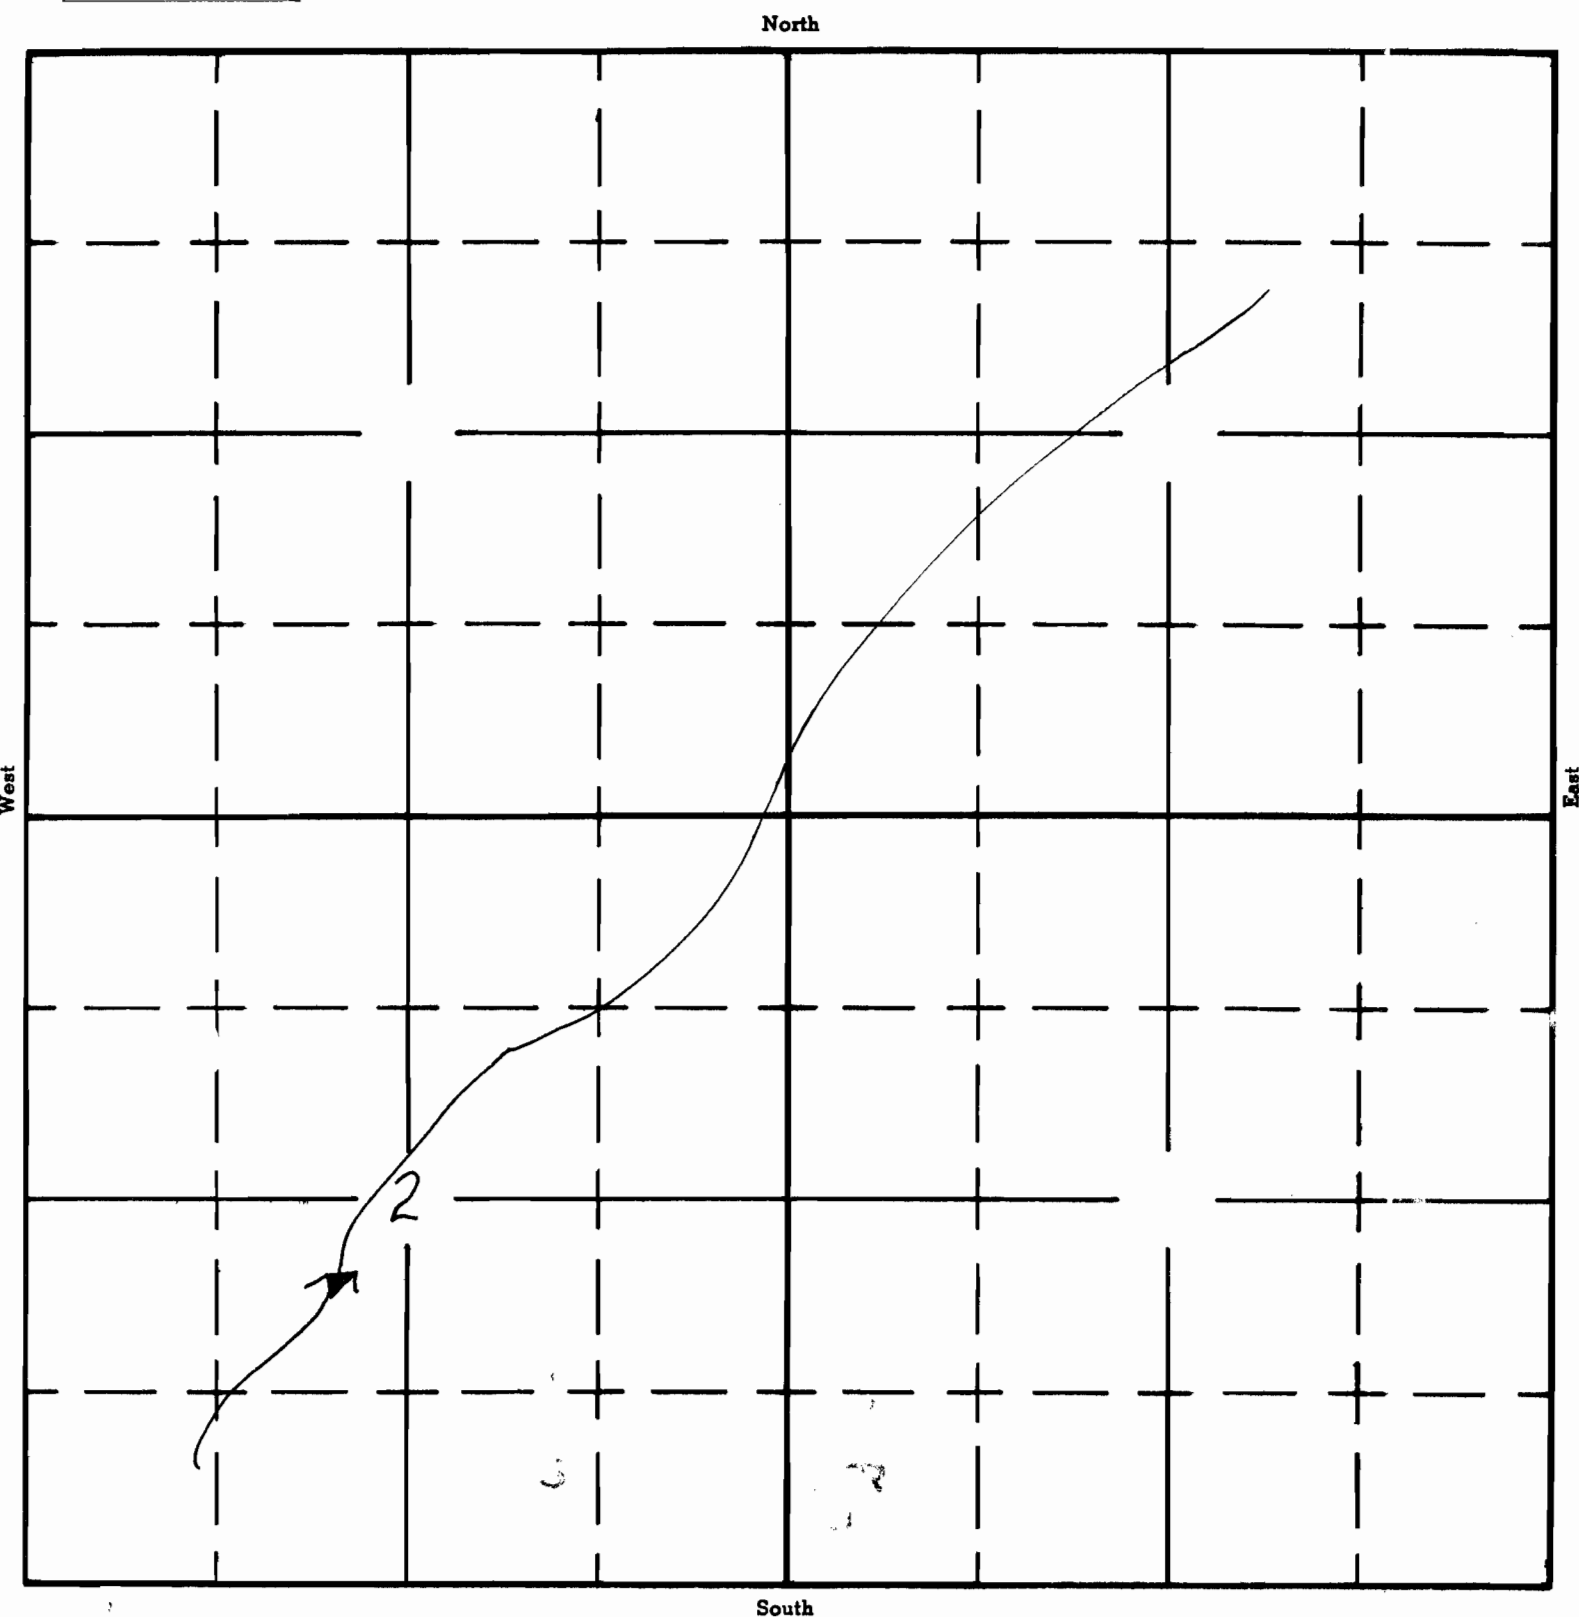

APPLICATION No. R-35429
PERMIT No. R 7851