

UNITED STATES
DEPARTMENT OF THE INTERIOR
BUREAU OF LAND MANAGEMENT

SECTION


NW 1/4 SW 1/4

Oregon State Water Filings

26

TOWNSHIP 19S, RANGE 36E, W. M.

North

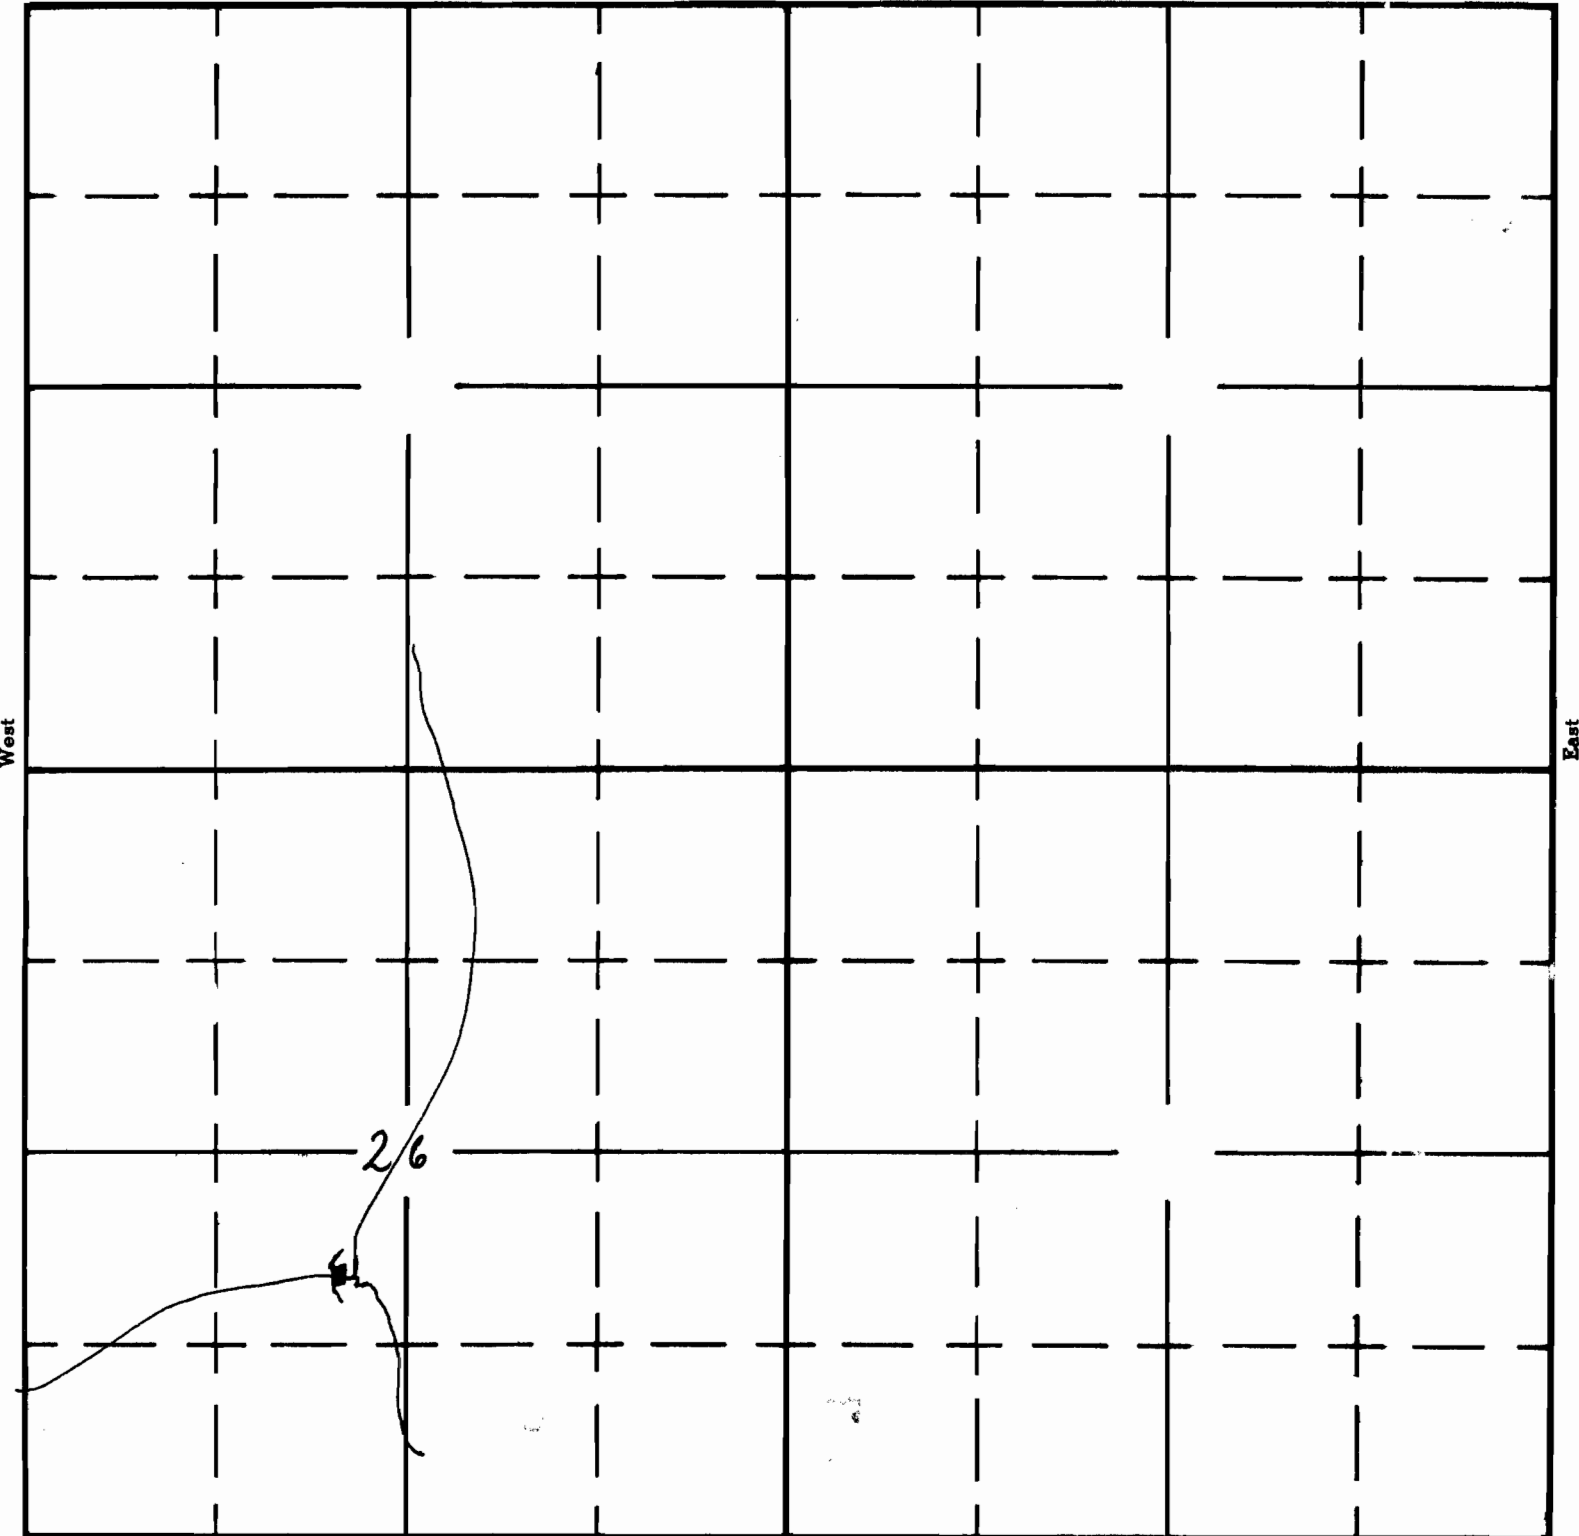

South

APPLICATION No. R-35432

PERMIT No. R 7854