


UNITED STATES  
DEPARTMENT OF THE INTERIOR  
BUREAU OF LAND MANAGEMENT

SECTION  
NW 1/4 SE 1/4  
21


TOWNSHIP 18S, RANGE 35E, W. M.

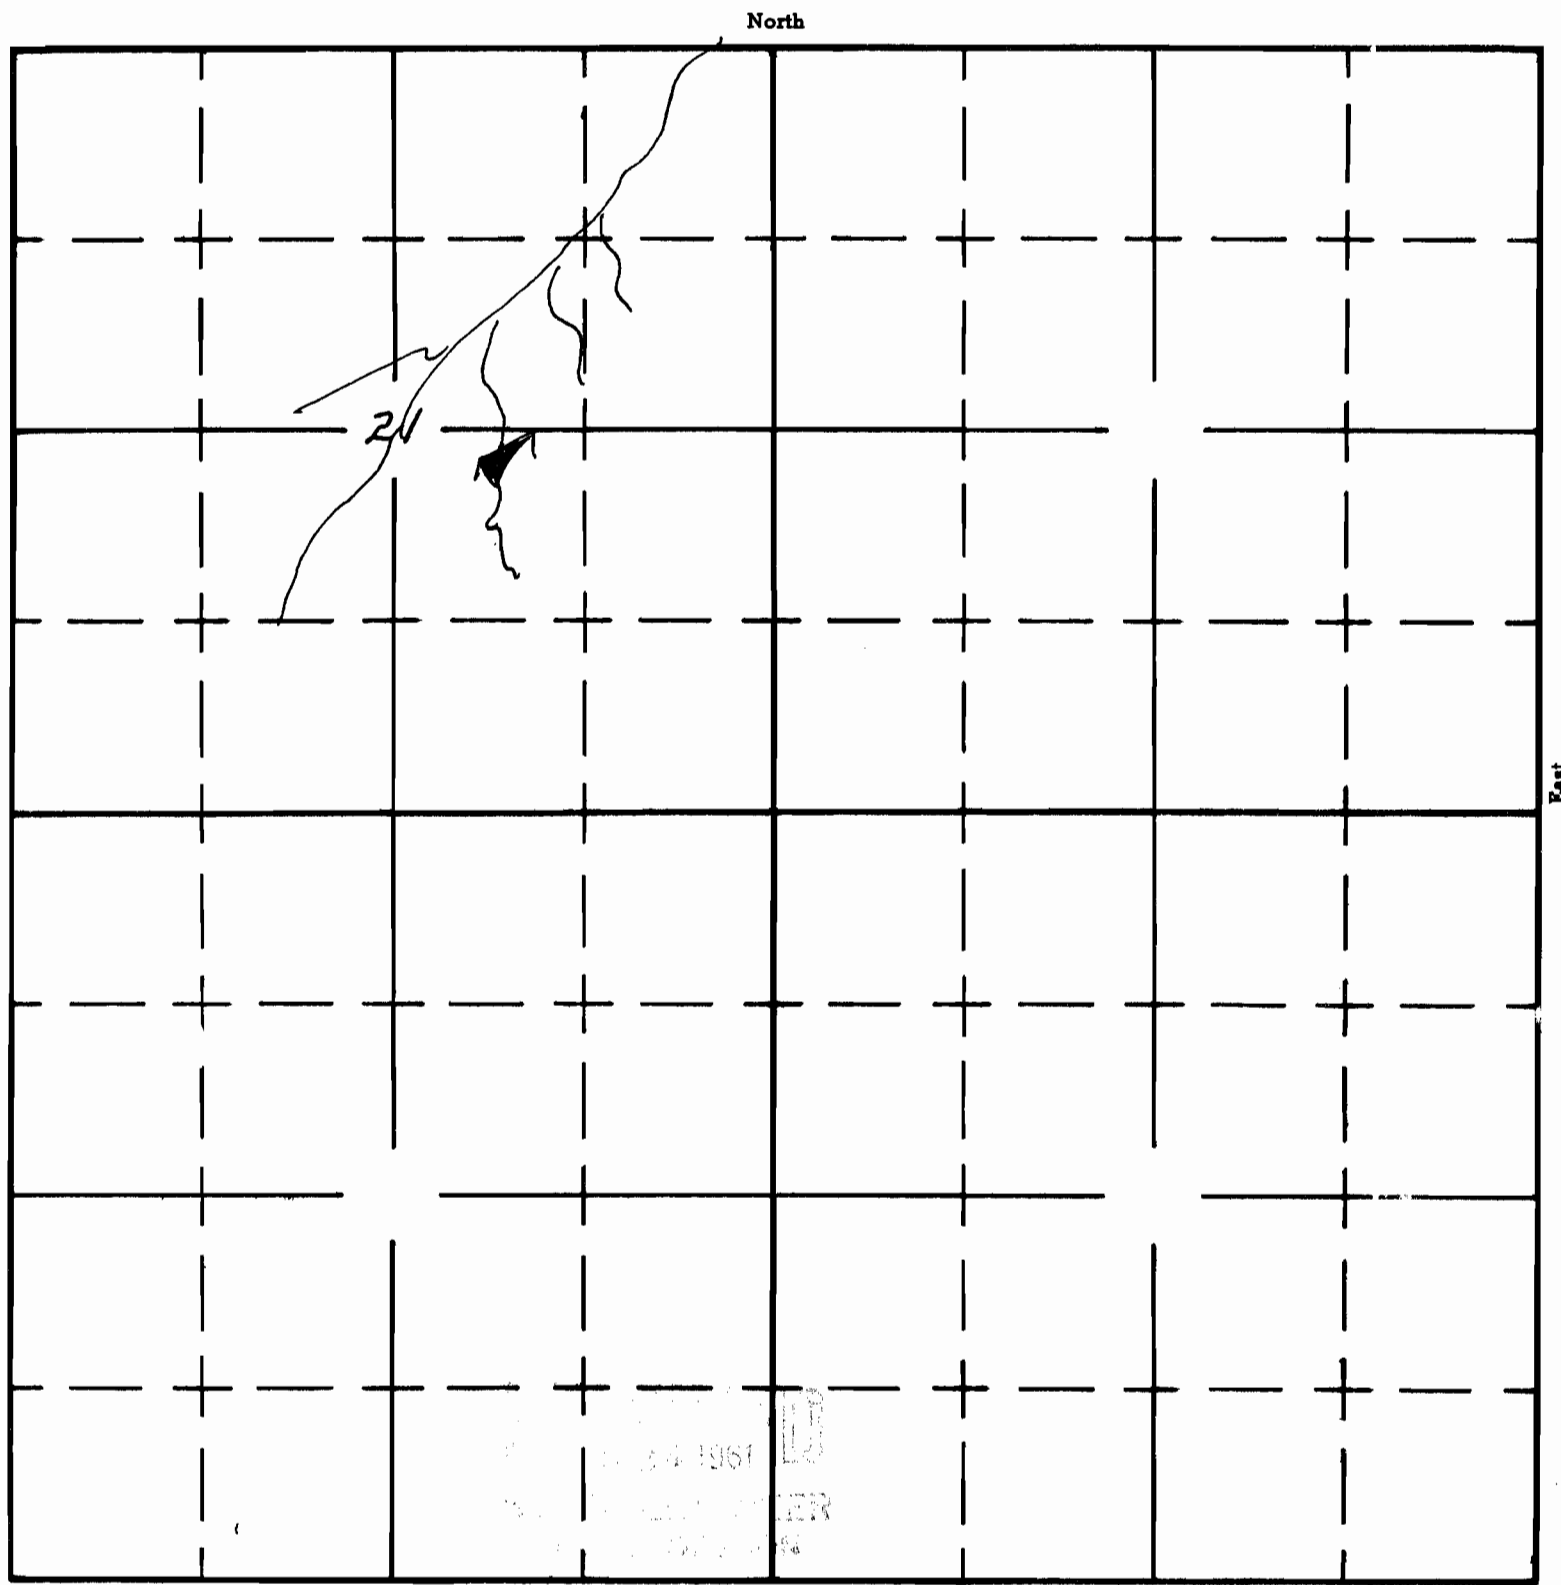

RECEIVED  
MARCH 24 1961  
BUREAU OF LAND MANAGEMENT  
WASHINGTON, D. C.