


Form AI-187
March 1961

UNITED STATES
DEPARTMENT OF THE INTERIOR
BUREAU OF LAND MANAGEMENT

SECTION
NE 1/4 NE 1/4
SEC. 36

Oregon State Water Filings

TOWNSHIP 20S, RANGE 36E, W. M.

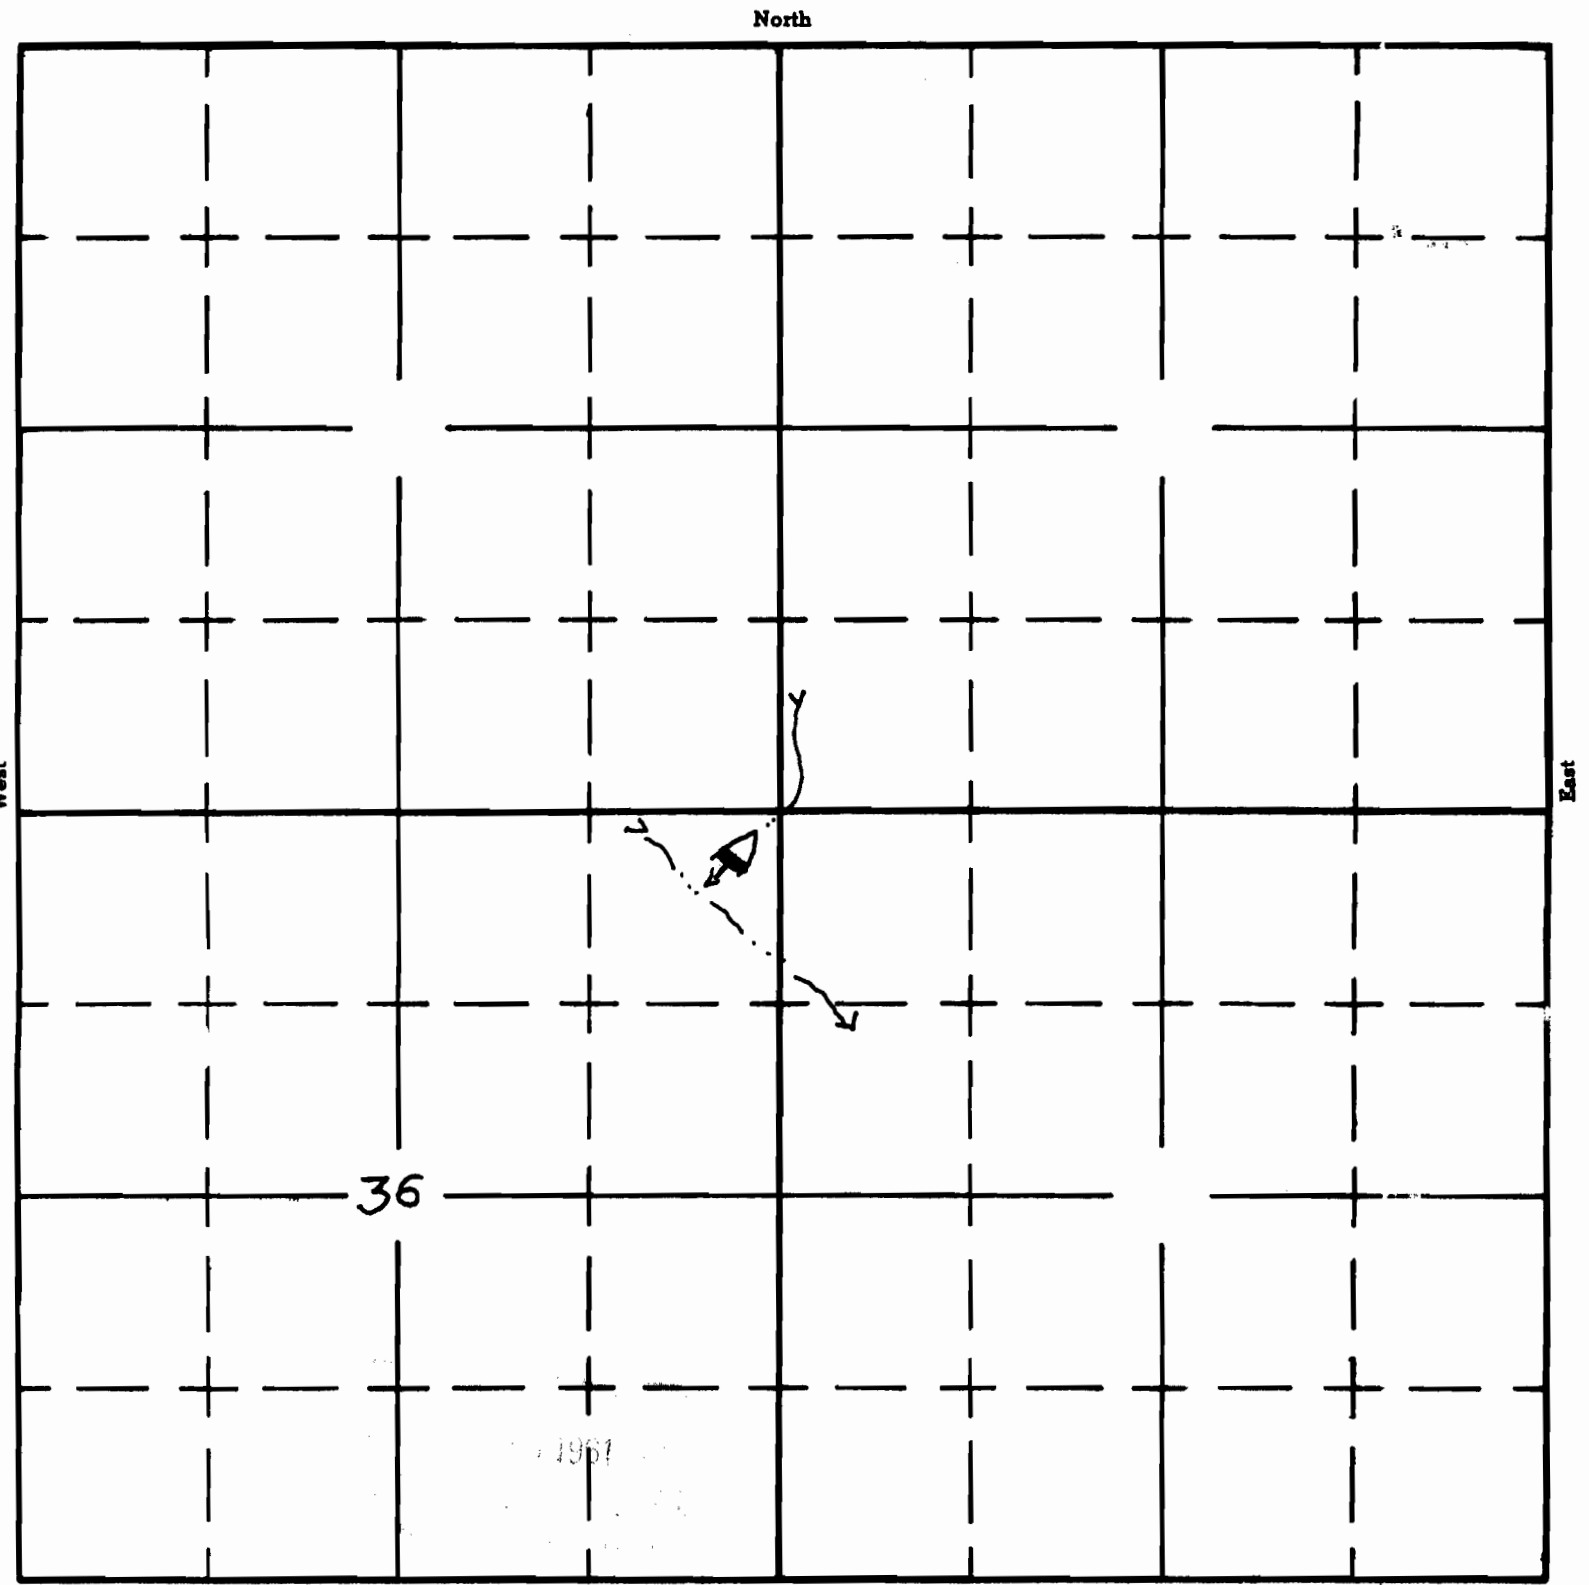

UNNAMED
Chimney Creek

APPLICATION No. R35502
PERMIT No. R 7868