


UNITED STATES
DEPARTMENT OF THE INTERIOR
BUREAU OF LAND MANAGEMENT

SECTION SE 1/4 SW 1/4 **Oregon State Water Filings**

15 TOWNSHIP 21 S, RANGE 34 E, W. M.

North

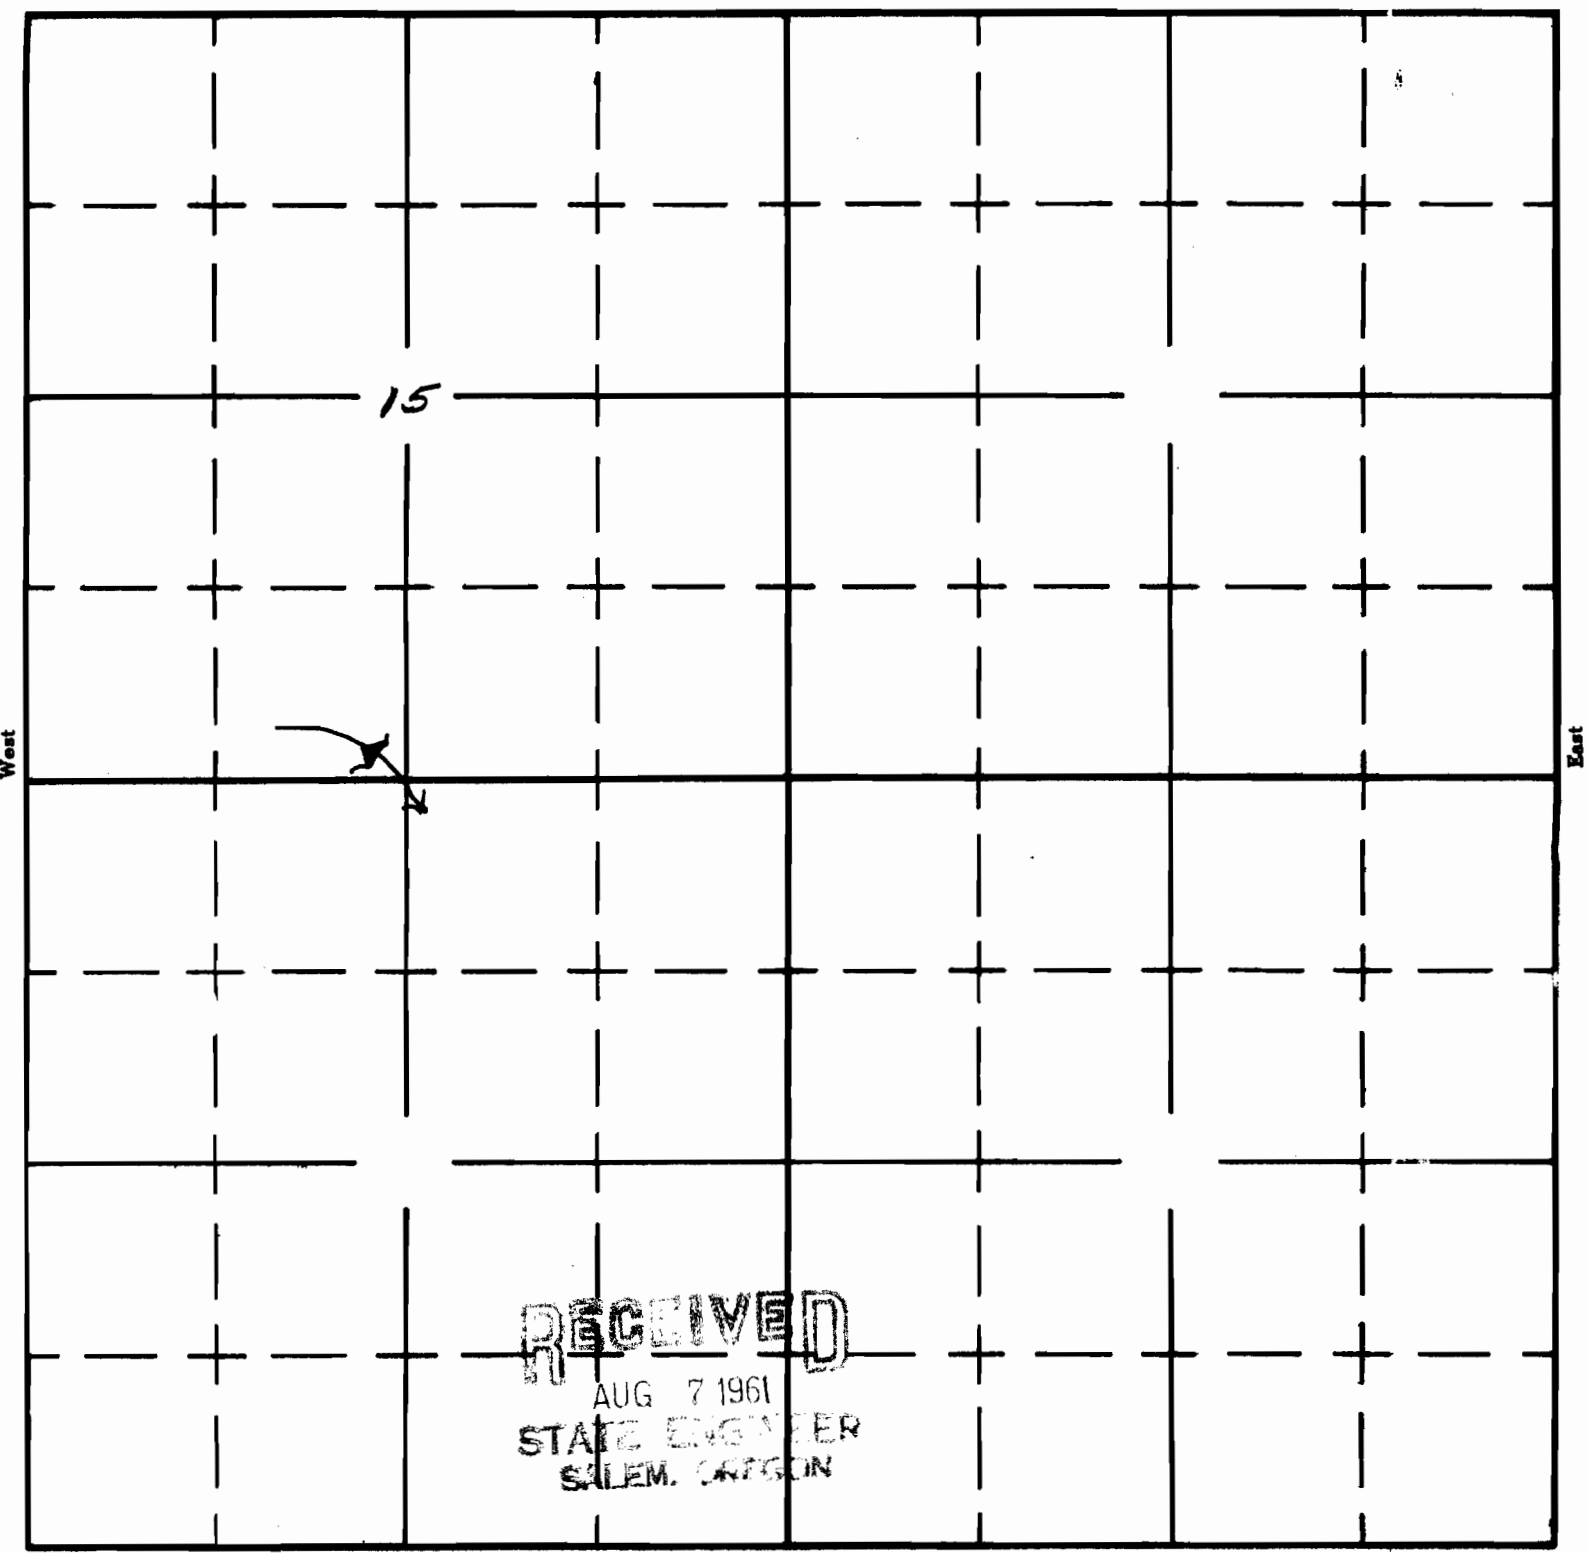

South

APPLICATION No. R-36108
PERMIT No. R 7869