

UNITED STATES
DEPARTMENT OF THE INTERIOR
BUREAU OF LAND MANAGEMENT

SECTION 3

Oregon State Water Filings


NE 1/4 NE 1/4

TOWNSHIP 11 S, RANGE 26 E, W. M.

4" = 1 Mile

North FAWN CR. RES. # 4

15-4991

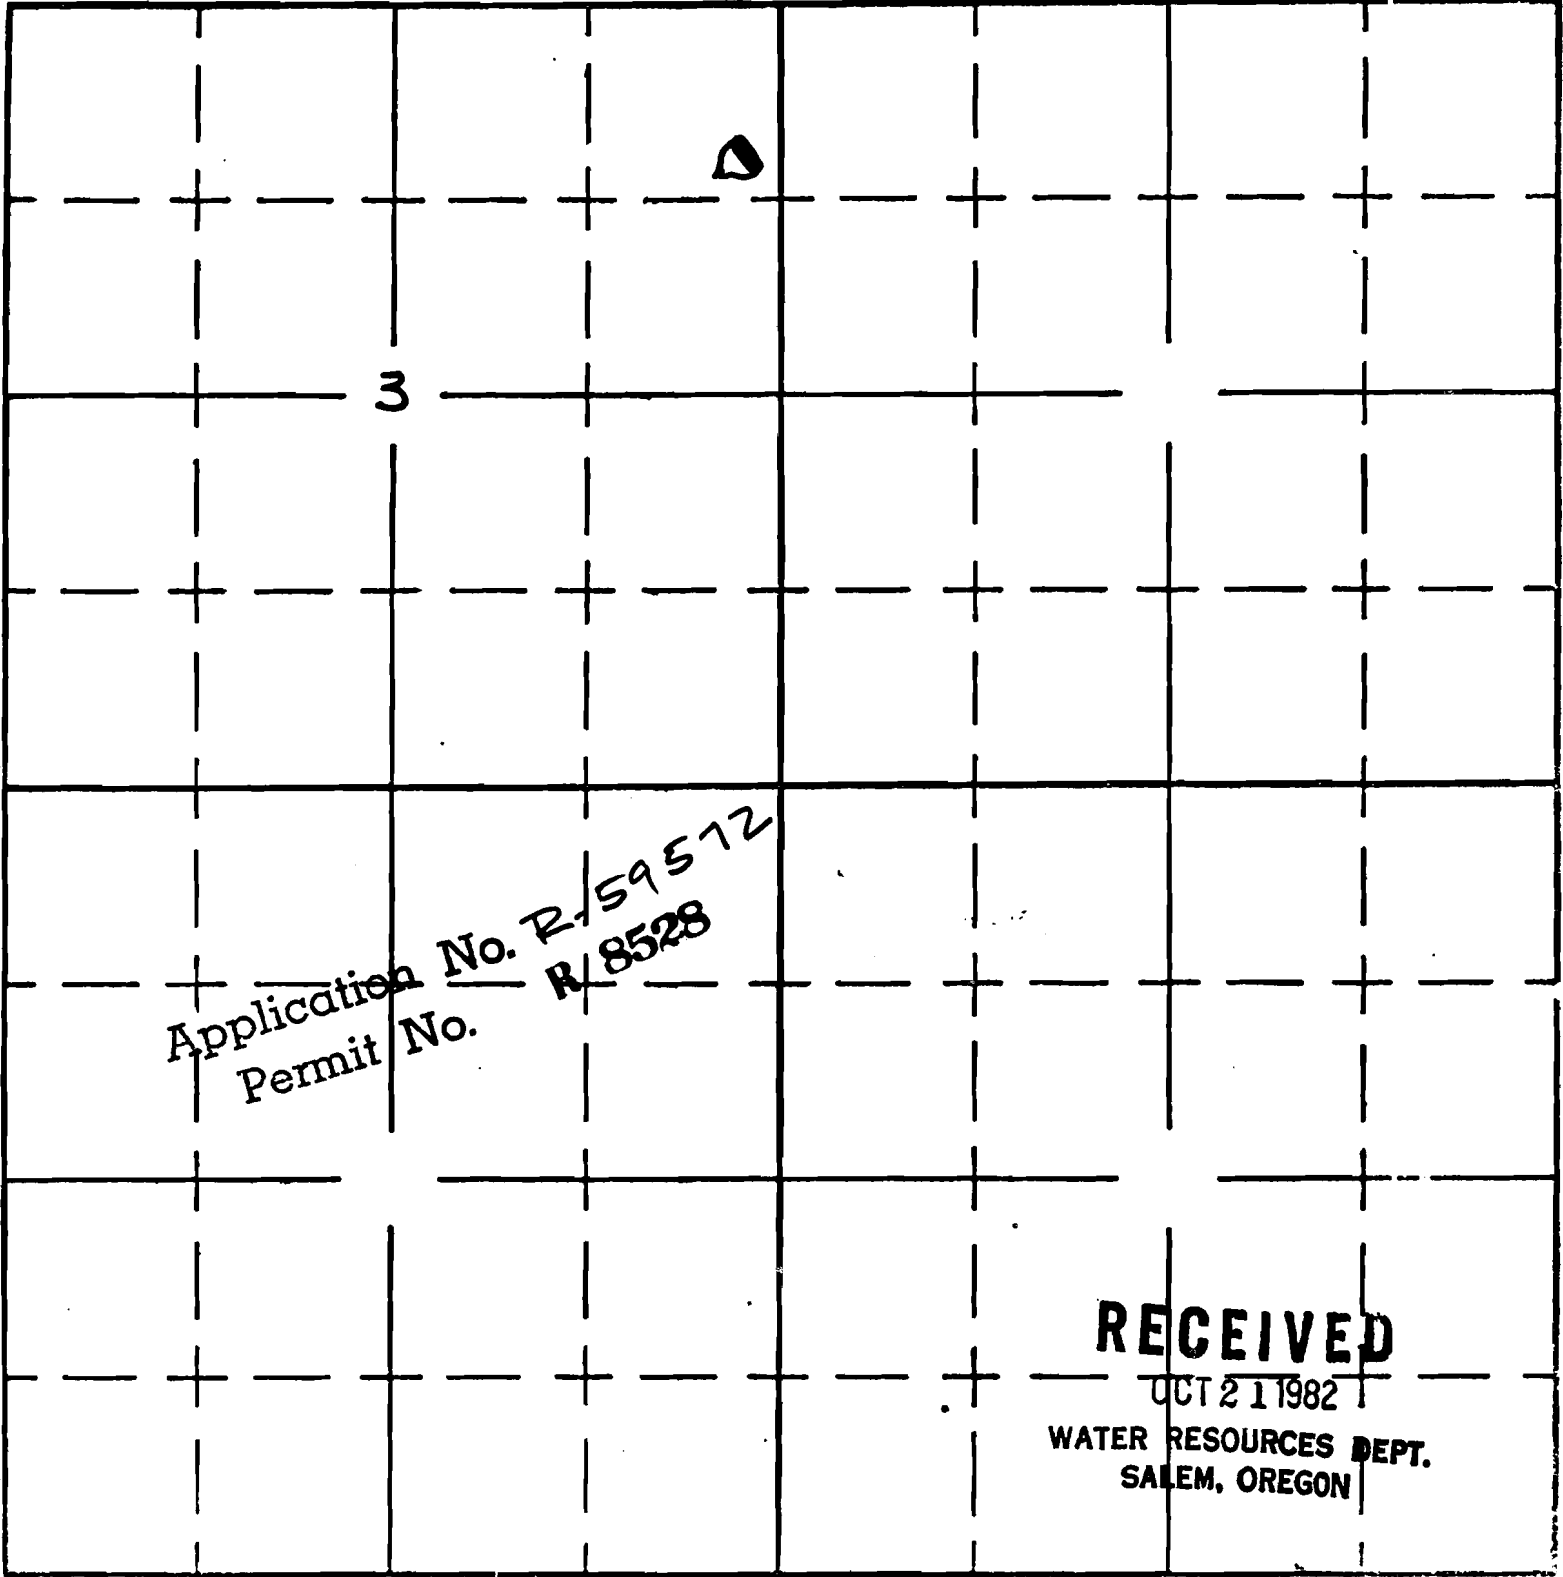

Application No. R-59572
Permit No. R-8528

RECEIVED
OCT 21 1982
WATER RESOURCES DEPT.
SALEM, OREGON