

SECTION


15

SW SW

11-1331

TOWNSHIP 40S, RANGE 37E, W. M.

HALF PINT
CR. CHECK

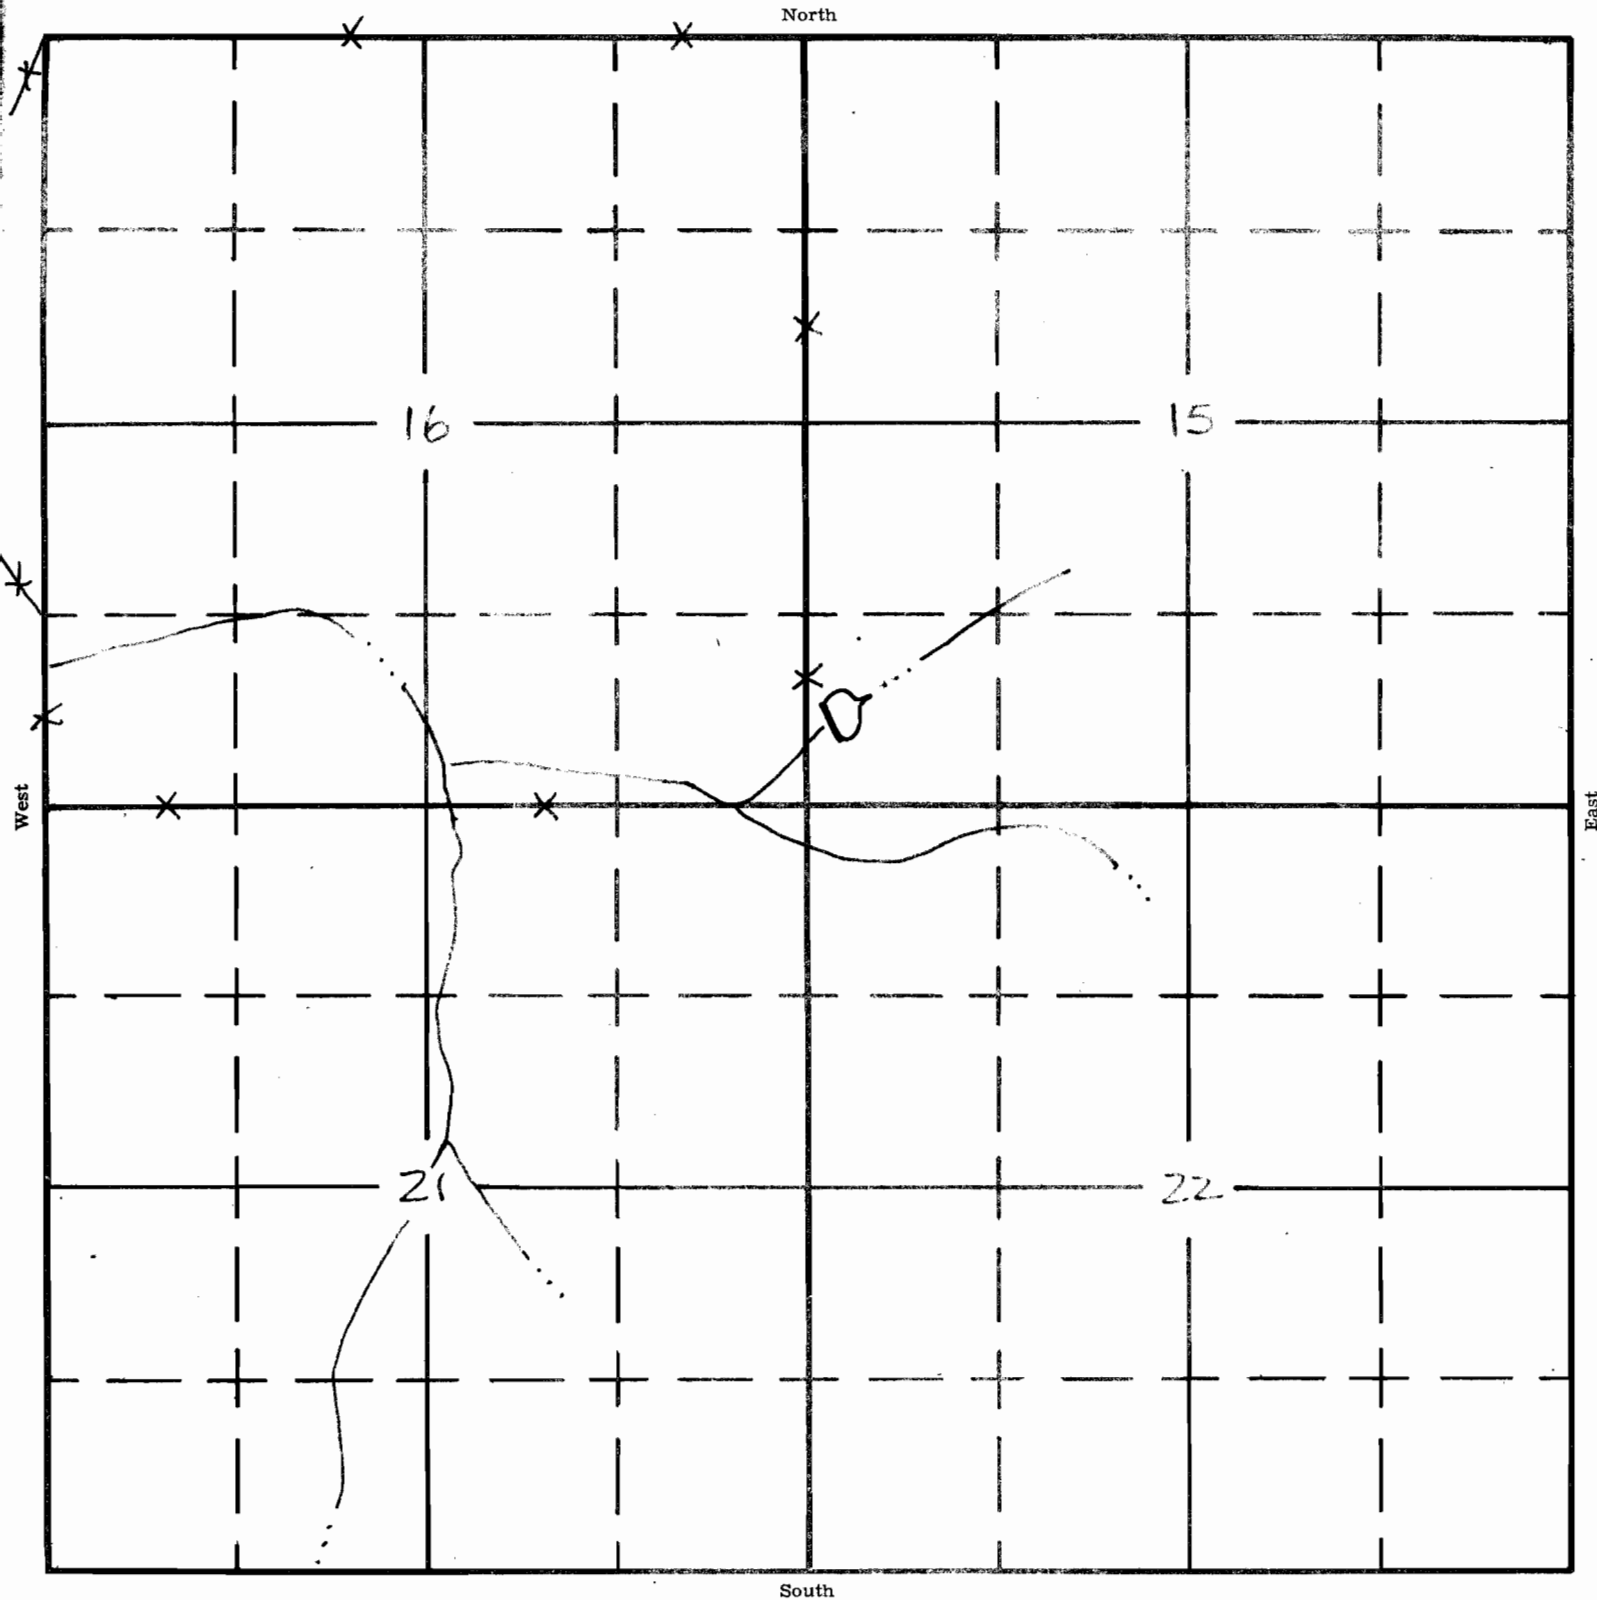

Application No.
Permit No.

R66423
R10202

5. 1993