

DEPARTMENT OF THE INTERIOR
BUREAU OF LAND MANAGEMENT

SECTION 2


Oregon State Water Filings

NE 1/4 SW 1/4

TOWNSHIP 24 S, RANGE 34 E, W. M.

North

5201 Ole Snag Spring Hole

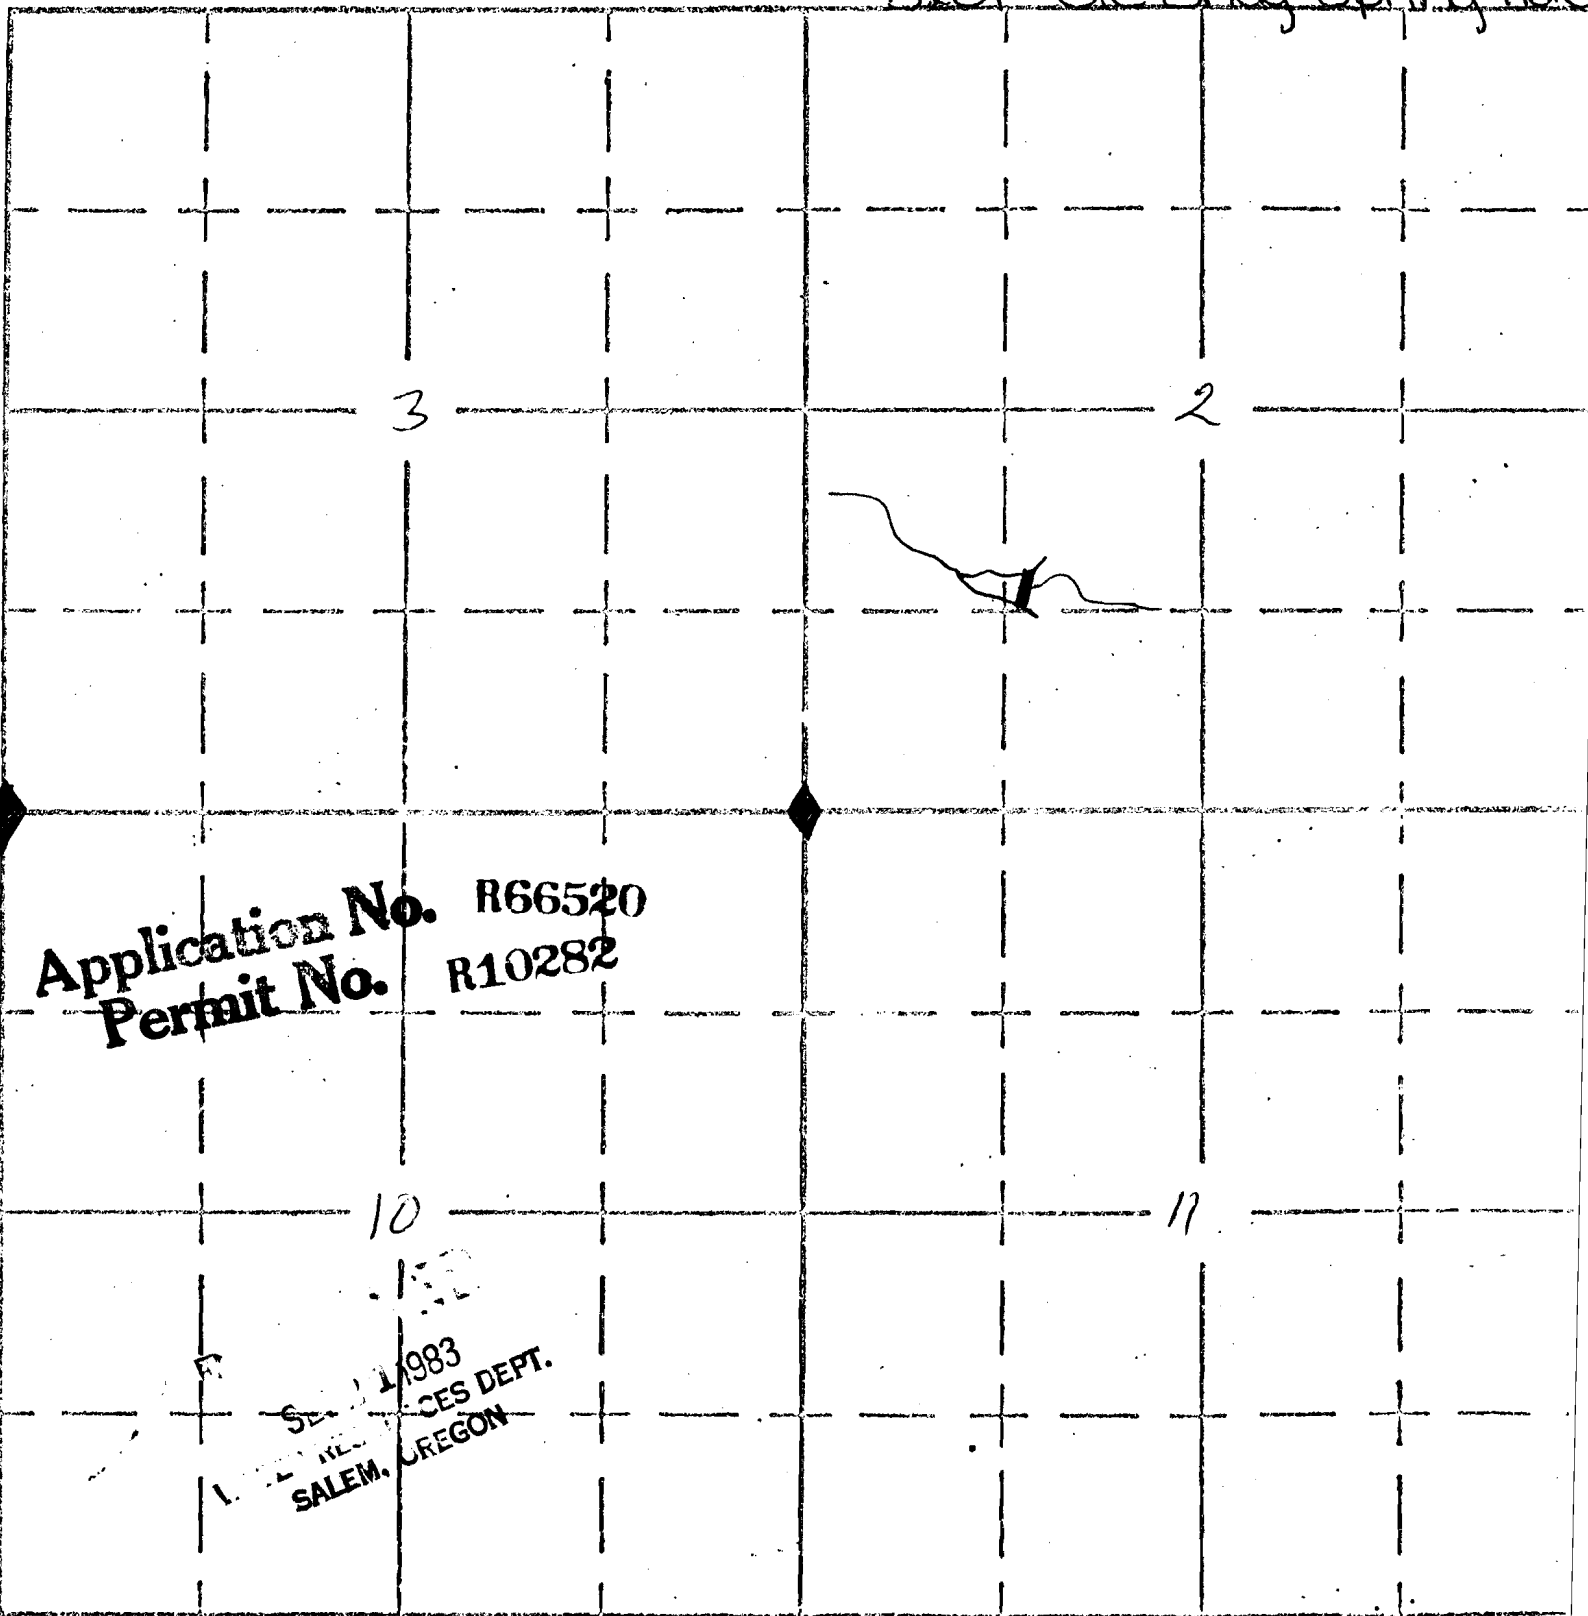

South

APPLICATION No: